No.	Grantor	Grantee	Transaction	Date	Recorded	Acreage	Remarks
1	A.V.Hawkins et al	N.C.& St.L.Ry.	Deed	June 13,1890	DB U-430-Sep.20,1890	25	
2	W.A.Thurman	N.C.& St.L.Ry.	Deed	June 13,1890	DB U-431-Aug.20,1891	24	
3	John Price	N.C.& St.L.Ry.	Deed	April 7,1891	DB U-433-June 2,1891	23	Condemned and Compensated
4	Eliza Lee et al	N.C.& St.L.Ry.	Deed	June 17,1890	DB U-531-Oct.13,1890	22	
5	Terry Lee et al	N.C.& St.L.Ry.	Deed	Aug 1,1890	DB U-432-Aug.26,1890	21	
6	Terry Lee et al	N.C.& St.L.Ry.	Deed	Nov.11,1890	DB T-71-Dec.9,1898	20	Section House Lot
7	Terry Lee et al	N.C.& St.L.Ry.	Deed	Nov.11,1890	DB T-69-Dec.9,1890	19	Depot Lot Lee

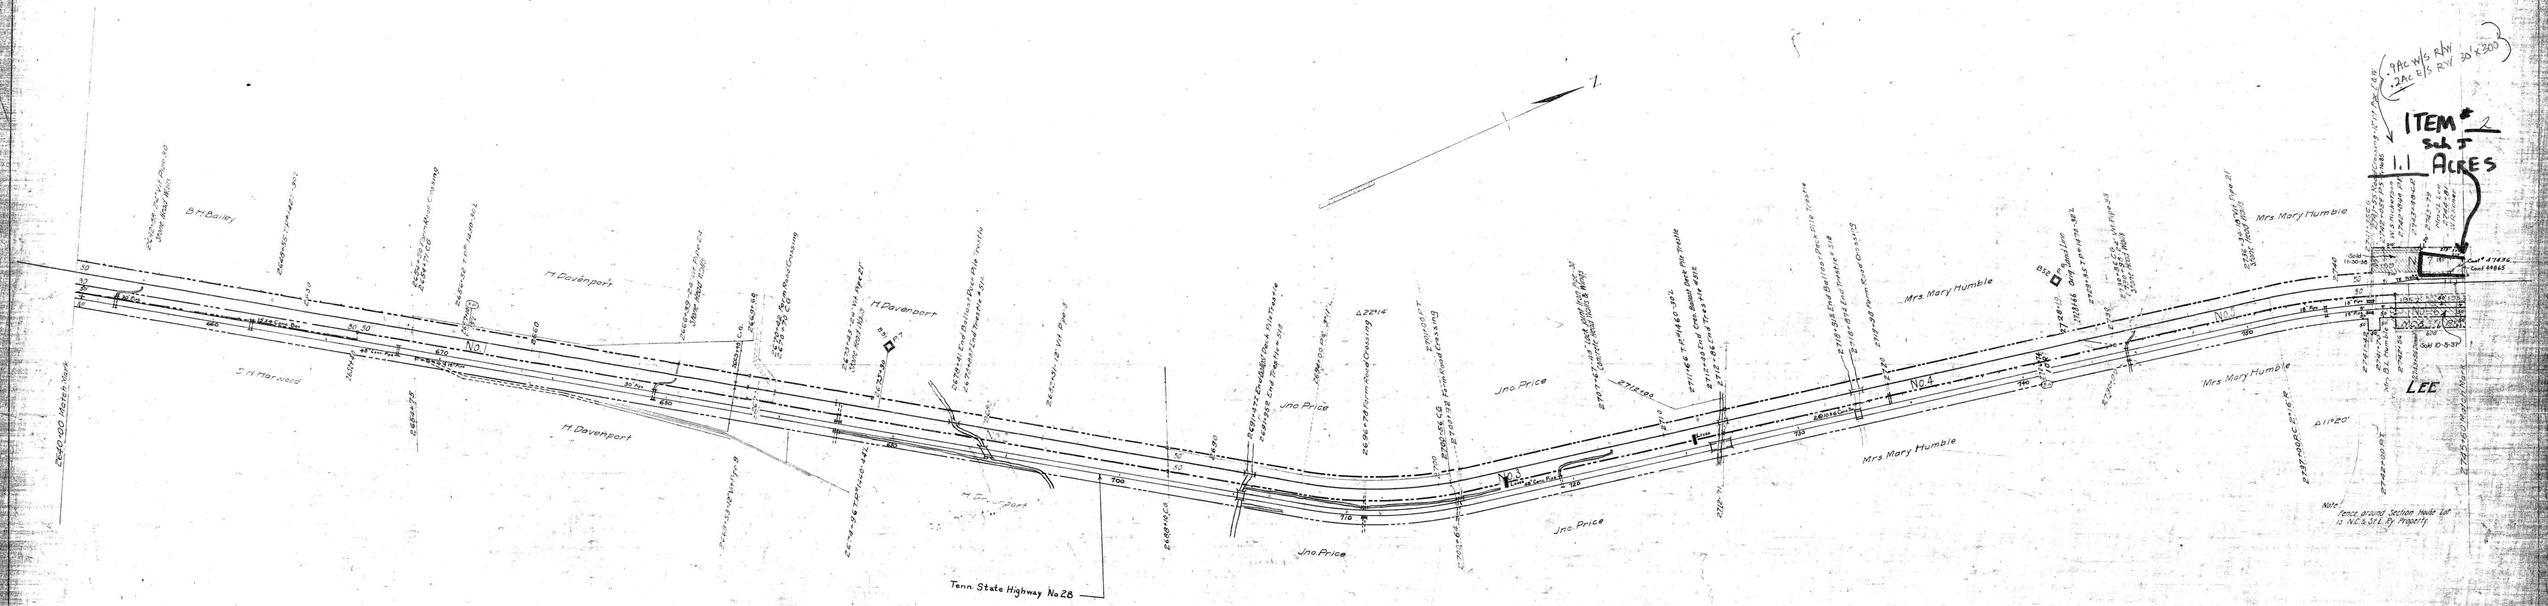

~~Cont 44150 12-14-57 - Johnny Boyd - Loading Ramp Sta 2745+00 - Canc. 4-25-61~~
~~" 47434 6-29-61 - Hugh Allegan - 10'x28' Ramp in Rd of Lots 28 & 29 Sta 2745+45~~

RIGHT-OF-WAY AND TRACK MAP

NASHVILLE, CHATTANOOGA AND ST. LOUIS RY.

SEQUATCHIE VALLEY BRANCH

STATION 2640+00 TO STATION 2745+50

SCALE, 1 IN. = 200 FT. JUNE 30, 1916

OFFICE OF CHIEF ENGINEER
NASHVILLE, TENN.

Sheet No 28 of 31 sheets of Sequatchie Valley Branch from Survey Station 2640+00 to survey Station 2745+50

Division Engineer

M.P. 503 to 523

04-005

708-D-28

BLEDSOE CO. TENN.

LEE