A.F.E. No.	Date	Comp.	Description of Change
3572	2-17-29		Const. of additional room to Sect. foreman house.
4508	10-6-29		Const. of paving "Rock alley" at N.E. of Depot.
3666	2-17-29		Const. of additional room to Sect. foreman house
21132	10-14-31		Sold it per 2A7
1559	1-30-31		Instl. of ship & meter car no. 21-16 moved from Byington
32996	3-29-44		Const. spur 1-4. 20000' lg. beg. at 15896+60
32996	7-13-45		Cor. to 2464
33470	11-13-45		Spring Switch Inst. P.S. Trk. #24 at Sta. 15880+12.
41785	2-23-52		Fence from Sta. 15895+10 to Sta. 15910+00
41838	5-5-52		" " Sta. 15872+15 to Sta. 15895+10
46053	5-31-55		Portion trk. #24 & #26 retired.
43177	2-11-53		Const. trk. #24 & P.S. Jt. 30 & 32+135
43168	11-13-52		Rel. Sec. Lub. House at K.S. Sta. 15816+10
44464	12-15-53		Rel. Sec. Lub. House Total R.S. 15912+16
52165	8-25-59		Rel. Gas. Box at Sta. 15716+37
52515	2-23-63		Rel. Sec. Kit. & Toilet in Par. 6
54032	11-15-63		Rel. Sec. Kit.
54296	7-23-64		Rel. Sec. Toil. Fence @ 21+31
57824	6-18-66		Rel. Stand at Nestor Tarr.
57824	8-18-66		Rel. 15'x28' mtr. garage
59886	10-12-66		Rel. 12'x16' Trans. meter out Sta. 21+40

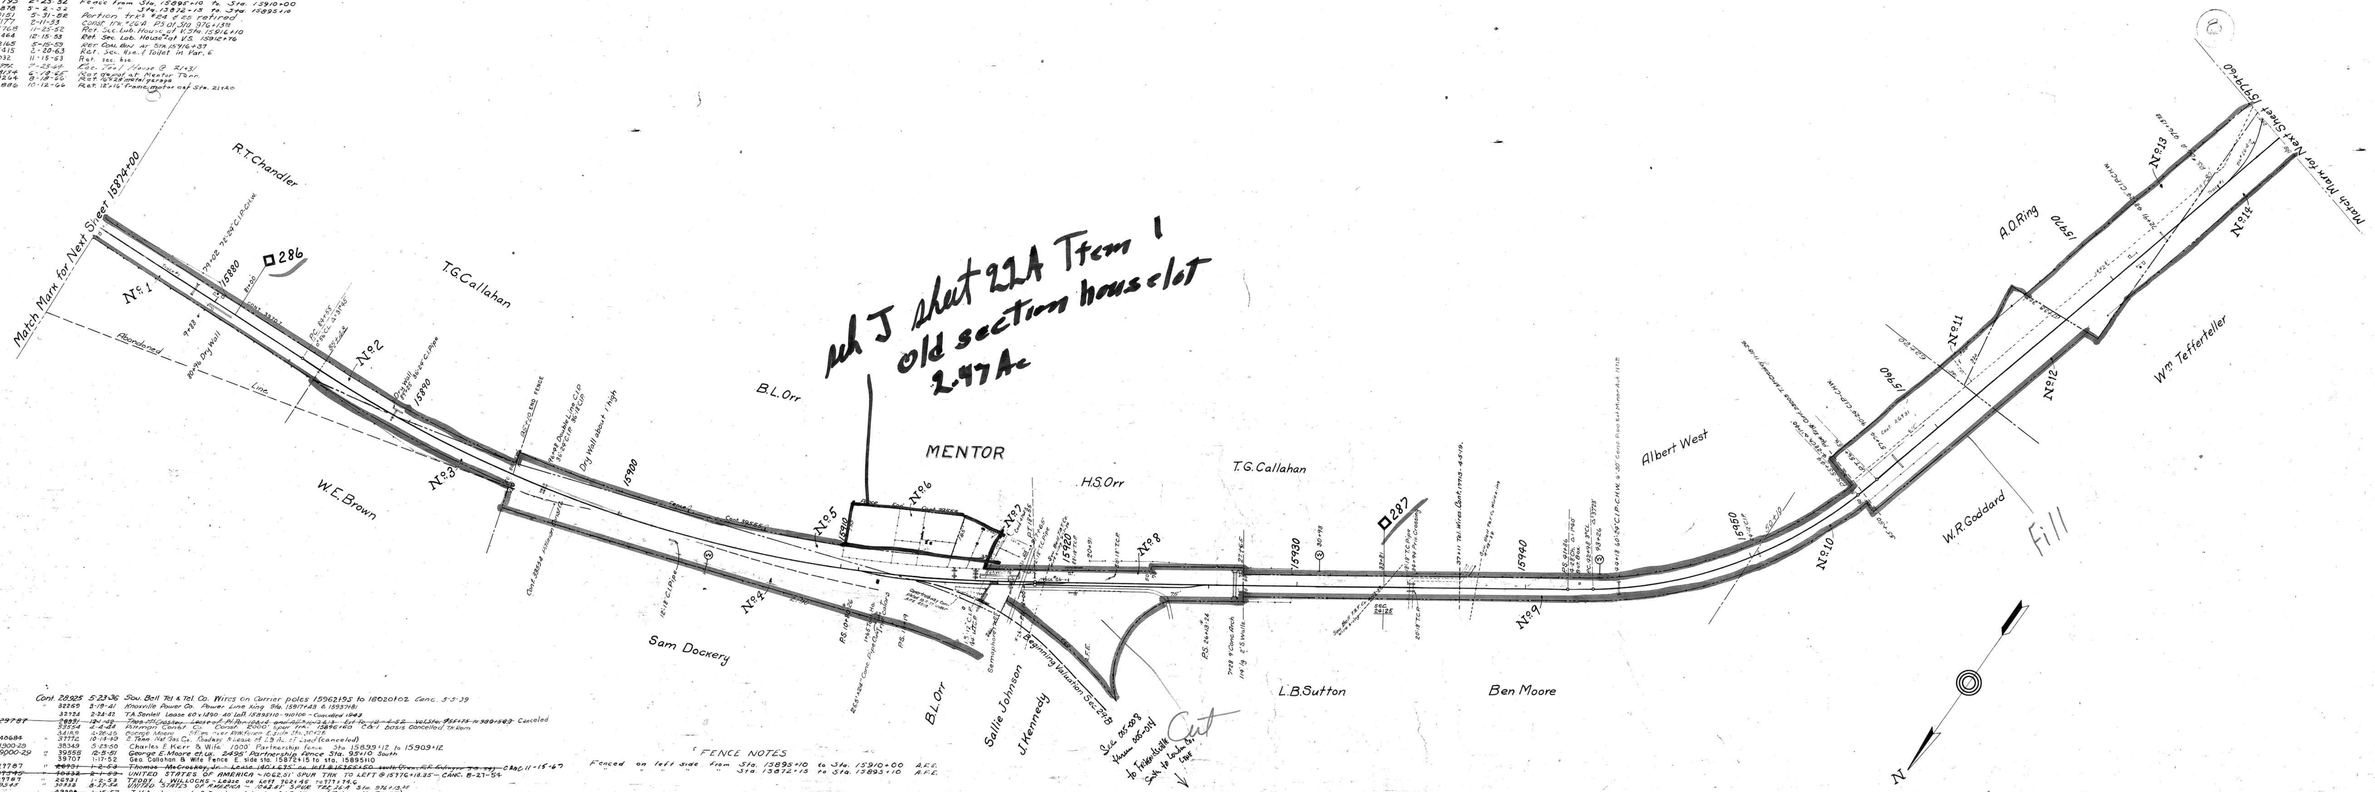

mh J sheet 22A Item 1
Old section house lot
2.47 Ac

Cont. 28925	5-23-36		Sou. Bell Tel. & Tel. Co. Wires on Carrier poles 15962.193 to 16020.102. Canc. 5-5-39
" 32260	3-18-41		Knoxville Power Co. Power Line King Sta. 15917+43 & 15933+81
" 33132	3-22-42		T.A. Zenkel Lease 40 x 1250 - 40 feet 15932+10 - 15970+50 - Canceled 1942
~~LF 29787~~	~~9-25-42~~		~~Thos. McCreary, Jr. Lease of Pl. Sec. 2 and adjacent right of way. Lease 1-4-2. Valuation 15915+10 to 15934+83 Canceled~~
	9-25-42		Canceled
	33254	2-4-43	Paterson Canal Co. Canal 20000' spur trk. 15896+60 C.A.F. Basis Canceled 10-6-44
	34183	4-26-45	George Moore 50' sq. per 100' from E. side Sta. 15915
LF 40684	37772	10-13-49	E. Tenn. Nat. Gas Co. Gadsby Lease at 1.3 A. 27 cu. ft. (cancelled)
" 1300-25	38349	5-23-50	Charles E. Kerr & Wife 1000' Partnership fence Sta. 15839+12 to 15903+12
" 19000-29	39558	12-5-51	George E. Moore et al. 2498' Partnership fence Sta. 93+10 South
" 27787	39707	1-17-52	Geo. Callahan & Wife Fence E. side Sta. 15872+15 to Sta. 15895+10
	~~40232~~	~~9-1-53~~	~~UNITED STATES OF AMERICA - 1042.51' SPUR TRK. TO LEFT @ 15776+18.35 - CANC. 8-21-54~~
	45752	1-12-61	Chas. W. Barsing Lease w/ Ice Dept. Canc. 5-9-63
	47678	7-17-61	South Blount County Utility Dist. - 2" water line King V.L. 15931+25

FENCE NOTES

Fenced on left side from Sta. 15895+10 to Sta. 15910+00 A.F.E.
Sta. 15872+15 to Sta. 15895+10 A.F.E.

Sta. 15895 Item 1 to Friendship Sch. to Sta. 15910 Item 1

Cut

RIGHT OF WAY AND TRACK MAP
LOUISVILLE AND NASHVILLE R. R. CO.
KNOXVILLE DIVISION

STATION 15874+00 TO STATION 15979+60

SCALE - 1 INCH = 200 FT. JUNE 30 1917.

OFFICE OF CHIEF ENGINEER
LOUISVILLE, KY.

SHEET NO. 6 OF 31 OF KNOXVILLE DIVISION FROM SURVEY STATION 15874+00 TO SURVEY STATION 15979+60.

R. Belleisle
VALUATION ENGINEER

005-018

V-29
6

29-6

BLOUNT CO. TENN.

11-1