A.F.E. Nº	DATE COMP.	DESCRIPTION OF CHANGE
3531		SEE MAP 7B.
5461	9-18-24	TRK. 28A REMOVED FROM STA. 16131+30 TO 16141+28.
6838	9-12-25	TRK. 29D REMOVED.
30223	5-12-49	Farmer Jas. Fence Const. Sta 8C100 to 08+10
44061	6-24-55	Rel. Trk #28 E - 448 ft.
47190	2-1-57	Rebuild Brº 209
47191	2-18-57	Rebuild Brº 210

PARCEL Nº	GRANTOR	GRANTEE	INST.	DATE	RECORDED BOOK	RECORDED PAGE	SEC'Y. Nº	REMARKS
1	S. M. EVERETTE, ET AL.	L & N RR.	DEED	2-4-07	63	213	8940	
2	R. H. HANNAH	"	"	2-26-06	60	380	7224	
3	HUGH TEDFORD	"	"	2-6-06	60	386	7225	
4	N. W. PROFITT	"	"	2-7-06	60	349	7226	
5	J. R. SINKLETON	"	"	1-22-06	60	351	7514	
6	ALUMINUM COMPANY OF AMERICA	"	CONT.	3-6-17			17157/1	
7	BABCOCK LAND & LUMBER CO.	"	"	"			"	
8	VEACH-MAY-WILSON (ALCOA)	"	"	12-30-49				

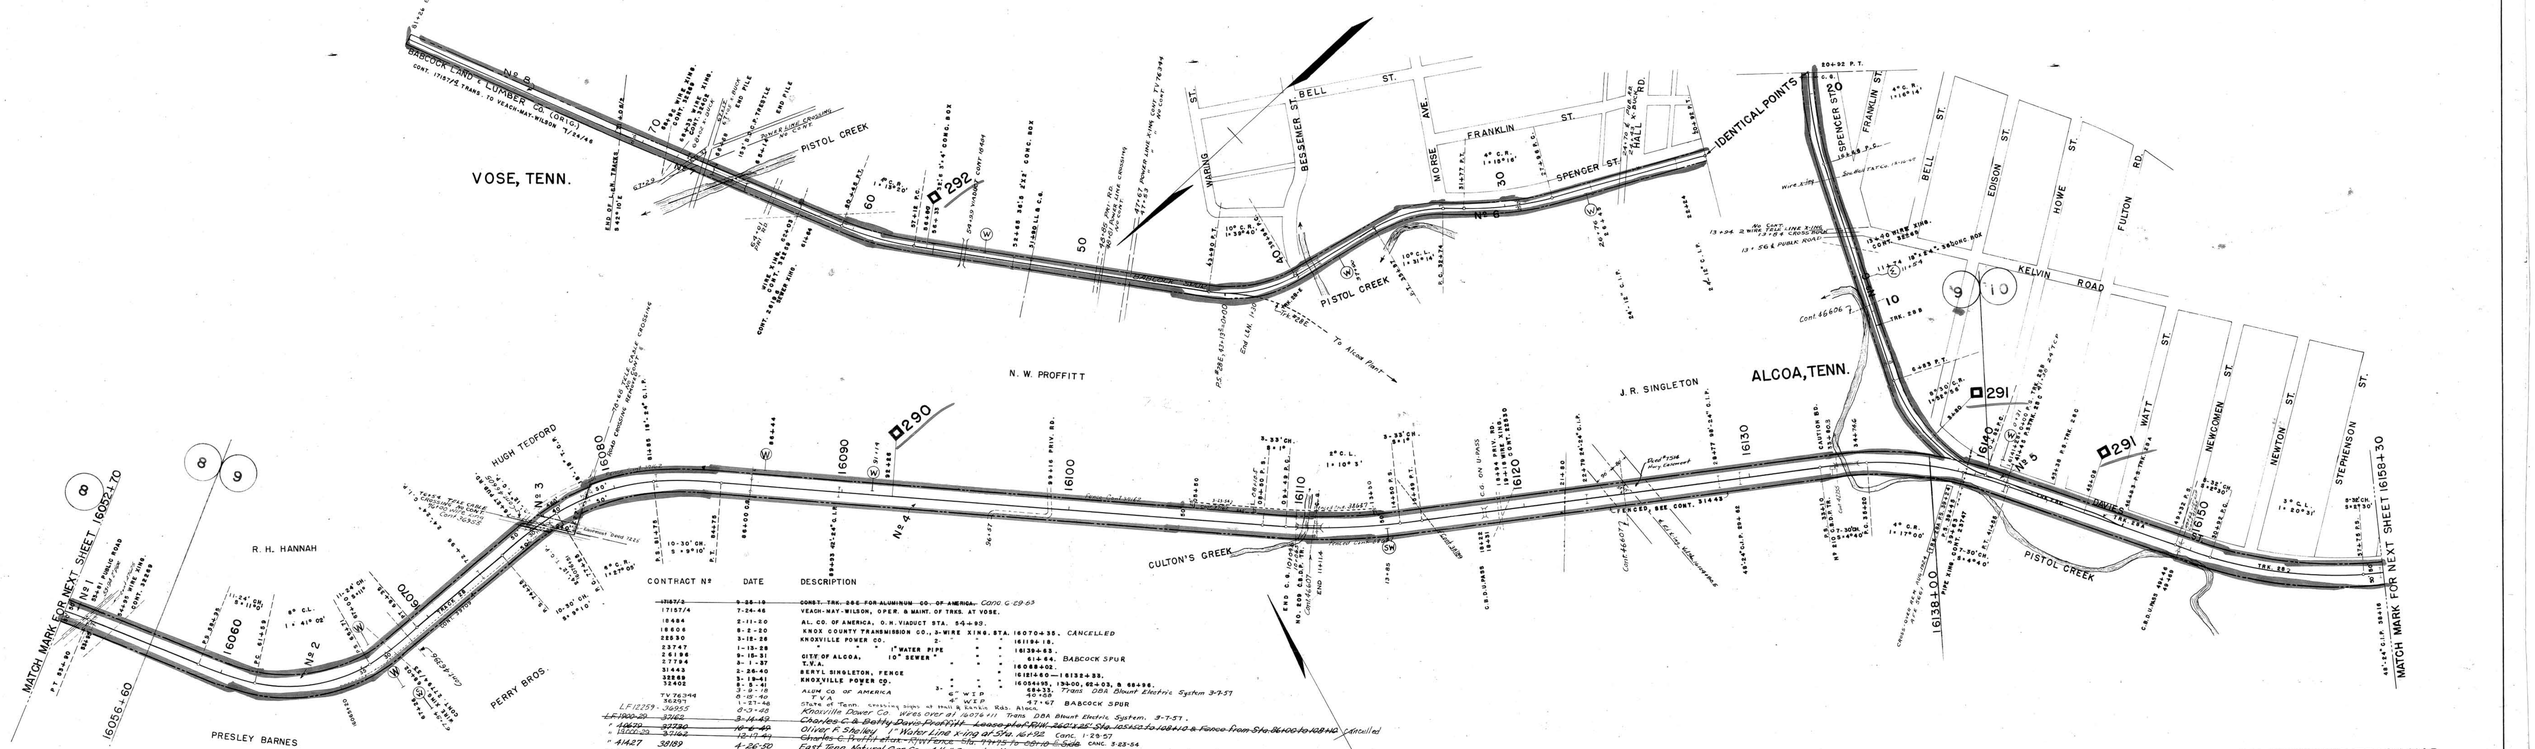

CONTRACT Nº	DATE	DESCRIPTION
~~17157/3~~	~~9-26-18~~	~~CONST. TRK. 28E FOR ALUMINUM CO. OF AMERICA. Cont. G-29-63~~
17157/4	7-24-46	VEACH-MAY-WILSON, OPER. & MAINT. OF TRKS. AT VOSE.
18484	2-11-20	AL. CO. OF AMERICA, O.H. VIADUCT STA. 54+89.
18604	8-2-20	KNOX COUNTY TRANSMISSION CO., 3-WIRE XING. STA. 16070+35. CANCELLED
22530	3-18-26	KNOXVILLE POWER CO. " " " " " 16118+18.
23747	1-13-28	" " " " 1" WATER PIPE " " 16139+63.
25198	9-15-31	CITY OF ALCOA. 10" SEWER " " 16146+66. BABCOCK SPUR
27784	8-1-37	T.V.A. " " " " 16068+02.
31443	2-26-40	BERYL SINGLETON, FENCE " " 16121+80 — 16132+33.
32588	3-19-41	KNOXVILLE POWER CO. " " " " 16054+90, 13+00, 62+03, & 68+86.
33402	5-5-41	ALUM. CO. OF AMERICA " " " " 48+33. Trans. ORA Blount Electric System 3-7-51
TV 76344	3-9-16	T.V.A. 6" W.I.P. " " 47+58
36891	6-10-46	" 4" W.I.P. " " 47+67 BABCOCK SPUR
L.F. 17259 - 36955	6-3-46	State of Tenn. Spreading slope at Main & Banks Rds. Alcoa.
~~L.F. 17259-29~~	~~37162~~	~~Knoxville Power Co. Wires over R/W 16076+11 Trans. ORA Blount Electric System. 3-7-51.~~
~~* 41679~~	~~37720~~	~~Charles C. & Betty Davis Proffitt — Lease plot R/W. 26013 ft. Sta. 16540+10 to 16840+0 & Fence from Sta. 8C100 to 10B+10 (Cancelled~~
~~* 41680~~	~~37762~~	~~Oliver F. Shipley 1" Water Line x-ing at Sta. 16+92. Canc. 1-29-57.~~
~~* 41427~~	~~38189~~	~~Charles C. Proffitt et al — right of way 50' 1+75 to 10+10 — Sale. Canc. 3-23-54.~~
~~* 35441~~	~~38224~~	~~East Tenn. Natural Gas Co. 4 1/2" Gas pipe line in side 8 5/8" casing at Sta. 16115+75 x-ing under~~
~~* 19000-29~~	~~38637~~	~~Mrs. Mary Wilson — Fence along R/W Sta. 114+74 (Canc. 9-3-57).~~
15192	33709	O.F. Shirley & wife, Fence on N side of R/W Sta. 16148+18.0 to 16132+08.0; on S. side of R/W Sta. 16138+06.5 to 16132+01.
* 42057	40520	Albert Love Lease of land 0.5 ac. S. side Sta. 16065+20 to Sta. 16076+51; Memo. 6-22-62. Trans. to F. D. Eagleton
19000-29	41184	Wm. B. Bassham and Hanson Lowe 2" water pipe under Sta. 57+84 and Sta. 59+46 on north
	37142	H. Love Fence on S. side of R/W Sta. 16053+50 to 16065+20
13915	17157	Walter D. Proffitt Lease of R/W 250' x 25' — Sta. 16540+10 to Sta. 16840+10 — Cal. side
	41705	Veach, May, Wilson, Inc. & Aluminum Company of America — R/W Changed Term 100' To 50' on Babcock Spur — Sta. 0+00 to 71+06
* 43440	42155	City of Alcoa 12" Cast Sewer X-ing Sta. 49+75.
	44129	Topoco, Inc. 6" Water main under Sta. 16133+92
* 36168	44129	Blount County — Agreement for King Signals Sta. 16124+80.5
	49060	Tenn. Dept. of Hwys. " " grade X-ing of Maryville By-pass
Prev. Cont.	7252	" " " " "
Cont.	46396	Blount Co. Tenn. Easement for Hwy. Sta. 16076+49.8
		F. D. Eagleton — 1" water line X-ing under Sta. 16068+74.2
Prev. Cont.	7214	State of Tenn. Dept. of Highways and Public Works — Hwy. Easement across R/W at Sta. 16150+80.5
Cont.	46605	City of Alcoa — 6" water line X-ing under Sta. 16076+30
"	46606	" " " 6" sewer " " " " 159+35.4 off trk. #28B
"	46607	" " " 8" sewers X-ing under Sta. 16110+78 & 16124+44.5
"	47426	Knoxville Blount County Utility Dist. 8" X-ing under Sta. 16+92
"	47249	State Hwy. Dept. of Tenn. — Lake X-ing

RIGHT OF WAY AND TRACK MAP
LOUISVILLE AND NASHVILLE RR. CO.
KNOXVILLE DIVISION
MARYVILLE BRANCH

STATION 16052+70 TO STATION 16158+30

SCALE- 1" = 200' JUNE 30, 1917

OFFICE OF CHIEF ENGINEER
LOUISVILLE, KY.

V-29
7A

005-020

REVISED AND RETRACED AUGUST 1947 J.H.V.

V 29- 7A

BLOUNT COUNTY, TENNESSEE

11-1