A.F.E. No.	Date	Comp. Designation of Change
4138	9-16-28	Constat (1-10) mon adenloo to Beef Foreman house on Rail-Ro
33701	8-10-46	Ret. water tank at Sta. 401+74, and Const. water tank at Sta. 370+69.
34752		Shifting P.C. of Crv. #40 from Sta. 393+76 to Sta. 400+79.
30831	10-5-50	2725 Rem. Elev. and Weld R. Rlw. Rl. Sta. 16310+90 to 16334+01
40171	3-11-52	Construction of 1834 on to Track #40 (Old Length Now 3482)
42867	11-5-52	Rel. Sec. Lab. House at Sta. 16385+14.
38626	11-9-48	Ret. 2-4 Rlw. (Freight-off Platf.) station House by 16th

Cont. 32165 3-19-41 Maryville Elect System Power Line Crossing Sta. 16350.6167 Const. 1922
Cont. 32403 2-23-41 Sou Bell Tel & Tel Co - wires on 14th poles - Ret. Sta. 16287.5 S.M.P. 244 to 800 S.M.P. 236 Cancelled 8-10-51
L.F. 19000-49 " 32336 8-6-47 J.S. Buck & Wife Fence East side R/W Sta. 16432.5 to 16442
L.F. 19001-49 " 38234 5-6-50 J.S. Hayes " " " Refl. poles " " 16320+70 to 16324+60
" " " 41049 12-4-53 John Spalding Lease of 1.67 Ac. in Par. No. 9 - Tract 1-32-19 to Lester M. Johnson
" " " 41182 12-16-53 John Spraoling Fence East side R/W Sta. 376+40 to 393+54, West side R/W Sta. 382+11 to 393+54
~~" 30556~~ ~~" 8-8-50 Sou. Bell Tel & Tel Co. - Cable on poles Sta. 16287.5 to 16350.6167~~ Cancelled 10-11-46
" 42623 7-17-62 South Blount County Utility Dist. - 6" water mains King Rd. 16287+84 & 16350+34
" 47856 1-19-66 State of Tenn. - Flashing Sign at G-87

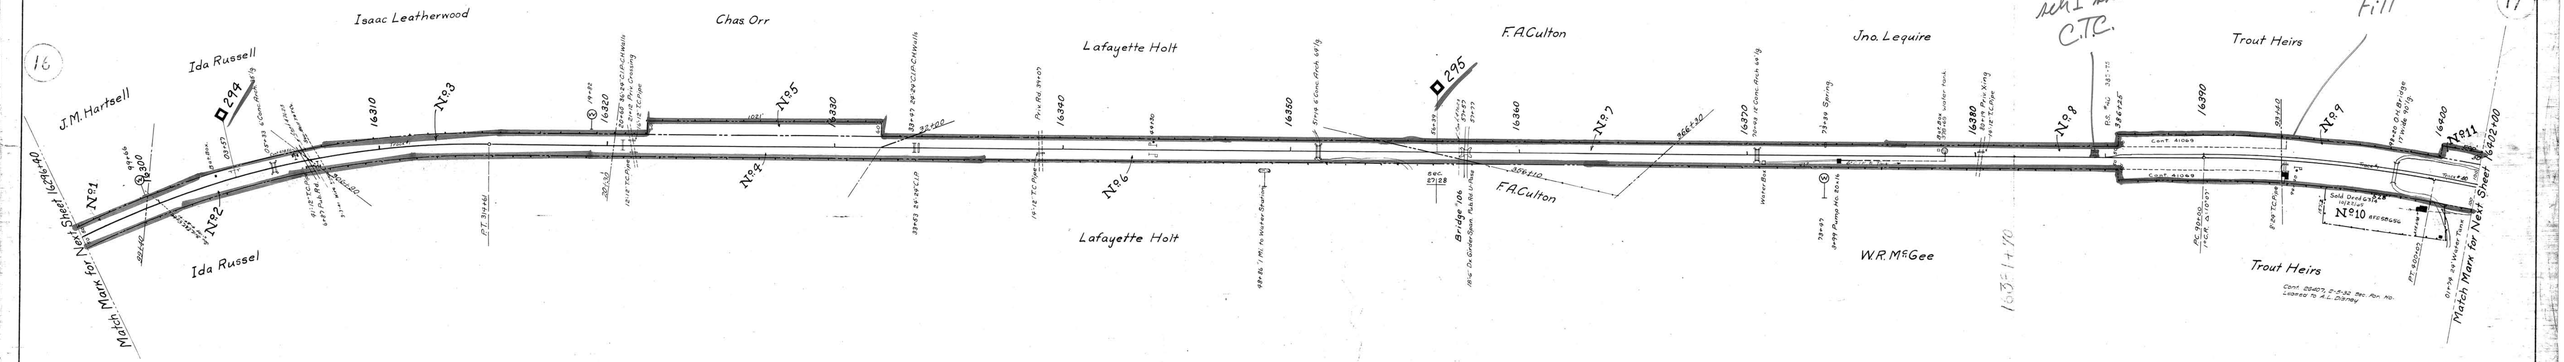

N

RIGHT OF WAY AND TRACK MAP
LOUISVILLE AND NASHVILLE R. R. CO.
KNOXVILLE DIVISION

STATION 16296+40 TO STATION 16402+00

SCALE- 1 INCH = 200 FT. JUNE 30 1917.

OFFICE OF CHIEF ENGINEER, LOUISVILLE, KY.

SHEET NO. 10 OF 71 OF KNOXVILLE DIVISION FROM SURVEY STATION 16296+40 TO SURVEY STATION 16402+00

005-024

D. Belcinne
VALUATION ENGINEER

V-29
10

29-10

BLOUNT CO. TENN.