Date Completed	Description
10-18-58	Const. Trk. #441 For Hardy Sand Co.

No.	GRANTOR	GRANTEE	INFORMATION	DATE	RECORD	PAGE NO.	REMARKS
1	J.L.Mekes	N.C.&St.L.R.Co.	Deed	Feb.25,1880	Office of Secretary	2497	See Note 1
2	Moses Rowland	N.C.&St.L.R.Co.	Lease	Feb. 27,1880	Office of Secretary	3275	See Note 1
3	J.R.Hutchison	J.T.Thomas, Agent	Deed	Jan.23, 1:02	TN Register 1-July 11,1:02	5191	
	J.W.Thomas Jr.et al	Wenu.Property Co.	Deed	Jay 1, 1956	TN R-Sch-Sday 24,1956	5211	
4	J.R.Hutchins	J.T.Thomas, Agent	Deed	Jan.23, 1:02	TN R3-Book 1-July 11,1:02	5191	
	J.W.Thomas Jr.et al	Denomeson Property Co.	Deed	Jay 18,1956	TN R-Sch-Sday 24,1956	5211	
5	C.Reid Green	N.C.&St.L.R.Co.	Lease	Feb.27,1880	Office of Secretary	3276	See Note 1

NOTE 1- Deed provides for such additional right of way as may be required for the full and convenient construction, use and maintenance of the railroad.

Deed was built by the Nashville and Northwestern Railroad Company. See Minute Book V,page 485 of the Chancery records at Nashville for decree confirming sale to the Nashville and Chattanooga Railroad Company, which was later changed to the Nashville, Chattanooga and St.Louis Railway.

6	Tenn. Prop. Co.	L & N R.R.	Deed	8-2-63	Bk 28 P.155	14822

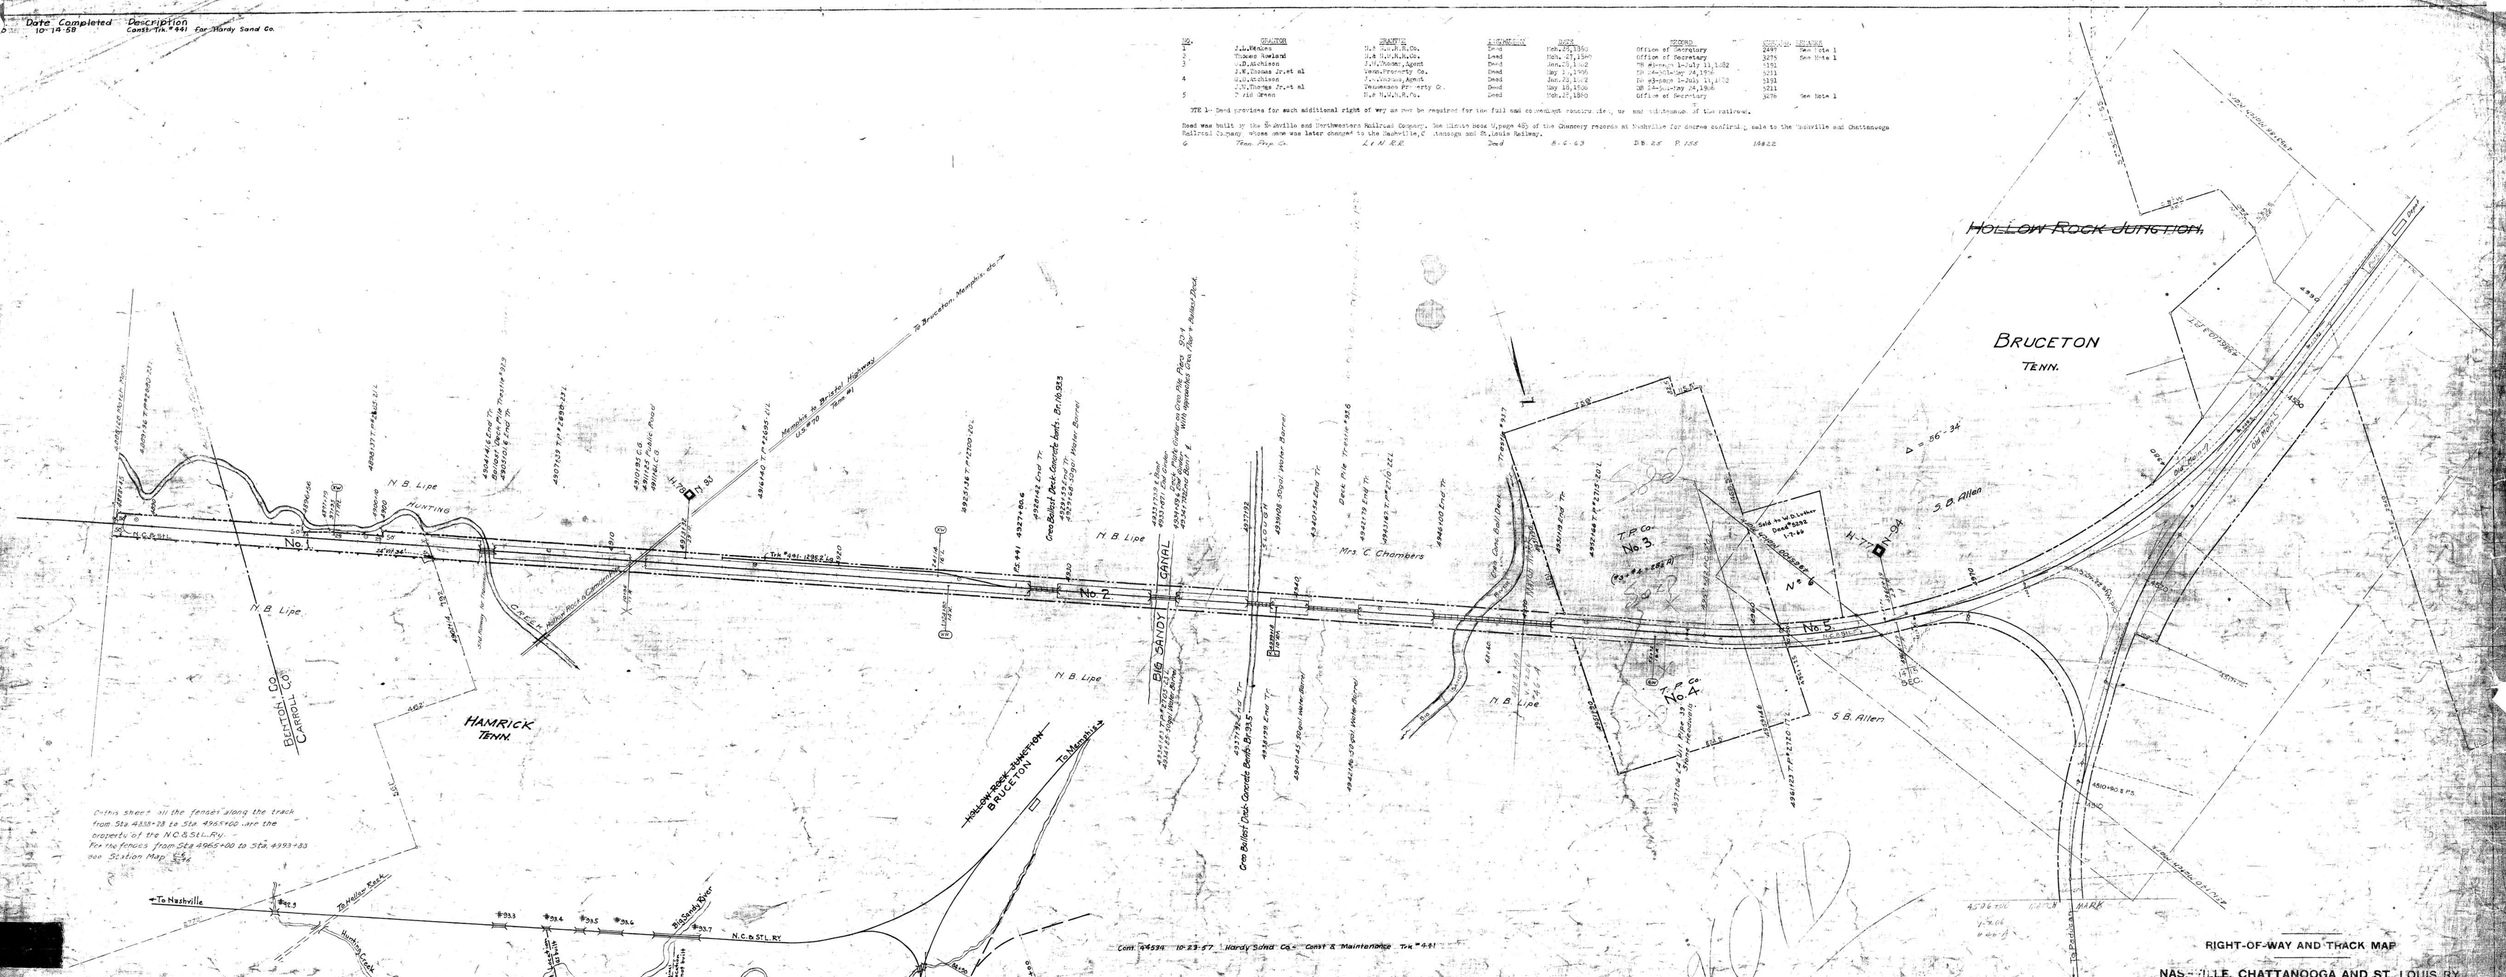

RIGHT-OF-WAY AND TRACK MAP

NASHVILLE, CHATTANOOGA AND ST. LOUIS RY.

NASHVILLE DIVISION

STATION 4888+28 TO STATION 4993+83

SCALE, 1 IN. 200 FT. JUNE 30, 1916