| AFE Nº | Date Comp | Remarks |
|---|---|---|
| 99470 | 6-15-66 | Const. track Nº451 |
| 99246 | 9-21-66 | Const trk. Nº452 |

| | Grantor | Grantee | Instrument | Date | Recorded | Book No. | Remarks |
|---|---|---|---|---|---|---|---|
| 1 | John Allman | N.&N.W.R.R.Co. | Deed | Mch.27,1860 | Office of Secretary | 3291 | See Note 1 |
| 2 | Gorton T.Allen | N.& N.W.R.R.Co. | Deed | Mch.31,1860 | Office of Secretary | 3292 | See Note 1 |
| 3 | T.M.Brewer | N.& N.W.R.R.Co. | Deed | Aug.4,1859 | Office of Secretary | 3293 | See Note 1 |
| 4 | S.W.Dell | N.& N.W.R.R.Co. | Deed | Mch.31,1860 | Office of Secretary | 3294 | See Note 1 |
| 5 | A.C.McNail et al | N.& N.W.R.R.Co. | Deed | Mch.27,1860 | Office of Secretary | 3295 | See Note 1 |
| | N.C.& St.L.Ry. | S.H.Williams | Decree | July 16,1894. | MB Chancery O-N-452 | 2881 | |

NOTE 1- Deed provides for such additional right of way as may be required for the full and convenient construction, use and maintenance of the railroad.

Road was built by the Nashville and Northwestern Railroad Co. See Minute Book W,page 485,of the Chancery records at Nashville for decree confirming sale to the Nashville and Chattanooga Railroad Company, whose name was later changed to the Nashville,Chattanooga & St.Louis Railway.

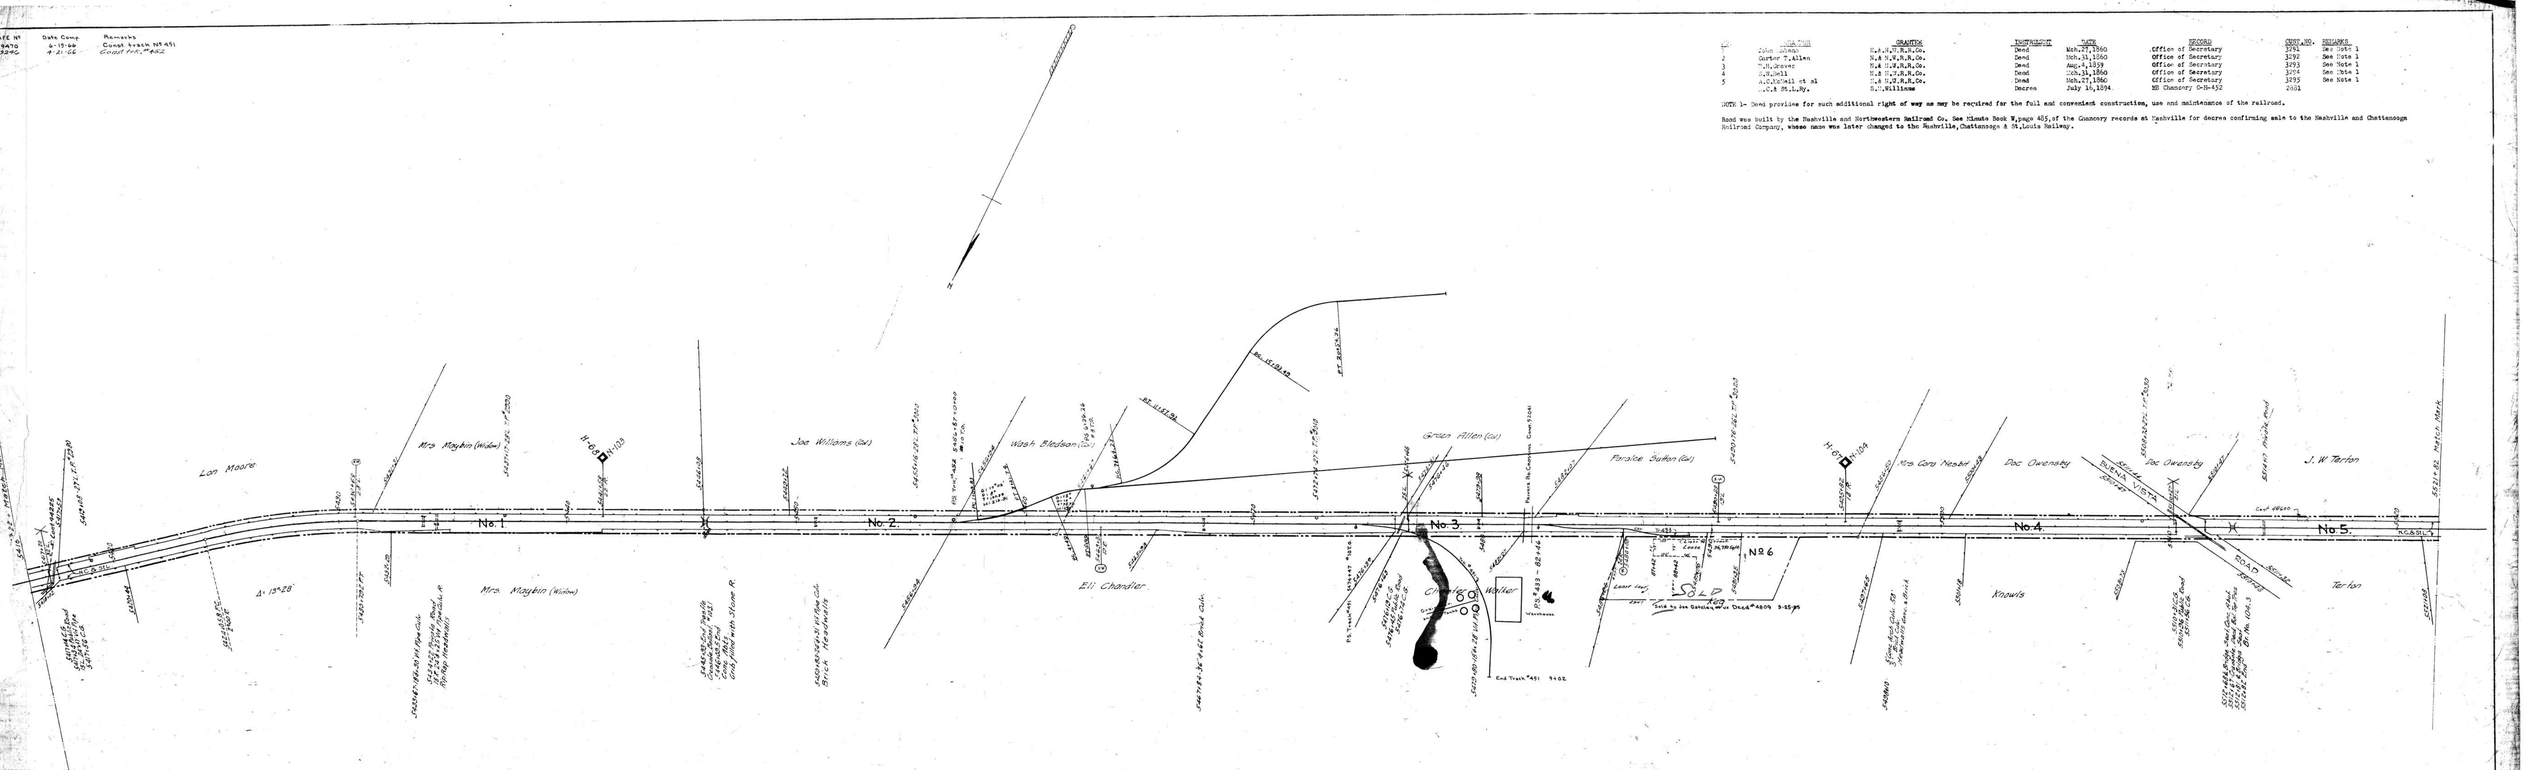


RIGHT-OF-WAY AND TRACK MAP

NASHVILLE, CHATTANOOGA AND ST. LOUIS RY.

NASHVILLE DIVISION

STATION 5416+22 TO STATION 5521+82

SCALE, 1 IN. 200 FT. JUNE 30, 1916

OFFICE OF CHIEF ENGINEER
NASHVILLE, TENN.

M.P. 102.5 to 104.5

009-007

eet No. 53 of 87 sheets of
shville Div. Main Line from
reg station 5416+22 to survey
tion 5521+82

Production Engineer

CARROLL, CO. TENN. CIVIL DIST. No. 11

70'-G-2

V. 6
51