A.F.E.	DATE COMPLETED	DESCRIPTION
50558	10-29-58	Const. Trk. #443 for McKenzie Industrial Dist.

NO.	GRANTOR	GRANTEE	INSTRUMENT	DATE	RECORD	CONT. NO.	REMARKS
1	H.H.Ridley	N.& N.W.R.R.Co.	Deed	Feb.2,1860	Office of Secretary	3313	See Note 1
2	Allen Browden	N.& N.W.R.R.Co.	Deed	Feb.2,1860	Office of Secretary	3314	See Note 1
3	Wm.Ingram	N.& N.W.R.R.Co.	Deed	Feb.2,1860	Office of Secretary	3315	See Note 1
4	Stephen S.Pate	N.& N.W.R.R.Co.	Deed	Feb.1,1860	Office of Secretary	3316	See Note 1
5	Garland Smead	N.& N.W.R.R.Co.	Deed	Mch.29,1860	Office of Secretary	3317	

NOTE 1- Deed provides for such additional right of way as may be required for the full and convenient construction, use and maintenance of the railroad.

Road was built by the Nashville and Northwestern Railroad Company. See Minute Book W,page 485 of the Chancery Records at Nashville for decree confirming sale to the Nashville and Chattanooga R.R.Co., whose name was later changed to the Nashville,Chattanooga & St.Louis Railway.

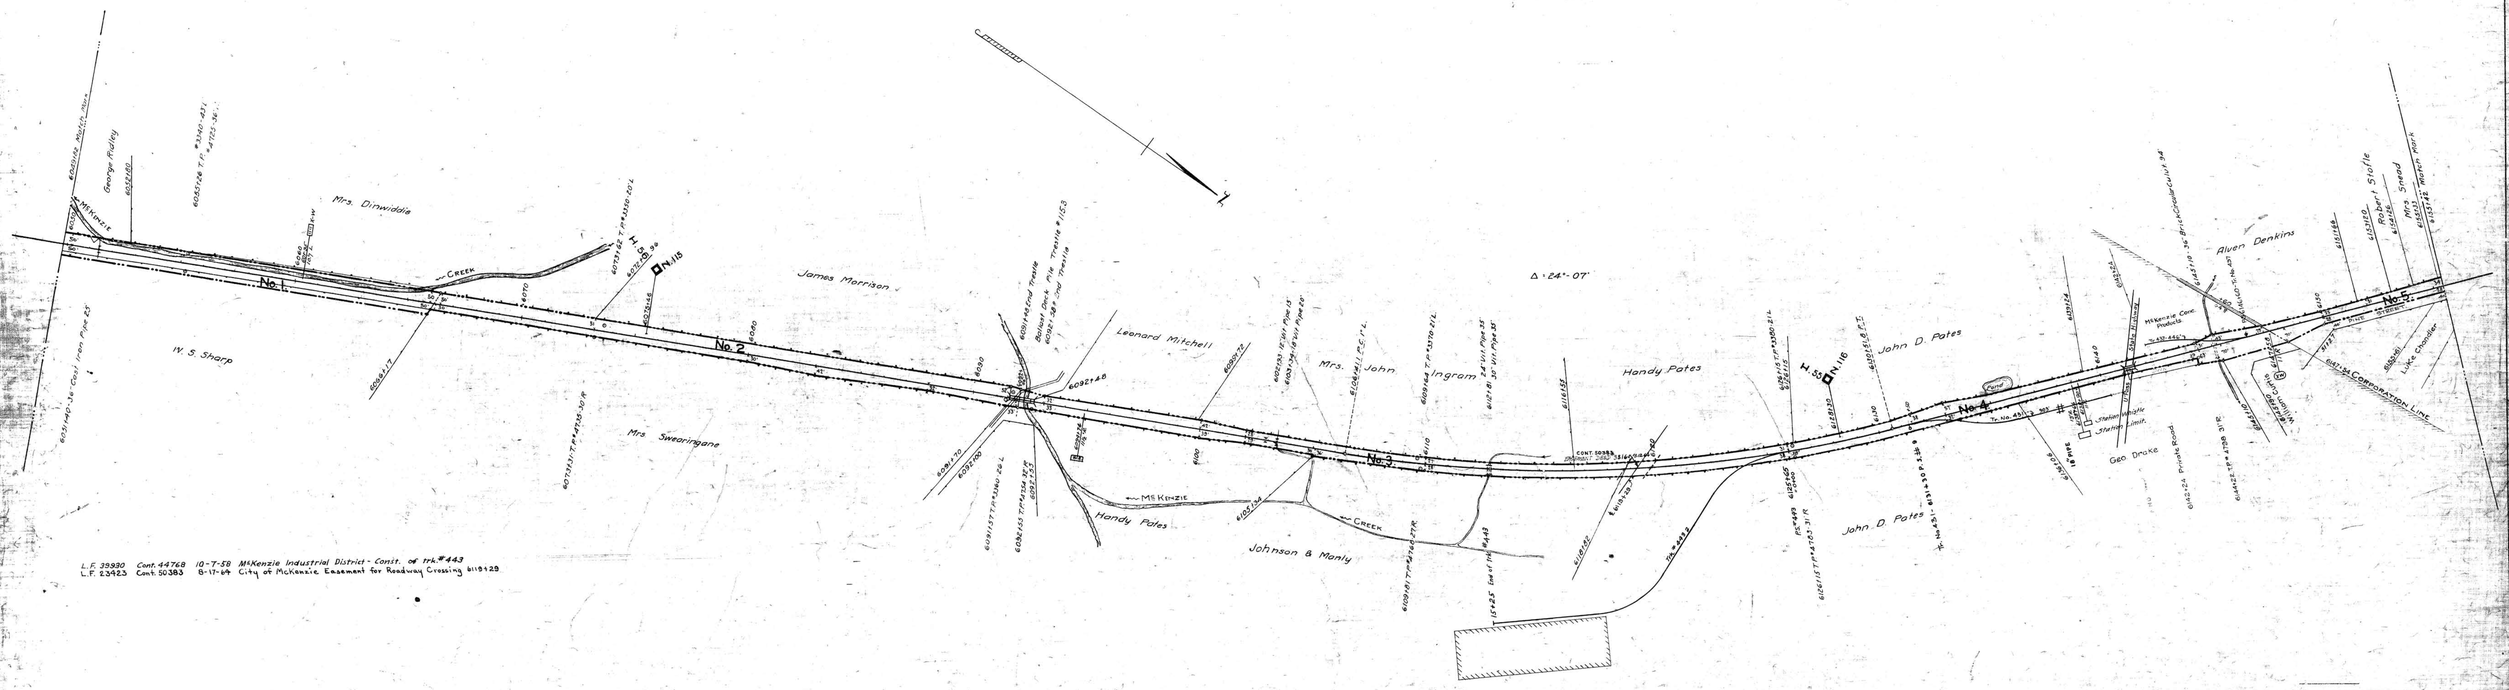

L.F. 39930 Cont. 44768 10-7-58 McKenzie Industrial District - Const. of trk. #443
L.F. 23423 Cont. 50383 8-17-64 City of McKenzie Easement for Roadway Crossing 6119+29

RIGHT-OF-WAY AND TRACK MAP

NASHVILLE, CHATTANOOGA AND ST. LOUIS RY.

NASHVILLE DIVISION

STATION 6049+82 TO STATION 6155+42

SCALE, 1 IN. 200 FT. JUNE 30, 1916

Sheet No 60 of 87 Sheets of Nashville Div. Main Line from survey station 6049+82 to survey station 6155+42

Valuation Engineer

OFFICE OF CHIEF ENGINEER NASHVILLE, TENN.

M.P. 1145 to 1165

009-014

CARROLL, CO. TENN., CIVIL DISTRICT NO. 4

24-3