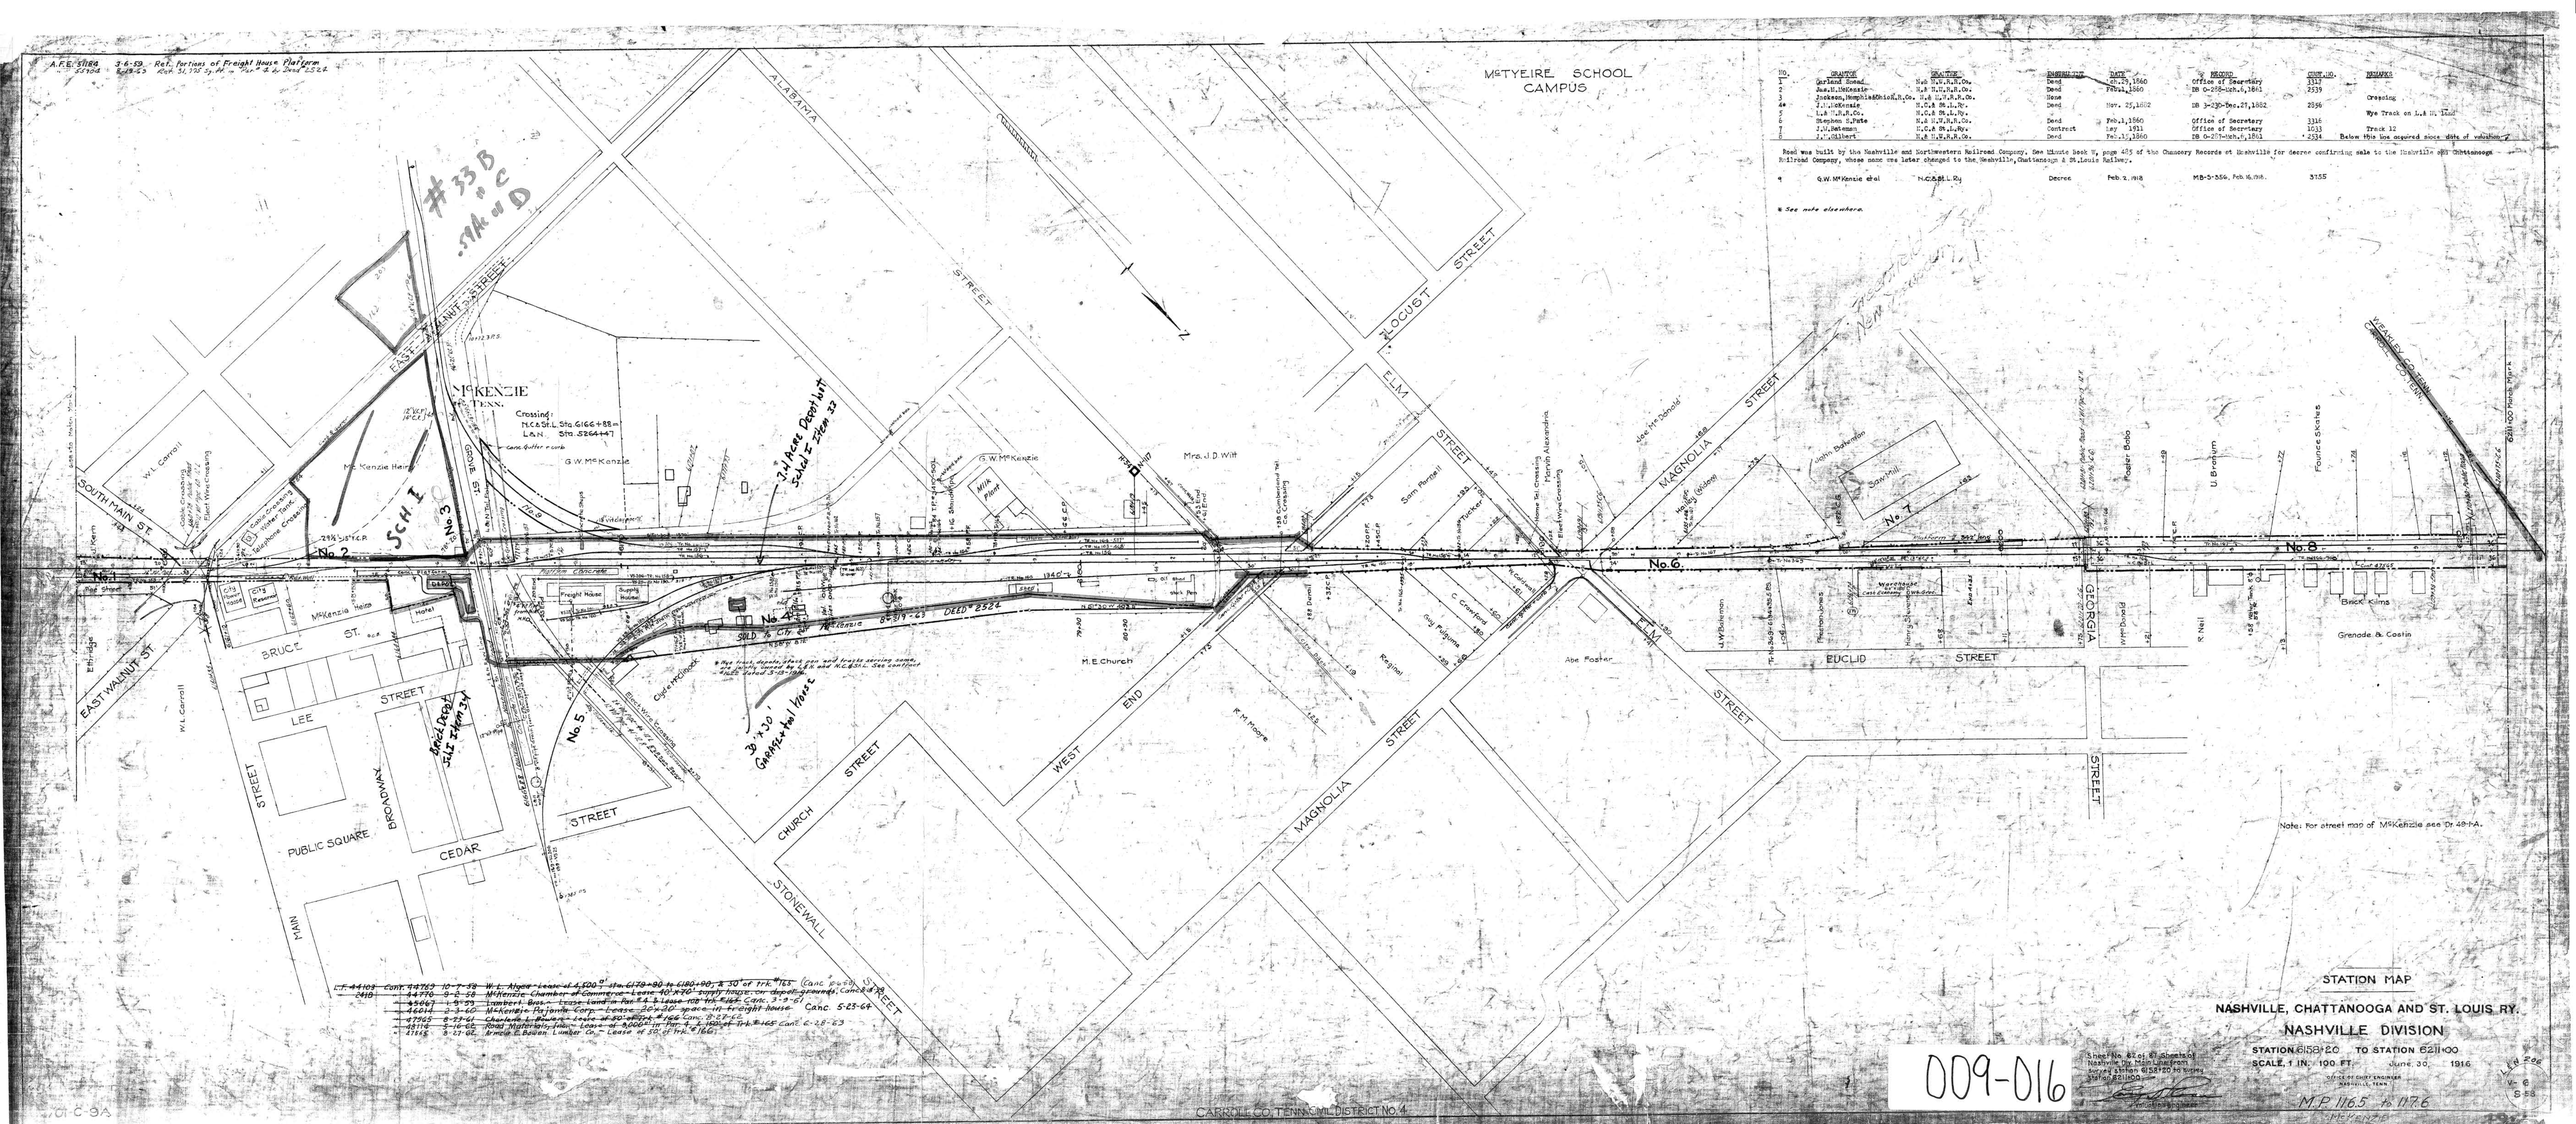

NO.	GRANTOR	GRANTEE	INSTRUMENT	DATE	RECORD	COST NO.	REMARKS
1	Garland Bonner	Nsb & N.R.R.Co.	Deed	Oct.25, 1860	Office of Secretary	3317	
2	Jas.H.McKenzie	N.& S.R.R.Co.	Deed	Febry.1860	DB 0-258-Mch.6,1861	2539	Crossing
3	Jackson, Memphis&Ohio R.R.Co.	N.& S.R.R.Co.	Deed	None			
4*	J.J.McKenzie	N.C.& St.L.Ry.	Deed	Nov. 25,1862	DB 3-230-Dec.27,1862	2556	
5	L.& N.R.R.Co.	N.C.& St.L.Ry.					Wye Track on L.& N. Land
6	Stephen D.Pate	N.& N.R.R.Co.	Deed	Feb.1,1860	Office of Secretary	3316	
7	J.W.Bateman	N.C.& St.L.Ry.	Contract	May 1911	Office of Secretary	3513	Track 12
8	J.L.Gilbert	N.& N.R.R.Co.	Deed	Feb.21,1880	DB 0-274-Mch.6,1901	* 2534	Below Mtn Loc acquired since date of valuation 7

Road was built by the Nashville and Northwestern Railroad Company. See Minute Book W, page 485 of the Chancery Records at Nashville for decree confirming sale to the Nashville and Chattanooga Railroad Company, whose name was later changed to the Nashville, Chattanooga & St. Louis Railway.

9	G.W. McKenzie et al	N.C.& St. L. Ry	Decree	Feb. 2, 1918	MB-5-356, Feb. 16, 1918.	3155

* See note elsewhere.

L.C. 44103 Cont. 44763 10-7-58 W.L. Alger Lease at 4,200 ± fm. 6179+90 to 6180+90, & 30' of Trk. #165 (Canc. 5-25-64)
" 7418 44776 5-2-58 McKenzie Chamber of Commerce Lease 40 x 80 supply house on depot grounds, Canc. 5-9-61
" 44967 5-9-58 Lambert Bros. Tractor Co. Lease 30 x 80 space in freight house Canc. 5-25-64
" 46611 2-3-60 McKenzie Poultry Corp. Lease 30 x 30 space in freight house
" 47265 9-27-61 Charles L. Bowers Lease at 20¢ per sq. ft. Canc. 9-27-63
" 48116 5-16-62 Road Materials Inc. Lease of 4,000 lin. ft. ± of 30' trk. #165 Canc. C-28-63
" 47155 5-17-62 Ernest E. Bauer Lumber Co. Lease of 35' of Trk. #166

STATION MAP

NASHVILLE, CHATTANOOGA AND ST. LOUIS RY.

NASHVILLE DIVISION

STATION 6158+20 TO STATION 6211+00

SCALE, 1 IN. 100 FT. June 30, 1916

Shows No. 82 of 87 Sheets of Nashville City Main Line from Survey Station 6153+20 to Survey Station 6211+00

M.P. 116.5 to 117.6

009-016

CARROLL CO. TENN. CIVIL DISTRICT No. 4

01 C-9A