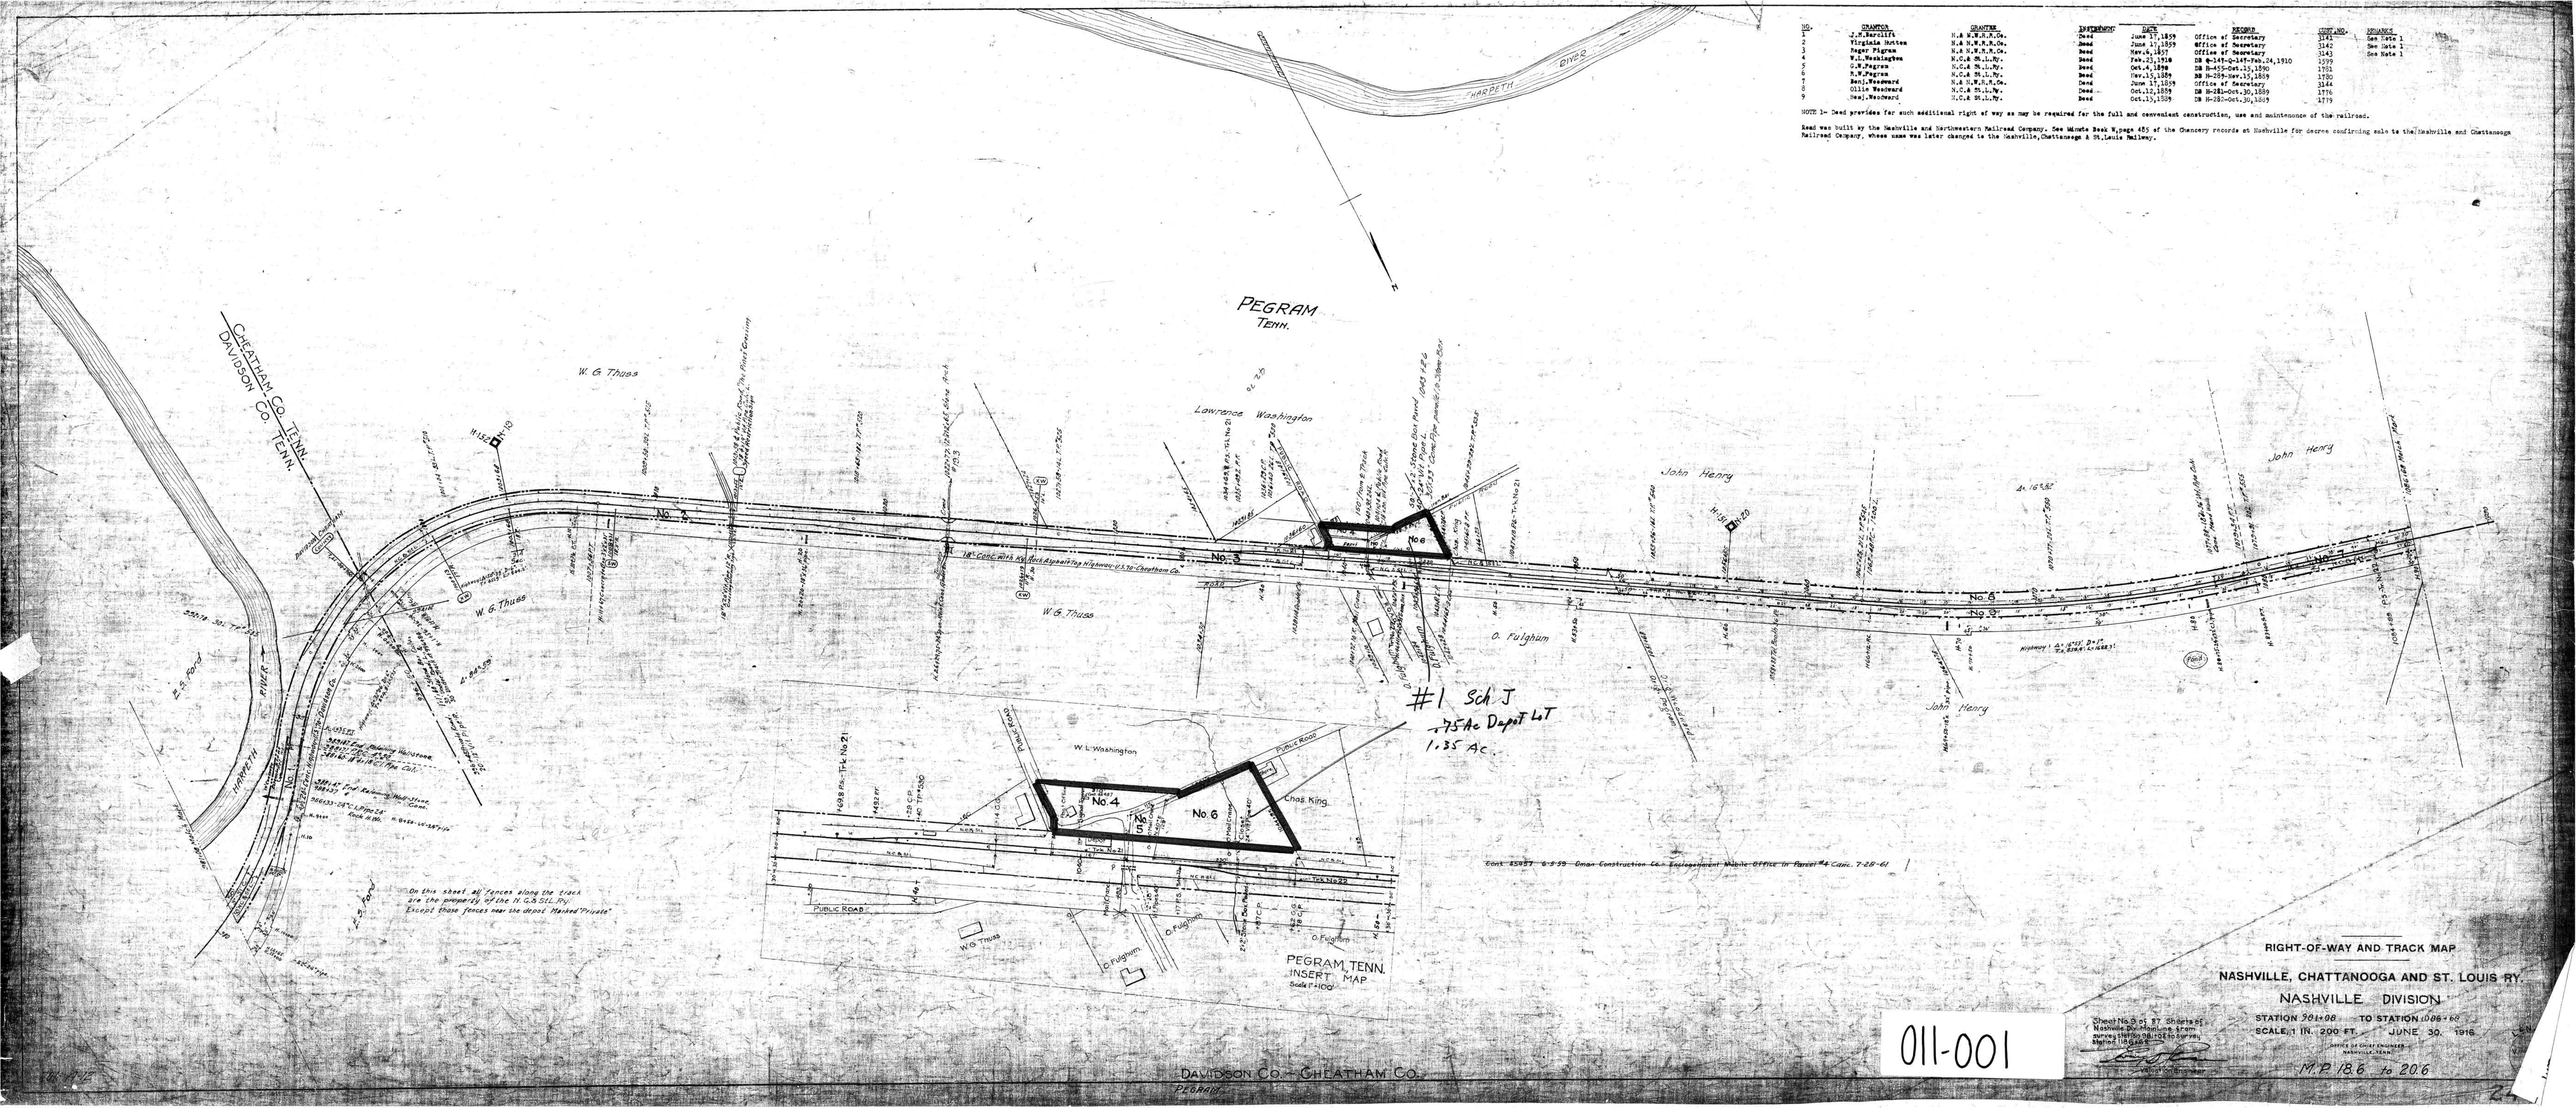

NO.	GRANTOR	GRANTEE	INSTRUMENT	DATE	RECORD	COURT AND DOCKET	REMARKS
1	J.M.Barclift	N.& W.R.R.Co.	Deed	June 17,1859	Office of Secretary	3141	See Note 1
2	Virginia Hatten	N.& W.R.R.Co.	Deed	June 17,1859	Office of Secretary	3142	See Note 1
3	Roger Pigram	N.& W.R.R.Co.	Deed	Nov.4,1857	Office of Secretary	3143	See Note 1
4	W.L.Washington	N.C.& St.L.Ry.	Deed	Feb.23,1910	DB Q-147-Q-148-Feb.24,1910	1599	
5	J.M.Pegram	N.C.& St.L.Ry.	Deed	Oct.4,1898	DB B-455-Oct.15,1898	1921	
6	R.W.Pegram	N.C.& St.L.Ry.	Deed	Nov.15,1859	DB H-259-Nov.15,1859	1920	
7	Benj.Woodward	N.& W.R.R.Co.	Deed	June 17,1859	Office of Secretary	3144	
8	Ollie Woodward	N.C.& St.L.Ry.	Deed	Oct.12,1859	DB B-281-Oct.30,1899	1776	
9	Benj.Woodward	N.C.& St.L.Ry.	Deed	Oct.13,1859	DB H-280-Oct.30,1869	1779	

NOTE 1- Deed provides for such additional right of way as may be required for the full and convenient construction, use and maintenance of the railroad.

Road was built by the Nashville and Northwestern Railroad Company. See Minute Book W,page 455 of the Chancery records at Nashville for decree confirming sale to the Nashville and Chattanooga Railroad Company, whose name was later changed to the Nashville,Chattanooga & St.Louis Railway.

RIGHT-OF-WAY AND TRACK MAP

NASHVILLE, CHATTANOOGA AND ST. LOUIS RY.

NASHVILLE DIVISION

STATION 901+08 TO STATION 1006+60

SCALE, 1 IN. 200 FT. JUNE 30, 1916.

Sheet No. 3 of 37 Sheets of Nashville Div. Maps, Line, Stations 1818+00 to 1925+00 Inc.

OFFICE OF CHIEF ENGINEER NASHVILLE, TENN.

M.P. 18.6 to 20.6

011-001

DAVIDSON CO. - CHEATHAM CO.

PEGRAM