NO.	GRANTOR	GRANTEE	INSTRUMENT	DATE	RECORD	DEED NO.	REMARKS
1	Wm. Greer	N.& N.W.R.R.Co.	Deed	Aug.15,1853	Office of Secretary	3149	See Note 1
	Wm. Greer	N.& N.W.R.R.Co.	Deed	Feb.13,1861	Office of Secretary	3149	See Note 1
2	Isaac Jones	N.& N.W.R.R.Co.	Deed	Dec.13,1854	Office of Secretary	3151	See Note 1
3	Dennis W.Dunn	N.& N.W.R.R.Co.	Deed	Dec.13,1854	Office of Secretary	3152	See Note 1
4	Preston R.Atkisson	N.& N.W.R.R.Co.	Deed	Dec.13,1858	Office of Secretary	3153	See Note 1
5	Isaac Jones	N.& N.W.R.R.Co.	Deed	Aug.15,1853	Office of Secretary	3154	See Note 1

NOTE 1- Deed provides for such additional right of way as may be required for the full and convenient construction, use and maintenance of the railroad.

Road was built by the Nashville and Northwestern Railroad Company.See Minute Book W, page 485 of the Chancery records at Nashville for decree confirming sale to the Nashville and Chattanooga Railroad Company, whose name was later changed to the Nashville,Chattanooga & St.Louis Railway.

6	J.W.Greer et ux. W.P.Greer	N.C.& St.L.Ry.	Deed	Sept.8, 1922	Office of Secretary	3840	See Par.10, Map 10.
7	W.T. Beck et ux	N.C.& St.L.Ry.	Deed	Mar.4, 1922	Office of Secretary	3838	
8	A.C.Dunn et ux	N.C.& St.L.Ry.	Deed	Mar.4, 1922	Office of Secretary	3837	
9	G.A. Lampley et ux	N.C.& St.L.Ry.	Deed	Mar.4, 1922	Office of Secretary	3836	
10	W.T. Liles	N.C.& St.L.Ry.	Deed	Mar.4, 1922	Office of Secretary	3835	
11	M.L. Moore et ux	N.C.& St.L.Ry.	Deed	Mar.6, 1922	Office of Secretary	3834	

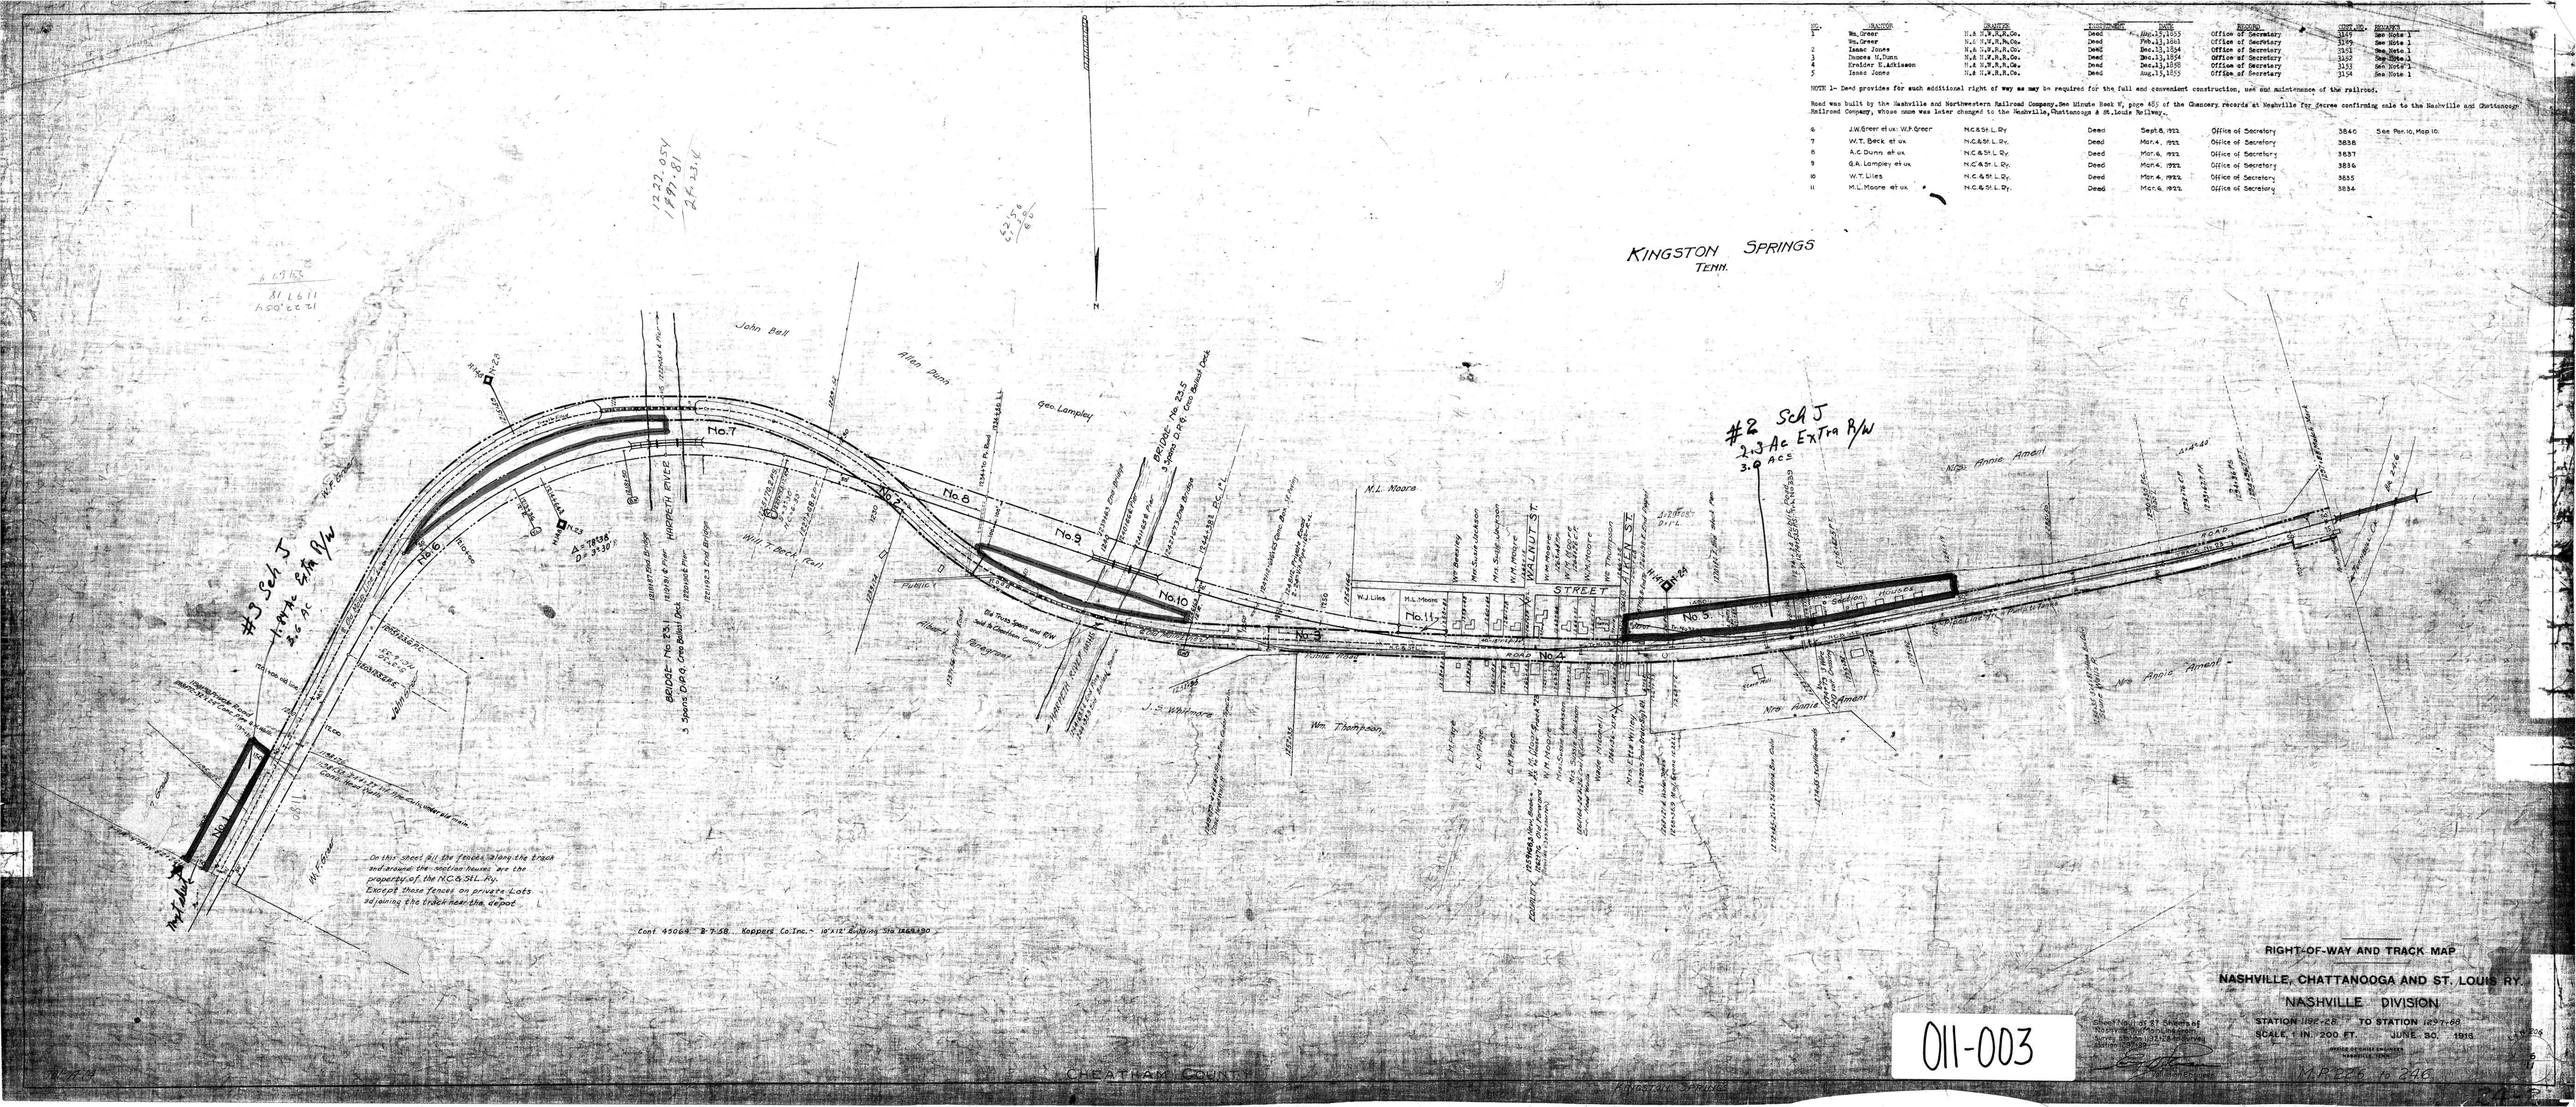

On this sheet all the fences along the track and around the station-houses are the property of the N.C.& St.L. Ry.
Except those fences on private Lots adjoining the track near the depot

RIGHT-OF-WAY AND TRACK MAP

NASHVILLE, CHATTANOOGA AND ST. LOUIS RY.

NASHVILLE DIVISION

STATION 1197+68 TO STATION 1297+68

SCALE, 1 IN. 200 FT. JUNE 30, 1916

Office No. 1 of 31 Sheets of Nashville Division Right-of-Way and Track Map

Nashville Division

011-003

CHEATHAM COUNTY

KINGSTON SPRINGS

MAPS 6 to 296