A.F.E. No.	DATE COMP.	DESCRIPTION OF CHANGE
29378	7-1-42	Ret. of trs. #12. No. TO trs. #11 moved to 24+19. So. TO trs. #11 moved to 33+25.1374' trs. #11 ret. Pres. L-911'
35522	11-15-45	Sale of pt par 7 & 8
38966	9-3-49	Sale of pt par 7 & 8 Ret. RW
43870	6-5-53	Sale of part par. 4 SCHB 5, C-516, for $250.00, to SHAWANEE COMMUNITY CLUB
"	9-15-53	Retirement of Depot & Shawanee Country Club property
60302	10-28-65	Requirement of par. no. 14

Parcel No.	Grantor	Grantee	Deed No.	Date	Recorded in D.B.	Page	Remarks
14	Robert Clements	L&N Railroad	14926	10-28-65			

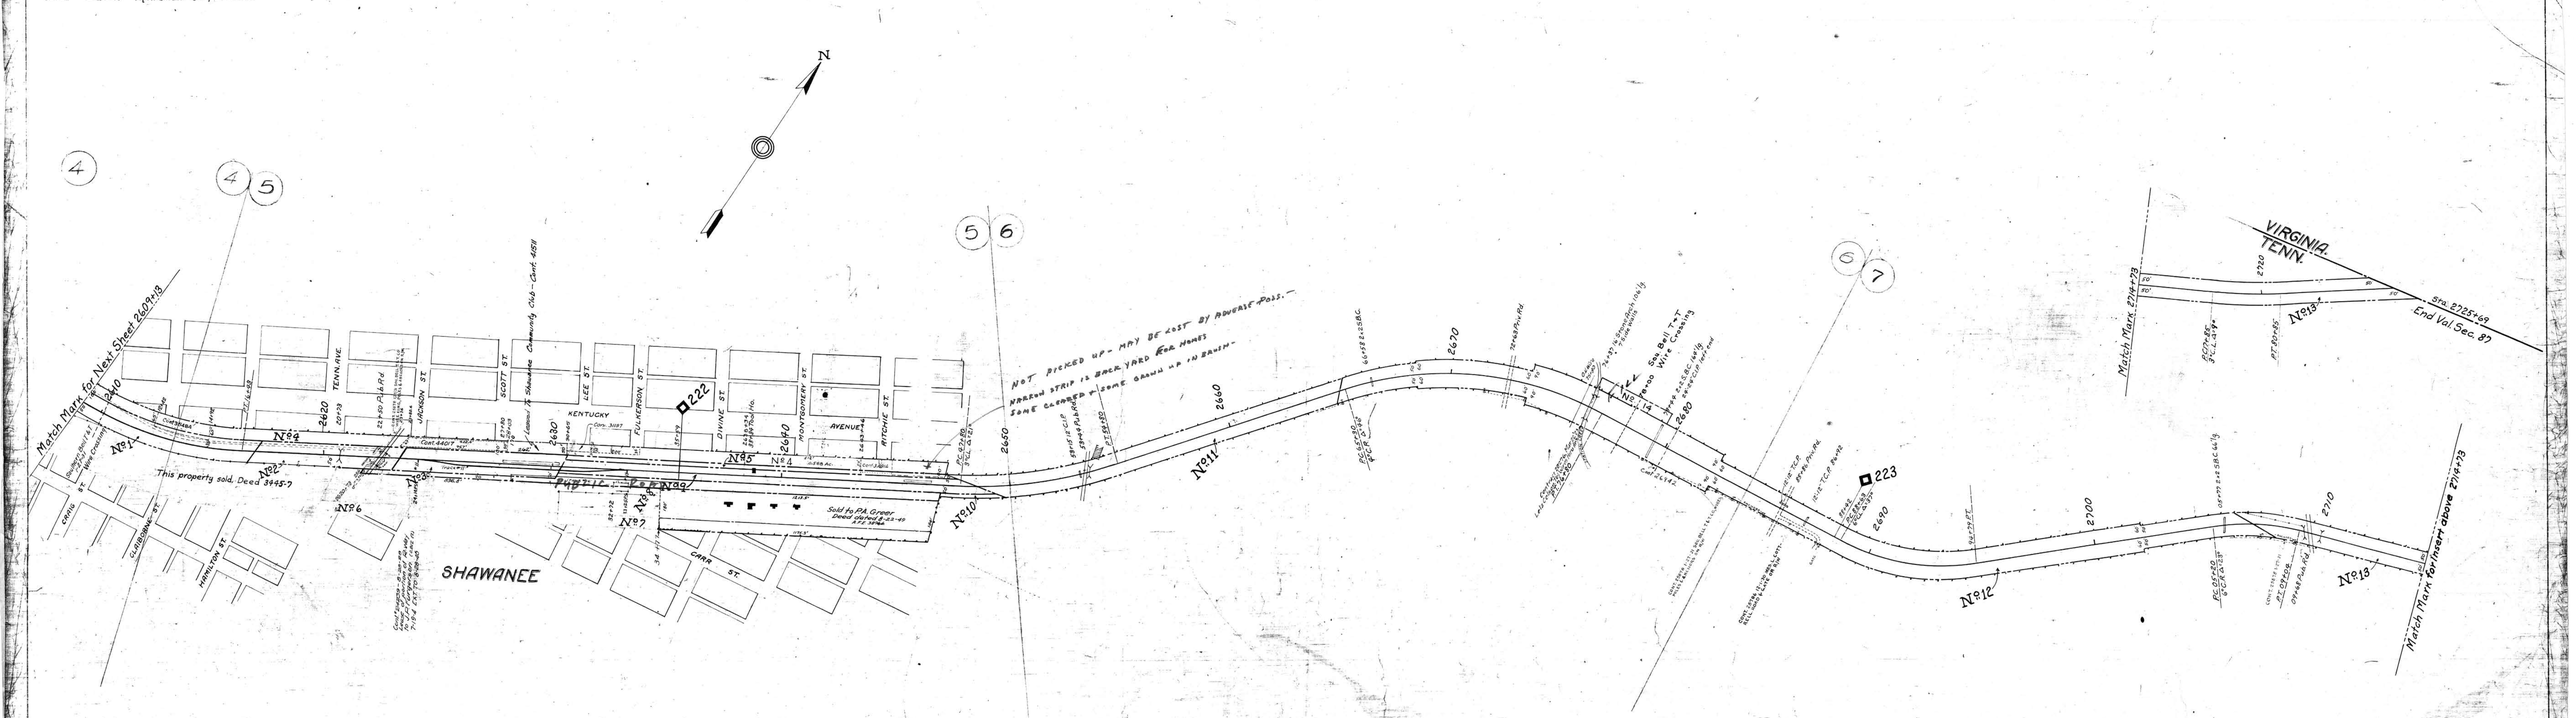

~~Cont. 29989 3-3-38 Bud Brown lease 33×200' 45' left & main 2631+36 to 2633+18~~ 5-16-40 Trans. to J.H. Ferguson ~~Cont. 1-1-43 Trans. 8-29-53 Cecil Bolton Trans. 8-28-61 to R.M. Foerster~~ CANG

~~Cont. 31173 1-10-39 R.H. Fergusson lease 33×200' 45' left & main 2633+18 to 2635+18~~ 5-16-40 Trans. to Cecil Bolton 8-20-68 to R.M. Foerster Canc.

"	32799	5-15-42	Warren D. Fawbush - Lease of section No. #168 at Shawnee
"		6-11-42	Luther Brooks - Lease of section No. #166 at Shawnee
"	32843	8-6-42	~~J.C. Davis Lease of pt par. 4 & 5 SCHB 5-17-206 - Trans. to John L. Schooler 10-11-51~~ Canc. 2-8-54
"	33150	4-15-43	~~R. Marcum Lease of land 33' to left 60' 2219+41 to 2214+42 to 2214+92~~ Canc.
	33505	4-12-43	~~Sue Bolton lease of land 33' to left 60' 2222+44 to 2219+44~~ Canc. 5-12-46.
Deed 3445		9-30-43	P.A. Greer sale of pt par 7 & 8
Cont. 29980		3-31-44	J.K.C. Ferguson lease of 35' land 2633+76 to 2636+126 - Trans. 4-3-59 Cecil Bolton
"	33150	6-8-44	~~Opal Bolton lease of 8996 sqrs from 2242' left 60' Cancelled 5-12-46.~~
"	34814	6-8-45	Ed Graves Lease of a (34×60) Tract of land 55' N. of R.H.T. Bldg 2643+45 to 2644+80 Memo 7-26-51 Trans. To Sam Walton
"	35484	9-22-45	Millard Harber - Lease of ROW 34' 2414+42 to 2414+90.
LF 6328		1-27-31	Southern Bell T. & T. Wire Crossing 273 ft. South Old MP. 221
" 40585	" 37129	2-8-49	Will Stanley 2 Tracts of Land on N.W. on S. side of trks Sta. 2634+17.6 to 36+82 & Sta. 41+32 to 43+32 (Conc.)
" 24177	" 26342	4-23-53	Sou. Bell T.&T. Co. Wire over Sta 73+00
" 24177	" 26342	1-22-55	86+06
" 27180	" 41911	7-8-54	Shawanee Community Club Lease of a 0.30 Acre Tract of Land. Canc. 7-7-64
			~~Trans. to Cecil Bolton 8-3-59~~ Trans. to Cecil Bolton 8-28-61 CANG 8-24-68
" 44017		1-3-58	Sam Bullard - Lease of 33' N. of land sta. 2623+36 to 2628+03
51834		2-3-66	E.O. Giles - Lease of Private Crossing

Sheet No. 2 of 2 of Cumberland Valley Division from Survey Station 2609+13 to Survey Station 2725+69

Valuation Engineer

RIGHT OF WAY AND TRACK MAP
LOUISVILLE AND NASHVILLE R.R. CO.
CUMBERLAND VALLEY DIVISION
STATION 2609+13 TO STATION 2725+69
SCALE 1 INCH = 200 FT. JUNE 30 1917
OFFICE OF CHIEF ENGINEER
LOUISVILLE, KY.

V-87 2

013-002

87-2

16-1