A.F.E. No.	Date Comp.	Description of Change
2506	7-23-15	Realign. of Trk. #1
2506C		Relocat. of mine trks. for Bryson Mtn. Coal & Coke Co.
2659		Rem. of portion of trk #25 Sched. by L&N.
2659B		" " " " " " " " " " C.B.C.&C.Co.
2709	10-13-23	Trk. No. 26 removed
2710	10-13-23	Trk. No. 26A removed
854	7-31-21	Recons. of B.N.R.
864	7-31-21	" " " "
874	7-31-21	" " " " 20
876	7-31-21	" " " " 17
20323		Rel. of trk. #30
29870	6-16-42	Rel. 653' Trk. #1, End of Sta. 424+00

Nr.	Grantor	Grantee	Inst.	Date	Record	Cust. No.	Remarks
2A	Amer. Assoc. Inc.	L.&N.R.R.	Cont.	7-29-27	D.B.50 P.475-81 K.S. Oct. 11, 1927	2982	
2B	Conveyed with Par. 2A						

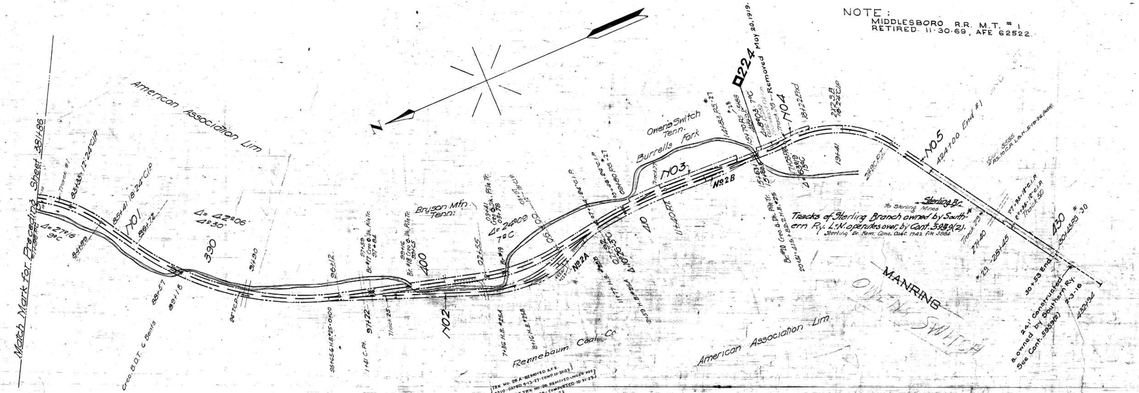

Cont. 4853 7-2-41 Remnebaum Coal Co. Cont. trk. #25-25A & 25B Under Form 1066 Rev. 4-27-51 Trans. to American Association Inc. Memo. 7-12-55 Uses Rgnt. Mings Mason Fuel Co. Envr. 12-27-54 Canc.
~~4852 10-30-41 Remnebaum Coal Co. Const. Mine Trk. #33 Canc.~~
~~4452 2-27-41 Lynch Jellico Coal Co. Abandonment of trk. #33, 33A & 33B~~ Canc. 4-13-45

RIGHT OF WAY AND TRACK MAP
LOUISVILLE AND NASHVILLE R. R. CO.
CUMBERLAND VALLEY DIVISION
MIDDLESBOROUGH RAILROAD
STATION 381-86 TO STATION 432-94
SCALE: 1 INCH = 200 FT. JUNE 30 1957.

SHEET NO. 2 OF 2 CUMBERLAND VALLEY DIVISION MIDDLESBOROUGH RAILROAD FROM SURVEY STATION 381+86 TO SURVEY STATION 432+94

OFFICE OF CHIEF ENGINEER
LOUISVILLE, KY.

VALUATION ENGINEER

38-2

CLAIBORNE CO., TENN.

013-004

V.89