NO.	GRANTOR	GRANTEE	INSTRUMENT	DATE	RECORD	SERIT.NO.	REMARKS
1			None				See Note 1
2	L.D.Hickerson	McMinn.& Wm. R.R.Co.	Deed	Jan. 13, 1876	DB P-52-Jan.17,1876	964	

Note 1- Charter width claimed under decisions of Tennessee Courts

The road from Tullahoma to McMinnville, a distance of 35 miles, was constructed by the McMinnville and Manchester R.R.Co.about the year 1856. Under a Chancery decree dated July 1o,1875 this road was sold to the Memphis and Charleston R.R.Co. On July 28, 1877, the Memphis and Charleston R.R.Co. sold the road to the Nashville,Chattanooga & St.Louis Railway.

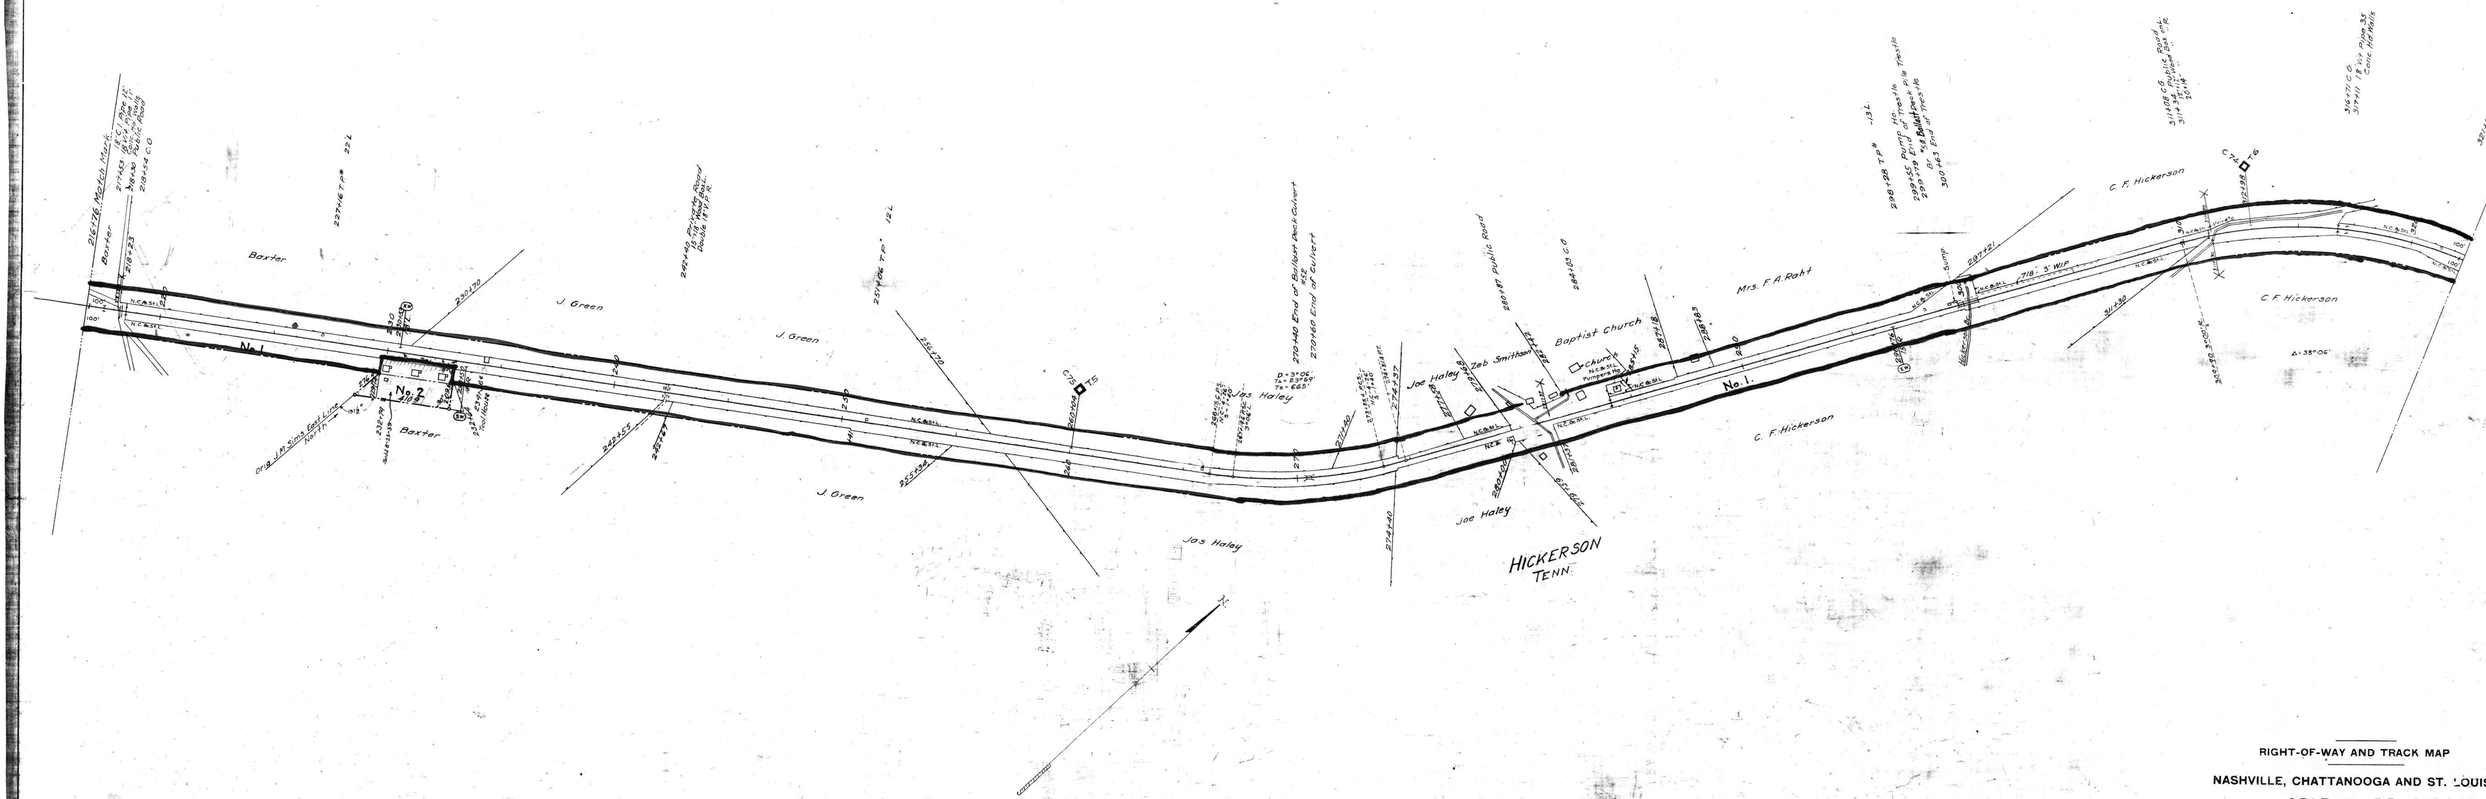

RIGHT-OF-WAY AND TRACK MAP

NASHVILLE, CHATTANOOGA AND ST. LOUIS RY.

SPARTA BRANCH

STATION 216+76 TO STATION 322+36

SCALE, 1 IN.=200 FT. JUNE 30, 1916

OFFICE OF CHIEF ENGINEER
NASHVILLE, TENN.

M.P. 4.2 to 6.2

Sheet No. 3 of 44 Sheets of Sparta Branch from survey station 216+76 to survey station 322+36

Assistant Engineer

016-003

707-A-3

Coffee Co. Tenn.

HICKERSON

20-3