A.F.E. 51722 9-18-59 Sale Land to Robert S. Swann Deed # 14472
58294 2-14-61 Sale of land U.S. 4 Sta. 47 to 50+57 Rt. 9

NO.	GRANTOR	GRANTEE	INSTRUMENT	DATE	RECORD	CONT. NO.	REMARKS
1			None				See Note 1

Note 1- Charter width claimed under decisions of Tennessee Courts.

The road from Tullahoma to McMinnville, a distance of 35 miles, was constructed by the McMinnville and Manchester R.R.Co. about the year 1856. Under a Chancery decree dated July 10,1875 this road was sold to the Memphis and Charleston R.R.Co. On July 28, 1877 the Memphis and Charleston R.R.Co. sold the road to the Nashville, Chattanooga & St. Louis Railway.

Pt.1	L.&N.R.R.Co.	J.W.Shelton et.ux.	Deed	March 7,1958		14417	Quit claim.

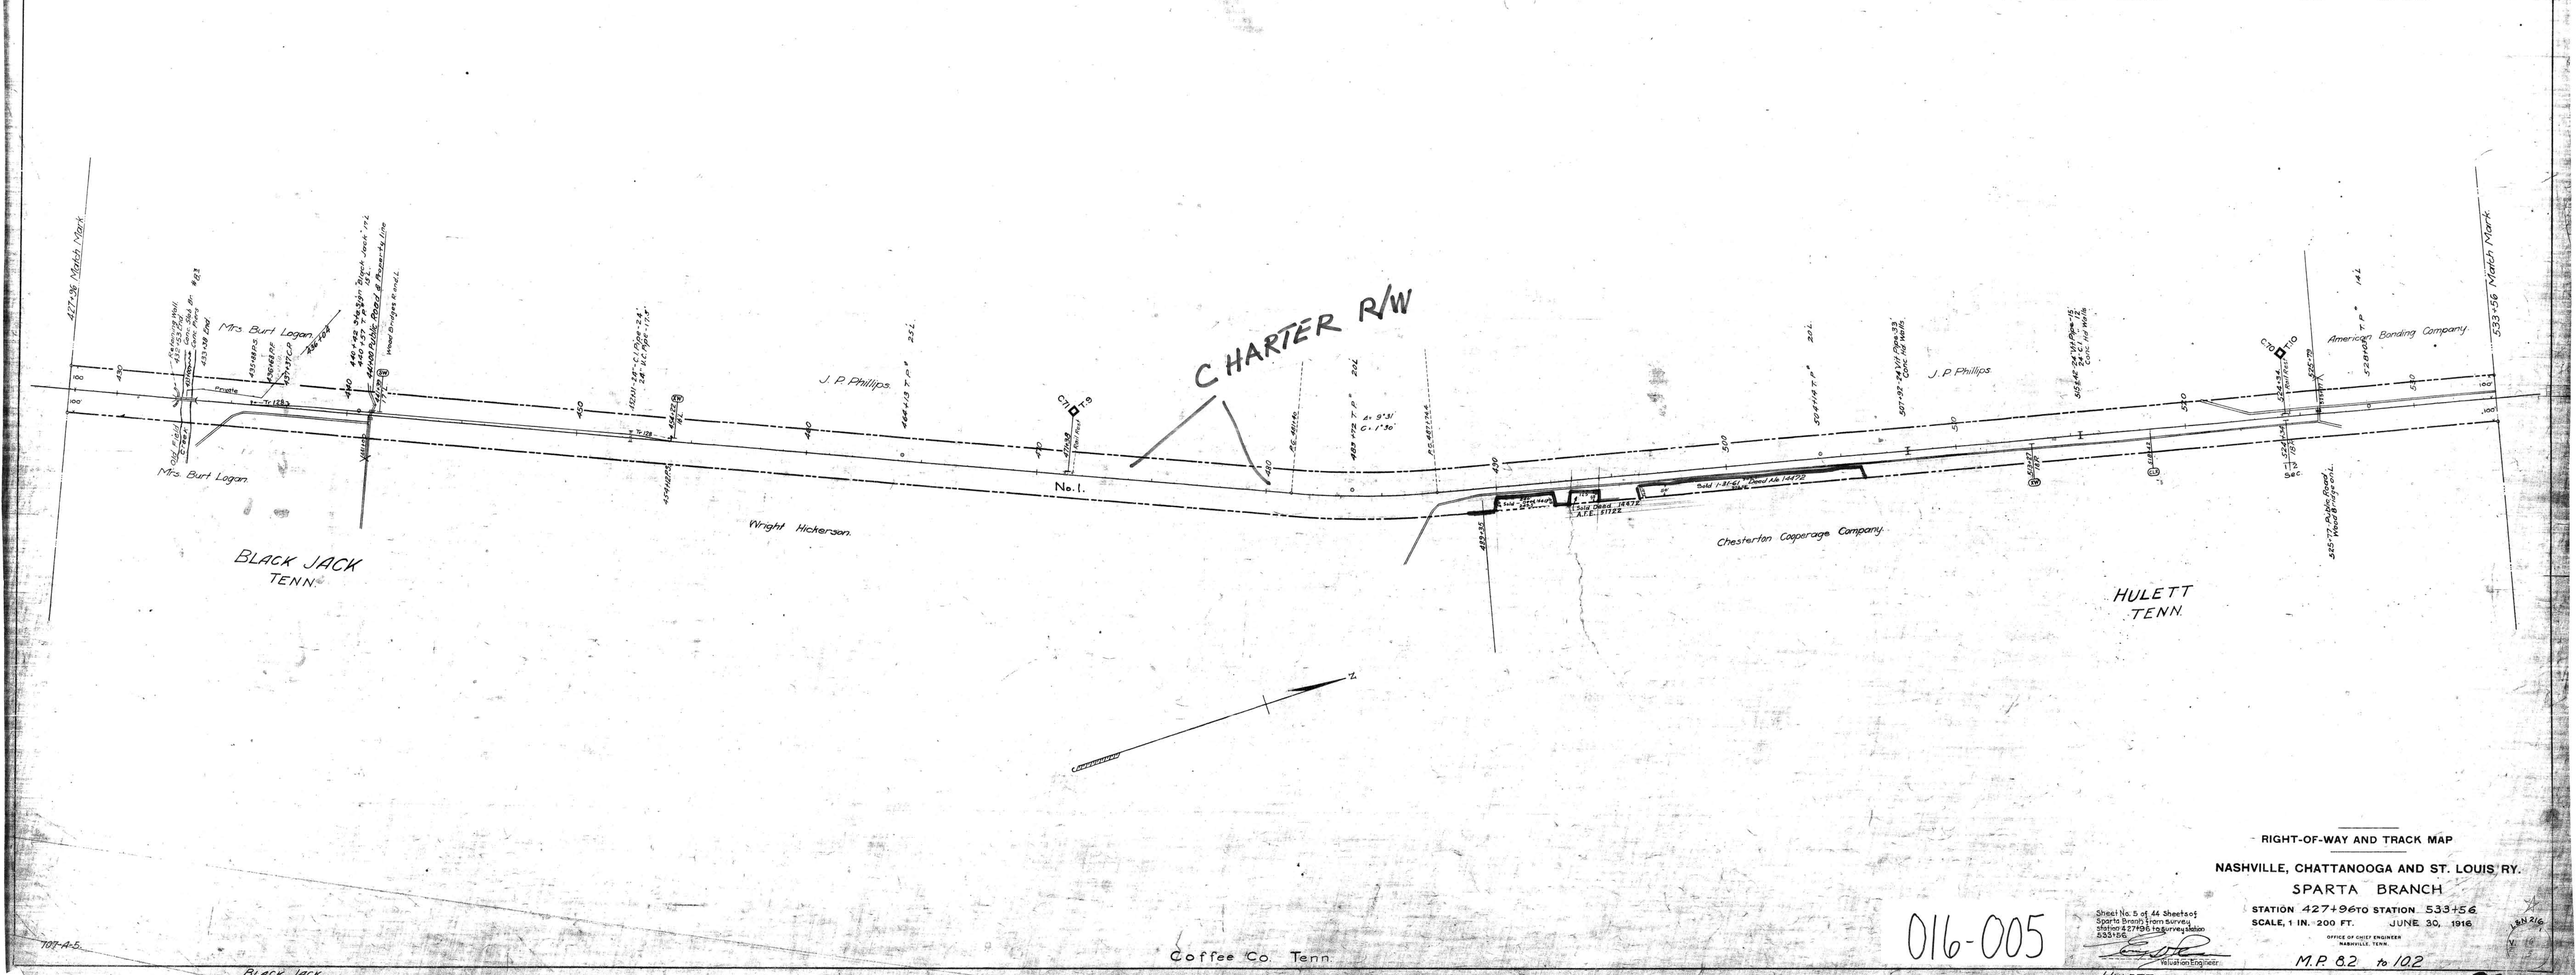

RIGHT-OF-WAY AND TRACK MAP

NASHVILLE, CHATTANOOGA AND ST. LOUIS RY.

SPARTA BRANCH

STATION 427+96 TO STATION 533+56

SCALE, 1 IN. 200 FT. JUNE 30, 1916

OFFICE OF CHIEF ENGINEER
NASHVILLE, TENN.

M.P. 8.2 to 10.2

016-005

Sheet No. 5 of 44 Sheets of Sparta Branch from survey station 427+96 to survey station 533+56.

Valuation Engineer

20-3