A.F.E. No.	Date Comp.	Description
41194	10-23-57	Date of Part of Parcel NEZ

NO.	GRANTOR	GRANTEE	CONSIDERATION	DATE	RECORD	CERT. NO.	REMARKS
1			None				See Note 1
2	Geo. Waite	McMinn. & Manchester R.R.Co.	Deed	Apr. 3, 1855	DB M-312-Dec.17,1855	969	
3			None				See Note 1

Note 1- Charter width claimed under decisions of Tennessee Courts.

The road from Tullahoma to McMinnville, a distance of 35 miles, was constructed by the McMinnville and Manchester R.R.Co.about the year 1856. Under a Chancery decree dated July 10,1875 this road was sold to the Memphis and Charleston R.R.Co. On July 28, 1877 the Memphis and Charleston R.R.Co. sold the road to the Nashville, Chattanooga & St.Louis Railway.

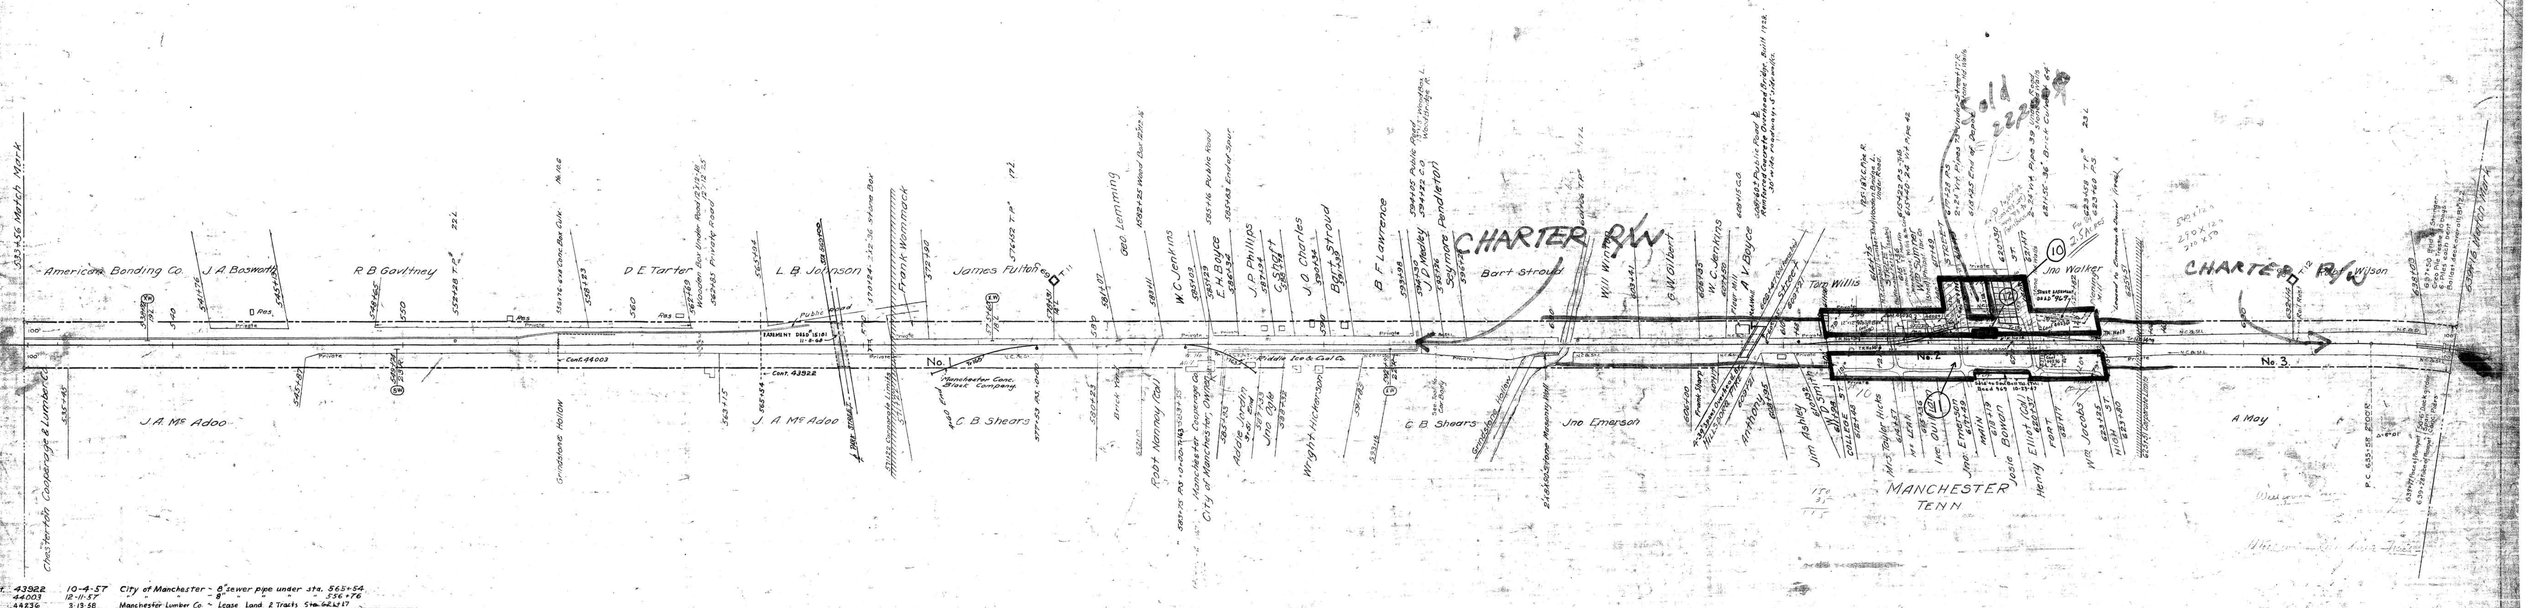

RIGHT-OF-WAY AND TRACK MAP

NASHVILLE, CHATTANOOGA AND ST. LOUIS RY.

SPARTA BRANCH

STATION 533+56 TO STATION 639+16

SCALE, 1 IN. = 200 FT. JUNE 30, 1916

OFFICE OF CHIEF ENGINEER
NASHVILLE, TENN.

Sheet No. 6 of 44 Sheets of Sparta Branch from Survey Station 533+56 to Survey Station 639+16

Station Engineer

M.P. 102 to 121

016-006

707-A.E.

Coffee Co. Tenn.

MANCHESTER