F.E.	Date Comp.	Description of Change
1272	3-7-45	Const trk. No. 185

No.	GRANTOR	GRANTEE	INSTRUMENT	DATE	RECORD	CONT. NO.	REMARKS
1			None				See Note 1

Note 1- Charter width claimed under decisions of Tennessee Courts.

The road from Tullahoma to McMinnville, a distance of 35 miles, was constructed by the McMinnville and Manchester R.R.Co. about the year 1856. Under a Chancery decree dated July 10,1875, this road was sold to the Memphis and Charleston R.R.Co. On July 28,1877 the Memphis and Charleston R.R.Co. sold the road to the Nashville,Chattanooga & St.Louis Railway.

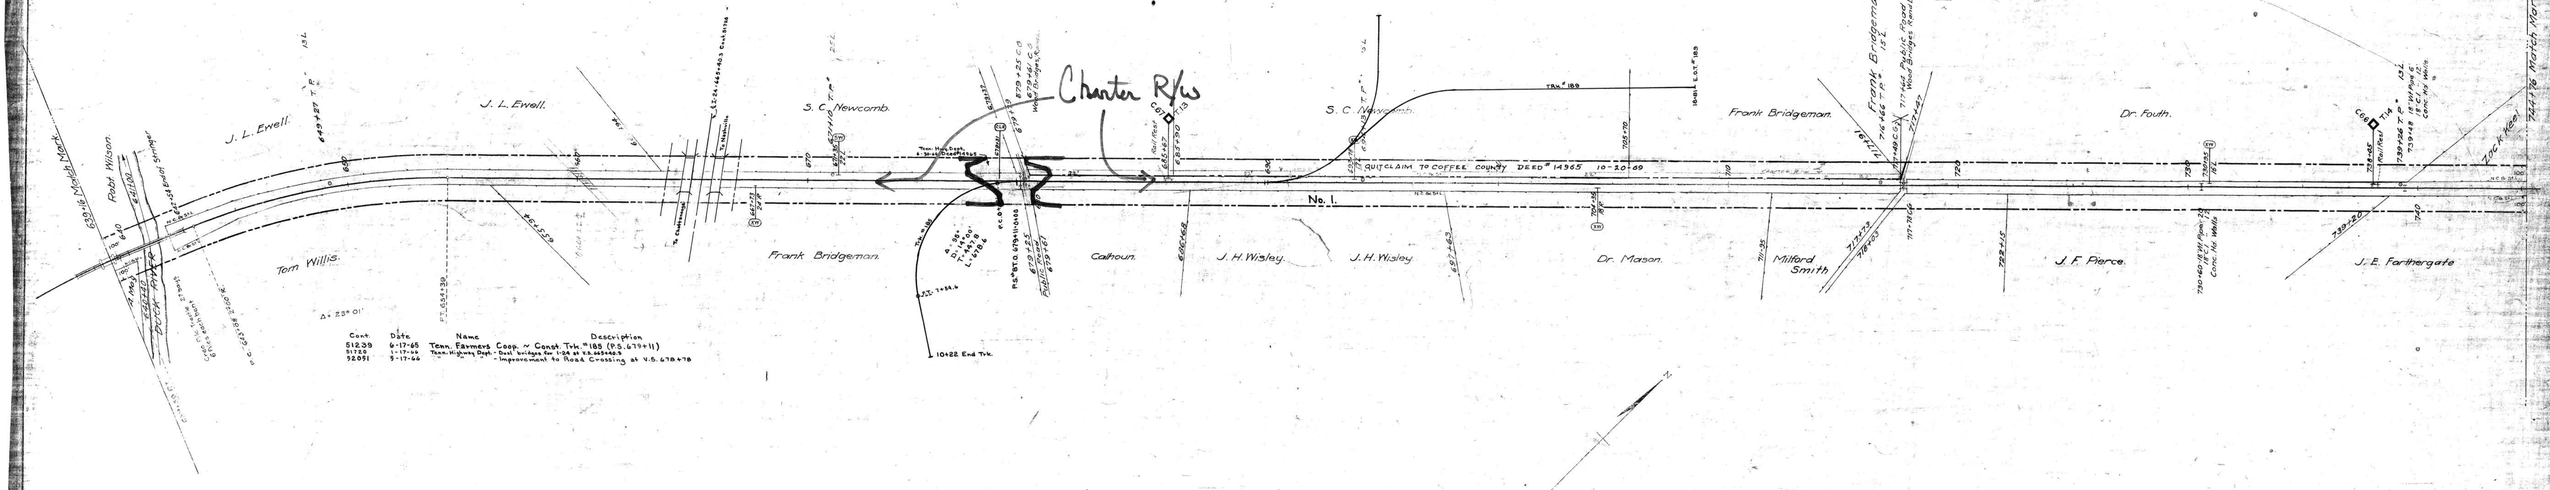

Cont.	Date	Name	Description
512.39	6-17-65	Tenn. Farmers Coop. ~ Const. Trk. #185 (P.S. 679+11)	
51725	1-17-66	Tenn. Highway Dept. - Bent bridge for 1-24 at V.S. 685+63	
52051	5-17-66	- Improvement to Road Crossing at V.S. 678+78	

RIGHT-OF-WAY AND TRACK MAP

NASHVILLE, CHATTANOOGA AND ST. LOUIS RY.

SPARTA BRANCH

STATION 639+16 TO STATION 744+76

SCALE, 1 IN. 200 FT. JUNE 30, 1916

OFFICE OF CHIEF ENGINEER
NASHVILLE, TENN.

Sheet No 7 of 44 Sheets of Sparta Branch from survey Station 639+16 to survey Station 744+76

Division Engineer

M.P. 121 to 141

016-007

707-A-7.

Coffee Co. Tenn.

BH 216
V. 76
7