NO.	GRANTOR	GRANTEE	INSTRUMENT	DATE	RECORD	INST. NO.	REMARKS
1			None				See Note 1

Note 1- Charter width claimed under decisions of Tennessee Courts.

The road from Tullahoma to McMinnville, a distance of 35 miles, was constructed by the McMinnville and Manchester R.R.Co. about the year 1856. Under a Chancery decree dated July 10,1875 this road was sold to the Memphis and Charleston R.R.Co. On July 28, 1877 the Memphis and Charleston R.R.Co. sold the road to the Nashville,Chattanooga & St.Louis Railway.

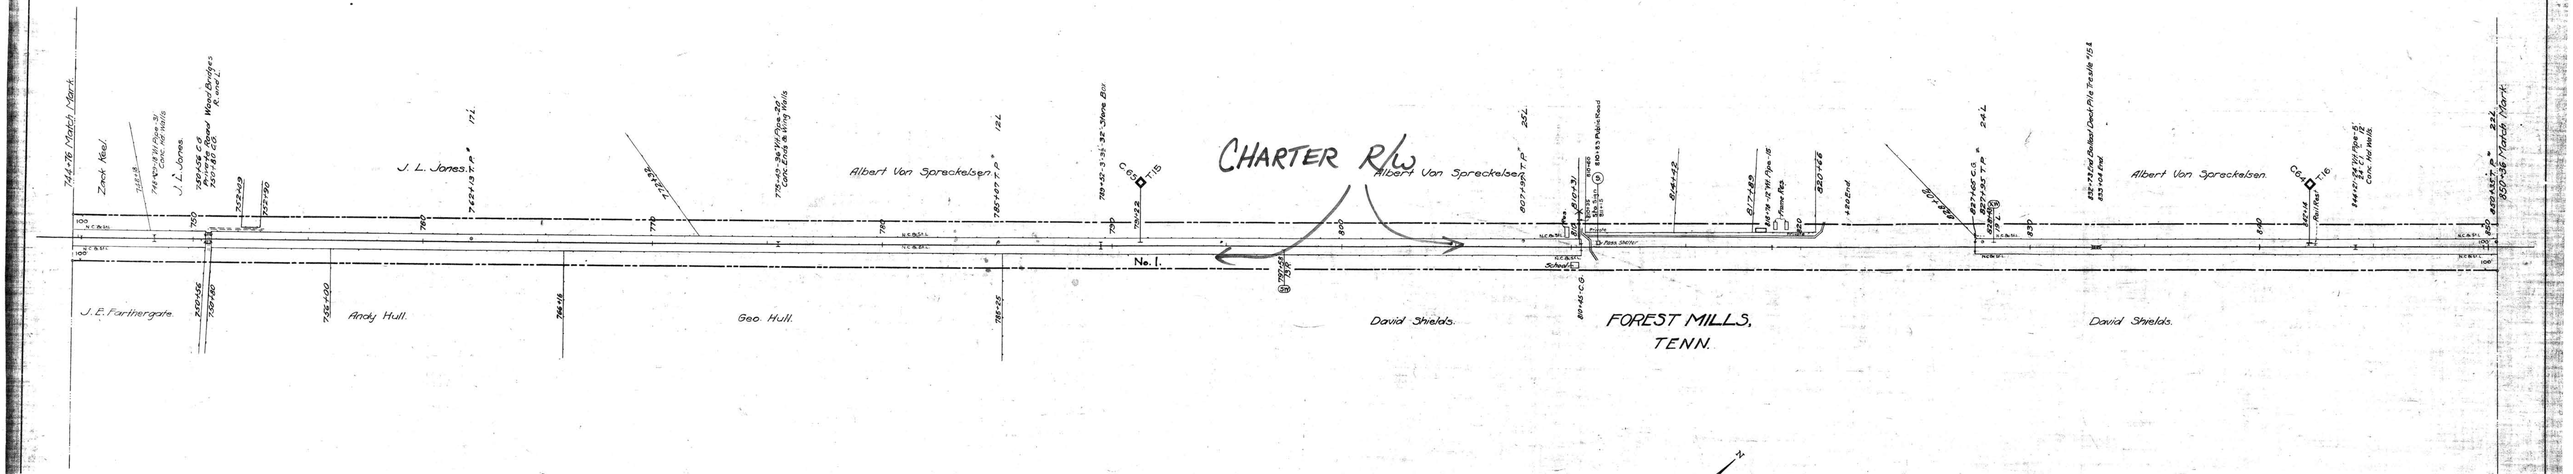

RIGHT-OF-WAY AND TRACK MAP

NASHVILLE, CHATTANOOGA AND ST. LOUIS RY.

SPARTA BRANCH

STATION 744+76 TO STATION 850+36

SCALE, 1 IN. 200 FT. JUNE 30, 1916

OFFICE OF CHIEF ENGINEER
NASHVILLE, TENN.

M.P. 141 to 16.2

Sheet No. 8 of 44 Sheets of Sparta Branch from survey station 744+76 to survey station 850+36.

Valuation Engineer

016-008

707-A-8.

Coffee Co. Tenn.

FOREST MILLS

203