NO.	GRANTOR	GRANTEE	INSTRUMENT	DATE	RECORD	CONT. NO.	REMARKS.
1			None				See Note 1

Note 1- Charter width claimed under decisions of Tennessee Courts.

The road from Tullahoma to McMinnville, a distance of 35 miles, was constructed by the McMinnville and Manchester R.R.Co.about the year 1856. Under a Chancery decree dated July 10,1875 this road was sold to the Memphis and Charleston R.R.Co. On July 28, 1877 the Memphis and Charleston R.R.Co. sold the road to the Nashville,Chattanooga & St.Louis Railway.

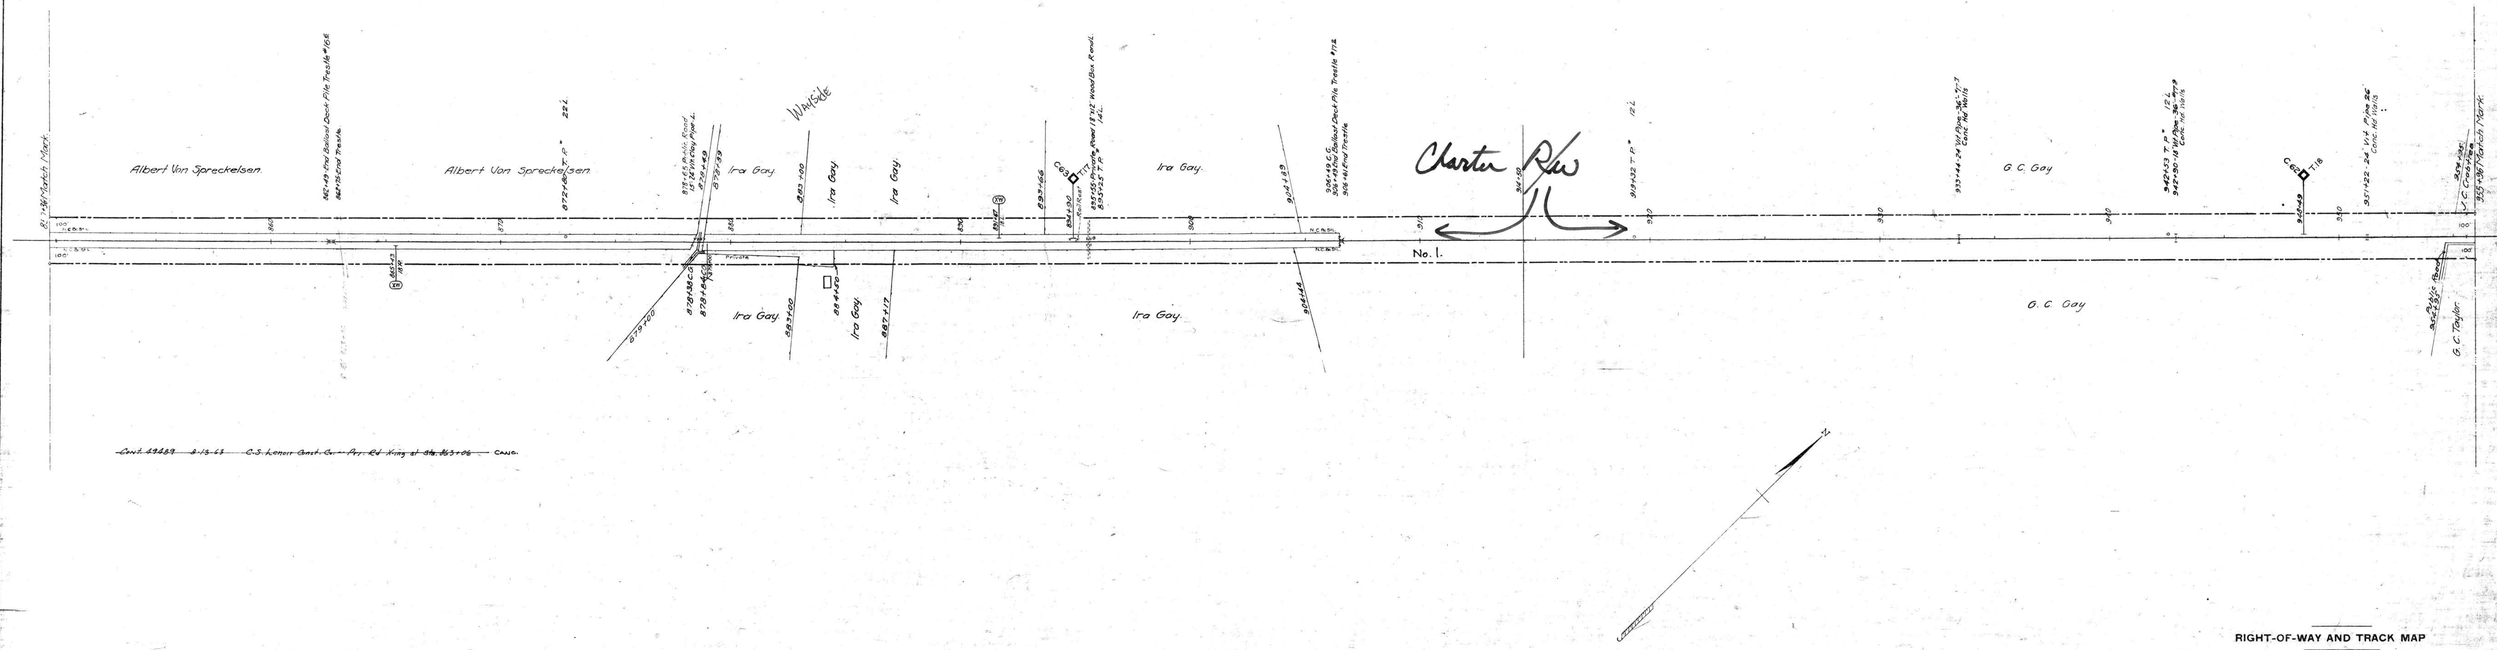

Coffee Co. Tenn.

RIGHT-OF-WAY AND TRACK MAP

NASHVILLE, CHATTANOOGA AND ST. LOUIS RY.

SPARTA BRANCH

STATION 850+36 TO STATION 955+96

SCALE, 1 IN. 200 FT. JUNE 30, 1916

OFFICE OF CHIEF ENGINEER NASHVILLE, TENN.

M.P. 16.2 to 18.2

016-009

Sheet No. 9 of 44 Sheets of Sparta Branch from Survey Station 850+36 to survey station 955+96

Valuation Engineer

LEN 216

V. 16

20-3