NO.	GRANTOR	GRANTEE	INSTRUMENT	DATE	RECORD	CONT.NO.	REMARKS
1			None				See Note 1

Note 1- Charter width claimed under decisions of Tennessee Courts.

The road from Tullahoma to McMinnville, a distance of 35 miles, was constructed by the McMinnville and Manchester R.R.Co., about the year 1856. Under a Chancery decree dated July 10,1875 this road was sold to the Memphis and Charleston R.R.Co. On July 28,1877 the Memphis and Charleston R.R.Co. sold the road to the Nashville,Chattanooga & St.Louis Railway.

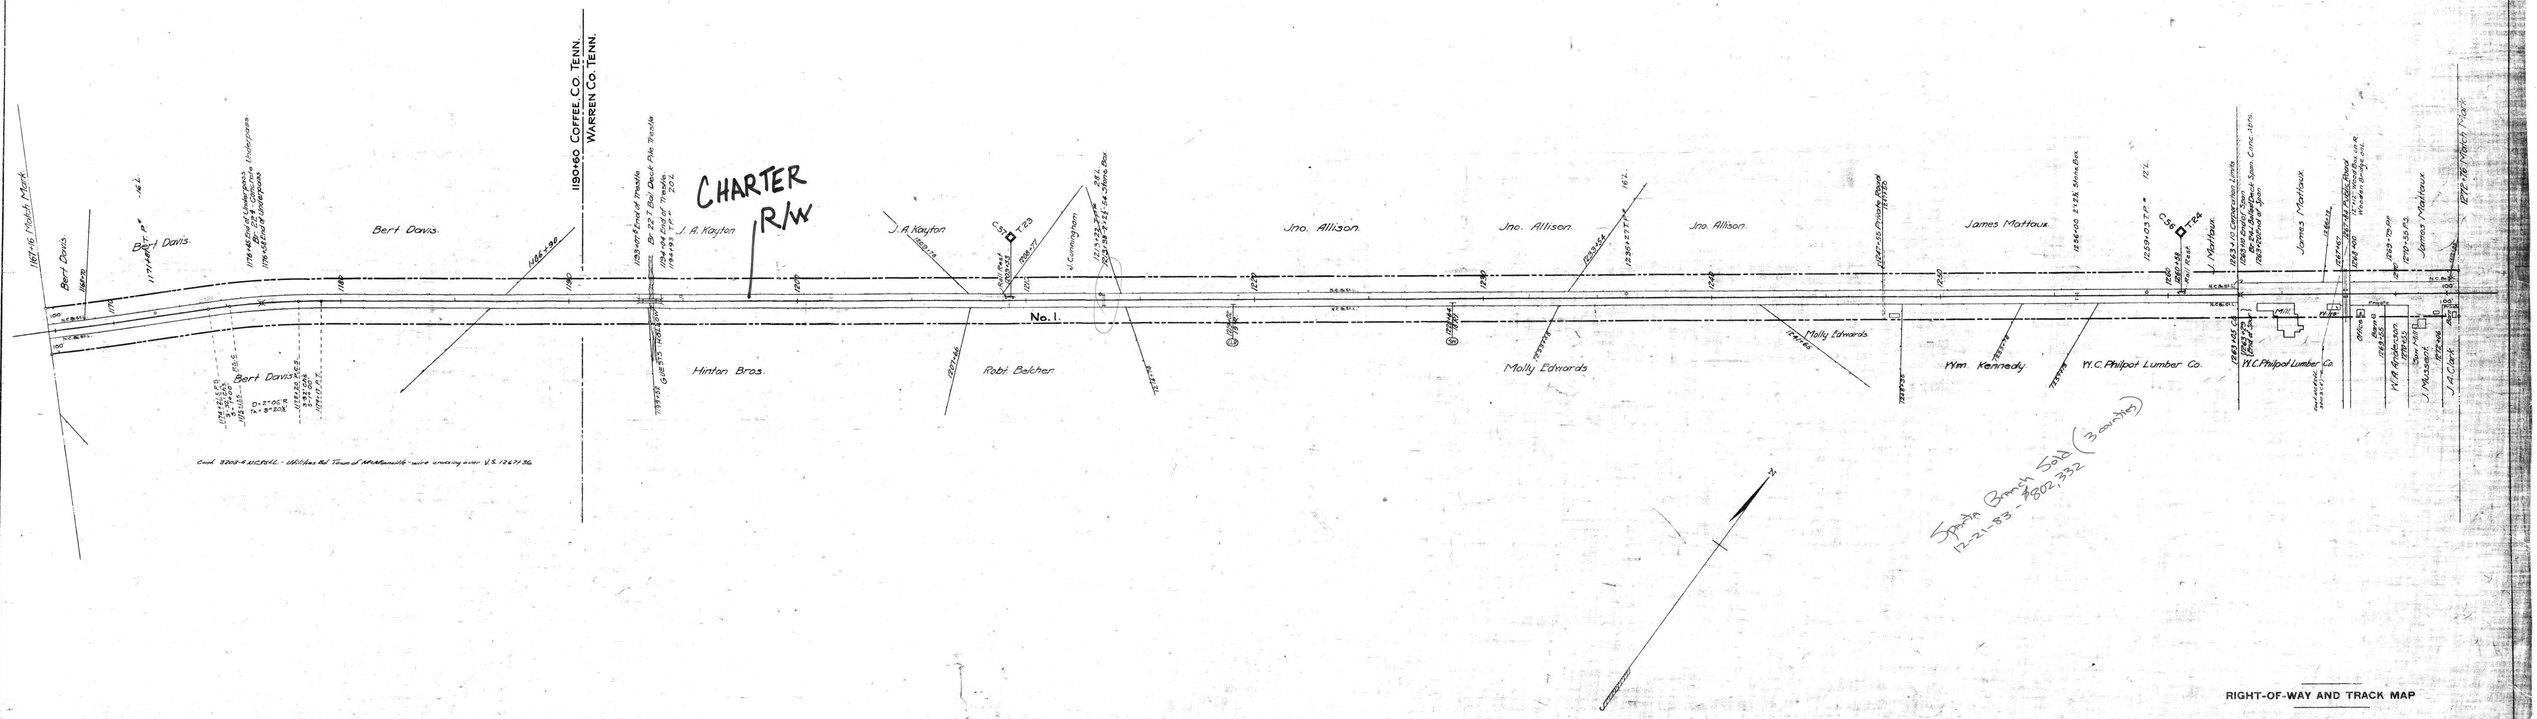

RIGHT-OF-WAY AND TRACK MAP

NASHVILLE, CHATTANOOGA AND ST. LOUIS RY.

SPARTA BRANCH

STATION 1167+16 TO STATION 1272+76

SCALE, 1 IN. 200 FT. JUNE 30, 1916

OFFICE OF CHIEF ENGINEER
NASHVILLE, TENN.

M.P. 22.2 to 24.2

016-012

Sheet No. 12 of 44 Sheets of Sparta Branch from survey station 1167+16 to survey station 1272+76

Valuation Engineer

COFFEE & WARREN COS. TENN.

707-A-12

223