NO.	GRANTOR	GRANTEE	INSTRUMENT	DATE	RECORD	CUST. NO.	REMARKS
6	V. O. BEVILLE	TENN. PROPERTY CO.	DEED	6-18-45	D.B. 1231 - P. 561	4233	
7	" " "	" " "	"	" " "	" " "	"	
8	" " "	" " "	"	" " "	" " "	"	
9	W. G. WEEKY	N.C. & ST. L. RY.	"	4-19-45	" 1903 - " 410	4234	
10	E.W. JORDELYN	" " "	"	4-16-45	" 1916 - " 844	4235	
11	B.H. " " et ux.	" " "	"	" " "	" 1909 - " 510	4236	
13	A.W. MANLEY et ux.	N.C. & ST. L. RY.	"	4-24-45	" 1903 - " 439	4240	
14	W.W. WAITE " "	" " "	"	4-27-45	" 1929 - " 433	4242	
15	ST. CECILIA ACADEMY "	" " "	"	4-23-45	" 1898 - " 472	4243	
16	F. HINDS et ux.	" " "	"	5-9-45	" 1955 - " 478	4251	
17	L. R. RAMSEY et ux.	" " "	"	5-22-45	" " - " 481	4258	
18	Z. A. SIMMONS " "	" " "	"	" " "	" " - " 496	4259	
19	L. R. RAMSEY " "	TENN. PROPERTY CO.	"	5-24-45	" 1914 - " 293	4261	
21	W. M. DUGGAN et ux.	" " "	DEED	6-5-45	" 1920 - " 601	4268	
22	" " "	TENN. PROP. CO.	"	6-14-45	" " - " 787	4269	
23	H. LABATER " "	" " "	"	8-3-45	" 1933 - " 74	4284	
24	Z.R. BERTA et ux.	N.C. & ST. L. RY.	"	10-17-45		4311	
25	E.R. WHITWORTH	" " "	DECREE	3-21-46	" 1338 - " 376		
26	A.C. GRINSLEY et al's.	TENN. PROP. CO.		12-12-45			

EXCHANGE OF EQUAL AREA OF ALLEY # 1184

" " " " " "

EXCHANGE OF PAR. 15, 16, 17, 18 FOR EQUAL AREA OF ALLEY # 1186


PURCHASED FOR BORROW. SOLD IN DEC. 1945 CITY OF NASH. NOT ON MAP.

STYLE OF THIS DEED IS GERTRUDE R. WHITWORTH TRUSTEE TO THE N.C. & ST. L. RY.

NO.	GRANTOR	GRANTEE	INSTRUMENT	DATE	RECORD	CUST. NO.	REMARKS
1	JOS. T. ELLISTON	N. F. N. W. R.R. CO.	CONDEMNATION	1-22-1860	M.B. C.C.-X-499	1771	
"	T. J. HAYS et al's	N.C. & ST. L. RY.	AGREEMENT	5-22-08	D.B. 412-6-MCK. 27, 11	1795	
2	LAVINIA CRAIGHEAD	N. F. N. W. R.R. CO.	CONDEMNATION	10-24-1874	MIN. BK. CC "F"-379	1772	
3	RICHLAND REALTY CO.	N.C. & ST. L. RY.	DEED	1-4-13	D.B. 437-462-1-17-13	1797	
4	" " "	" " "	"	1-4-13	" " " "	"	
5	CHAS. BOSLEY	N. F. N. W. R.R. CO.	"	3-31-1860	OFFICE OF SEC.	1778	NOTE 1

NOTE 1 - DEED PROVIDES FOR SUCH ADD. R. OF W. AS MAY BE REQUIRED FOR THE FULL & CONVENIENT CONST., USE & MAINTENANCE OF THE R.R. ROAD WAS BUILT BY THE N. F. N. W. R.R. CO. SEE M. B. W., PAGE 487 OF THE CHANCERY RECORDS AT NASHVILLE FOR DECREE CONFIRMING SALE TO THE NASH. & CHATTA. R.R. CO., WHOSE NAME WAS LATER CHANGED TO THE N.C. & ST. L. RY.

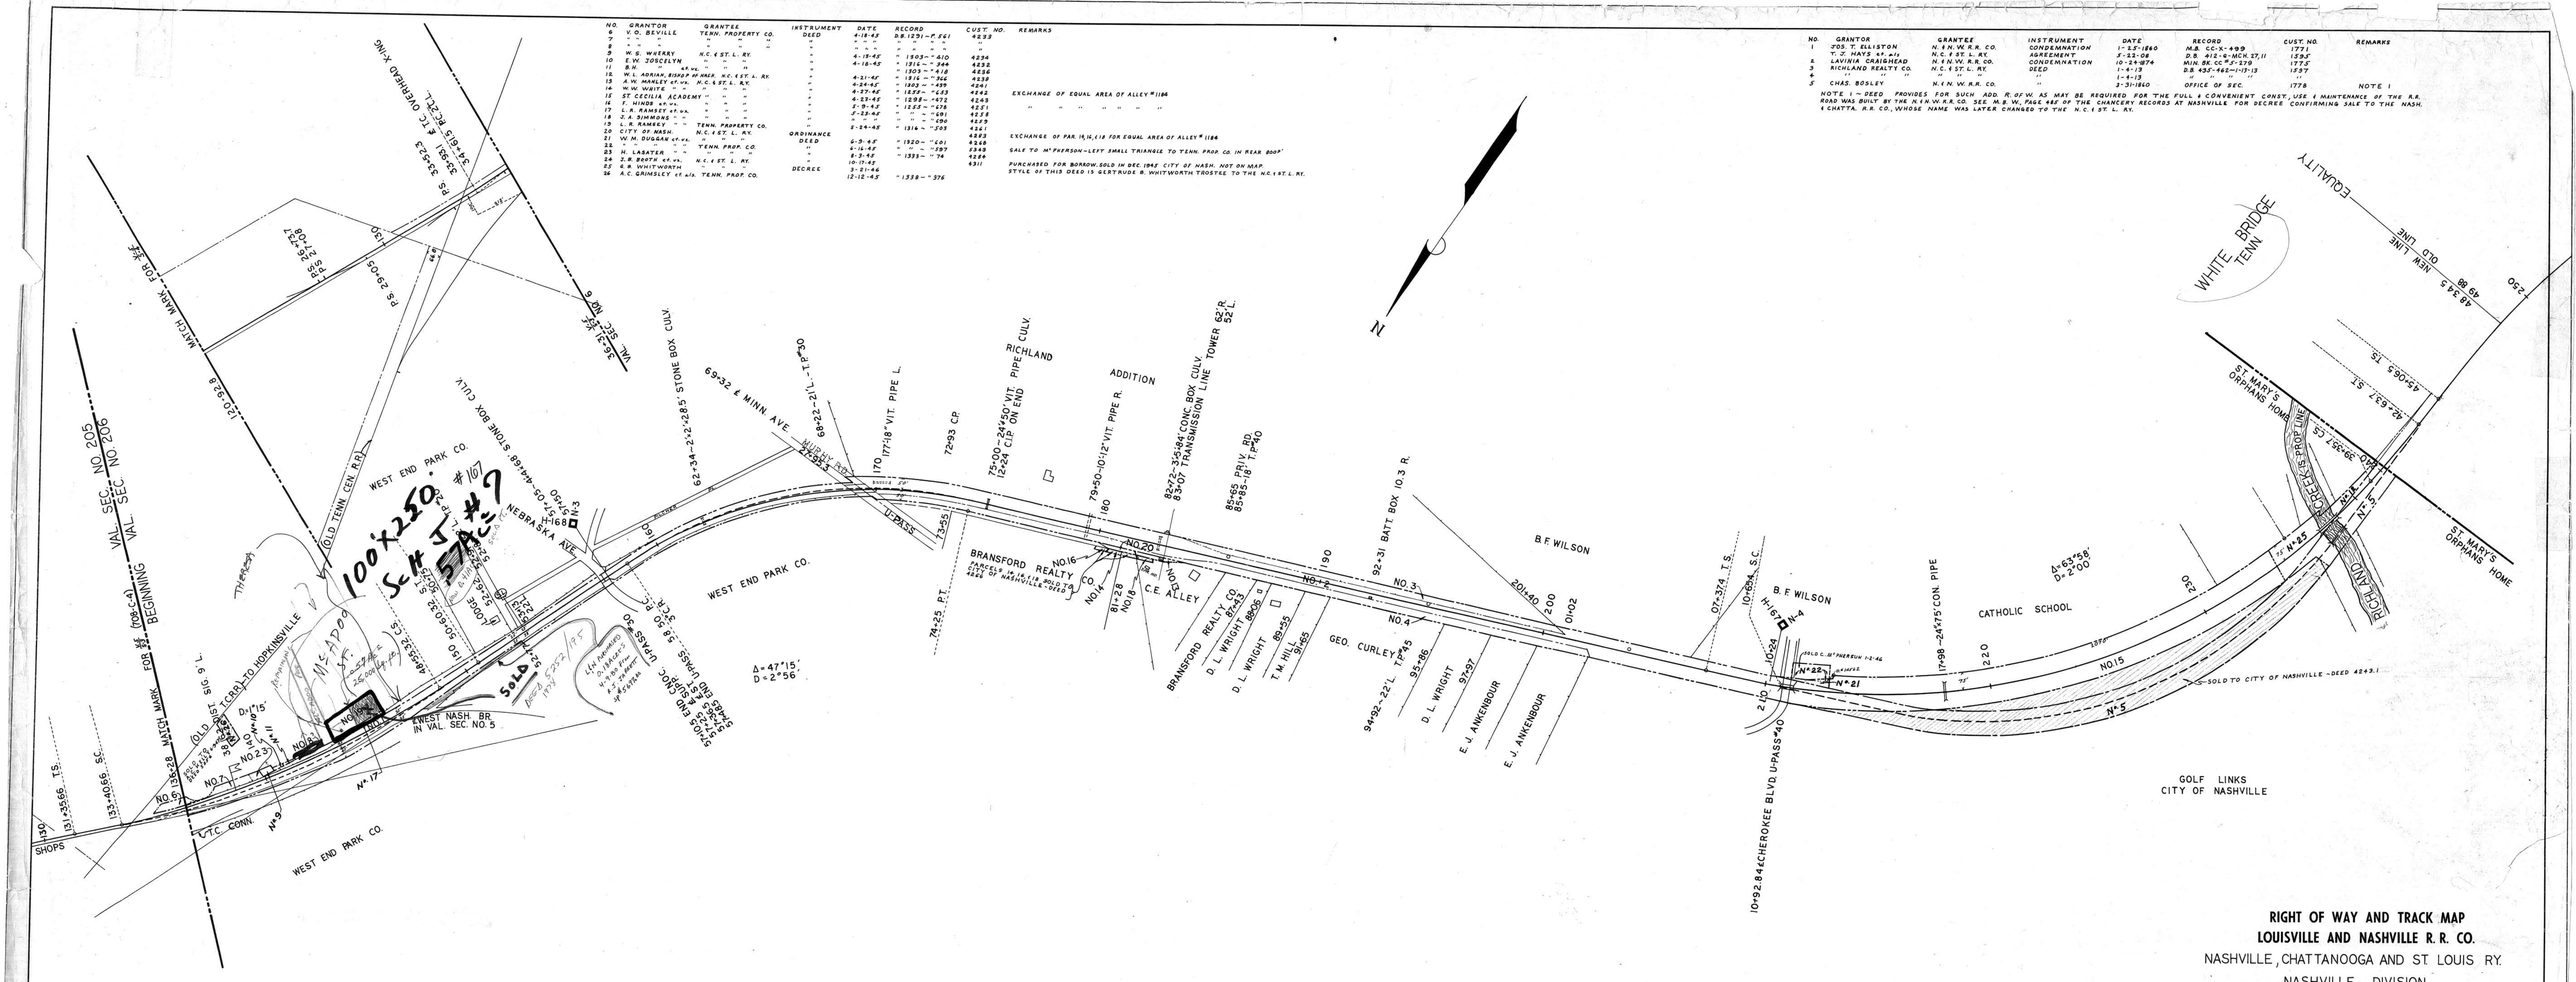

RIGHT OF WAY AND TRACK MAP
LOUISVILLE AND NASHVILLE R. R. CO.
NASHVILLE, CHATTANOOGA AND ST. LOUIS RY.
NASHVILLE DIVISION

REVISED & REDRAWN 6-23-70

STATION - 136+28 TO STATION - 241+88
SCALE 1 INCH = 100 FT.
OFFICE OF CHIEF ENGINEER
LOUISVILLE, KY.
DRAWN BY MRW

VAL. SEC. 206
V6
1

19-010

V6-1

DAVIDSON COUNTY