A.F.E. NO.	DATE COMP.	DESCRIPTION OF CHANGE
17661	40	REM. OF TRK.73 BEYOND STA.2470+83.
21064	12-20-37	REM. OF TRK.73 & PAR.3 TO REVERT.
26623	4-16-40	" " TRKS.76,77,78 & PAR.9,10,11,& 18.
9551	7-18-27	" " 17& 18' OF TRK.78 PT. OF PAR.4 TO REVERT.
13934	3-27-30	" " TRKS.80,81,& PAR.14,17 TO REVERT.
15997	2-23-32	" " 83-A & 83-B, PAR.20,21 & 22 REVERTED.
13128	8-8-17	" " TRK.84 & PAR.8 TO REVERT.
28717	1-1-41	CONST. TRK.166 XOVER 73 TO 79.
59830	9-29-66	Rel. 286 of Trk.78 & Pts. of Trk.s Revert. to Trk.s 73, 84 & 166
61546	7-20-66	Rel. 184 of Trk.s 78 & 166 & Pts. of Trk.s 73, 84 & 166 Reverts
G1500	8-13-68	Const. Trk.178 Sta. 2464+78

CONT.	DATE	DESCRIPTION
4747-8	8-4-33	EAST NASH-WALNUT LBR. CO. COV. LAST 337' OF TRK.73 C&I-BASIS. CANCELLED 4-18-52
5699-1	6-8-01	W.V. DAVIDSON LBR. CO. COV. TRK.79 & 82 OWNED BY L.&N.
7176-1-3	7-17-13	DAVIS CABINET CO. COV. TRK.83, 0+00 TO 9+78 OWNED BY L.&N. 9+78 TO 17+43 END C&I-BASIS.
23320	2-17-28	H.W.Y. COM. COV. TRK.183-C CASH BASIS.
25437	7-25-30	DOLLARD, J.T. SR. COV. TRK.183-D CASH BASIS. Trans. to Cal Varn 4-19-46
11860	5-4-10	DAVIS CABINET CO. TRK.69 & 95-C.P. 88' C.P.-END C&I-BASIS SEE CONT. 7176-4 TRANS.
7176-2-3	4-1-04	" " " " COV. TRK.95 ALL JUNK
21401	7-3-24	NASH. RY. LIGHT & POWER CO. 3#18E OVERHEAD XING. AT 2461+17.2 & 2466+61.7.
22617	6-16-26	TENN. OAK FLOORING CO. 6" WATER LINE UNDER TRK. AT 452+43.5.
24190	9-12-28	NEWMAN CHEEK, TRUSTEE ½ WATER PIPE UNDER TRK. AT 2457+16.
~~33871~~	~~2-15-49~~	~~Harris Storage Co. Lease of 200' of Trk.*74 from Sta. 2482+00 to 2482+105~~ Trans. to Tenn. Beer Co. (Cont. 6-7-57).
~~33891~~	~~2-25-49~~	~~Central Van & Storage Co. Lease 2 car lengths of Trk.*84 (rear) Cancelled - July 15, 1952~~
33891	8-16-49	Central Moving and Storage Co. Lease 1 car length of Trk.*84 (Str.) - Cancelled
Deed 13920	3-14-89	City of Nashville Ordinance Giving Right to Operate Dump Trk.
LF 41828 39416	10-30-51	Nashville Broadcasting Co. Inc. 1" Water Line Under Sta. 2448+54
× 40590 40861	8-14-53	City of Nashville 48" Sanitary Sewer under Sta. 2452+70.3
" 40862	8-14-53	" " " " 48" Sanitary Sewer under Trk.*83 Sta. 2450+5
33871	5-5-56	The Harvey Co. Lease 1 car length of Trk.*79 (Str.) Sta. 2491+70
5699-2	7-13-27	Lamb & Co. - Trk.*79 - User Sterchi Bros. Steers 2-19-31 - Trans. to Charles E. Rutherford & Paris A. Haynes 5-19-66 ~ User Sterchi Bros. 9-20-56
43572	2-14-57	City of Nashville - Wire X-ing over Trk.*85 & *83
43620	5-28-57	" " " " Trk.*83 Sta. 51.82
45122	4-10-58	Dept. Hwys. State Tenn. Overhead Highway Widener 2467.1+13 to 2484.85 over Trk.s *74 & Nam.
46162	4-19-60	City of Nashville - Wire X-ing over Sta. 2447+24.5
50580	9-26-64	Sheiner Lith. Iron & Metal Co. 0.18' Roadway ½ Lease 250 Trk. 74

NO.	GRANTOR	GRANTEE	INST.	DATE	RECORD	CUST. NO.	REMARKS
8	DAVIDSON-BENEDICT CO.	L.&N.R.R.	CONT.	DEC. 15, 41	BK. 1224 P. 125 1-27-42	7716	TO CLEAR TITLE
16	TENN. OAK FLOORING CO	"	"	MAY 21, 24	NOTE BK. 33 P. 595, 9-9-24	2498½	FORM 600
19	" "	"	"	AUG. 29, 24	" " "	2498½	" "
20	WESTERN ELECTRIC CO.	"	"	OCT. 9, 23	BK. 622 P. 422 1-23-24	20946	" "
21	" "	"	"	" "	" " "	"	" "
22	" "	"	"	" "	" " "	"	" "
23-A	PHELAN & BARROW	"	DEED	2-9-1889		2579	L.&N. OWNED
24	Nashville Bridge Co.	"	"	8-31-1967	BK. 117 P. 345 9-20-67	17816	Pasquinelli, Nlw

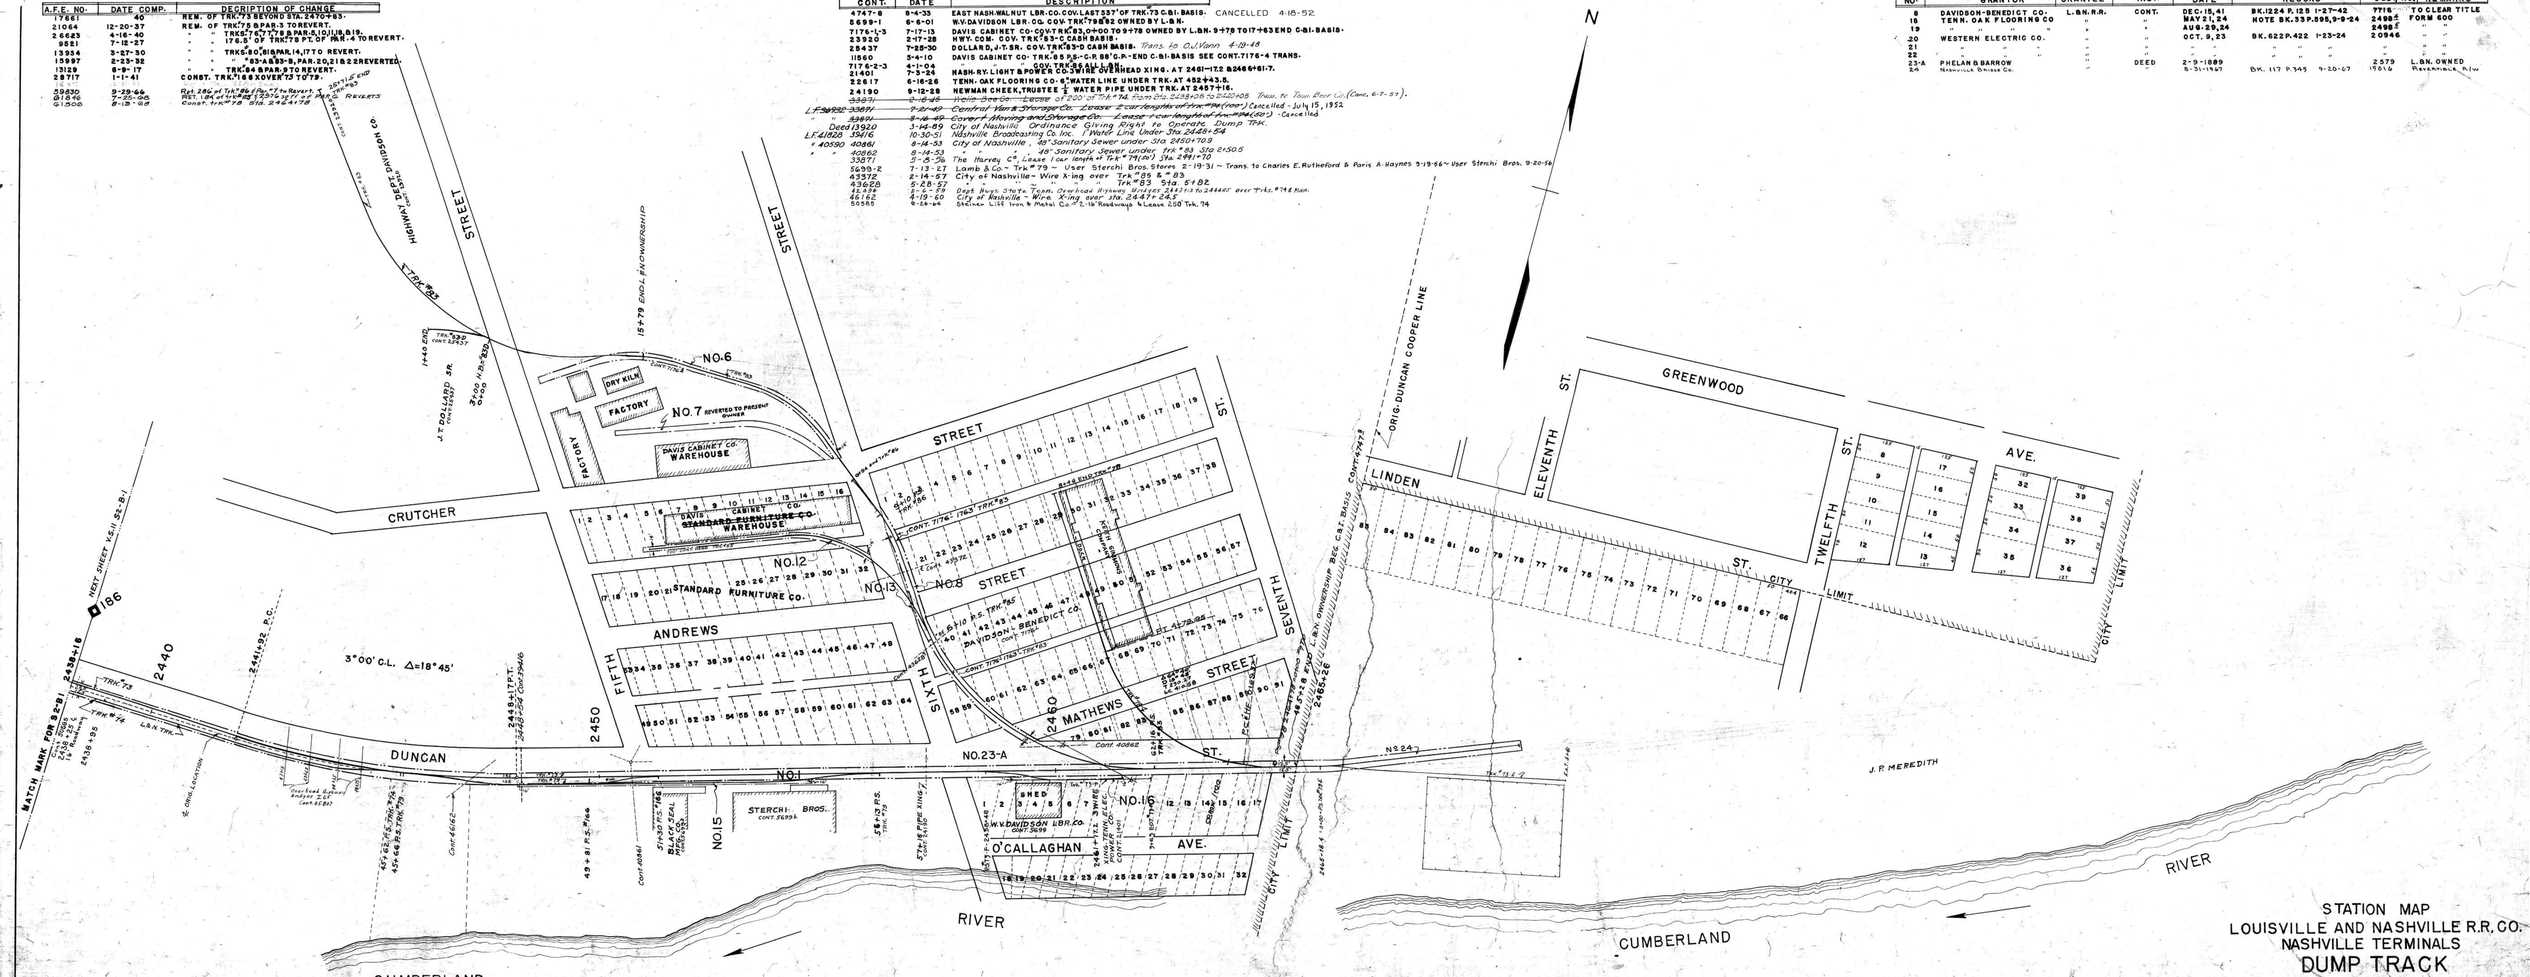

STATION MAP
LOUISVILLE AND NASHVILLE R.R. CO.
NASHVILLE TERMINALS
DUMP TRACK
MILE POST 183.2 TO GAY STREET
STATION 2438+16 TO STATION 2490+15
SCALE: 1" = 100' JUNE 30, 1917
OFFICE OF CHIEF ENGINEER LOUISVILLE, KY.
REVISED & REDRAWN JUNE 30, 1945
CBS

V-11
S-2-D2

V-11 S-282

19-064