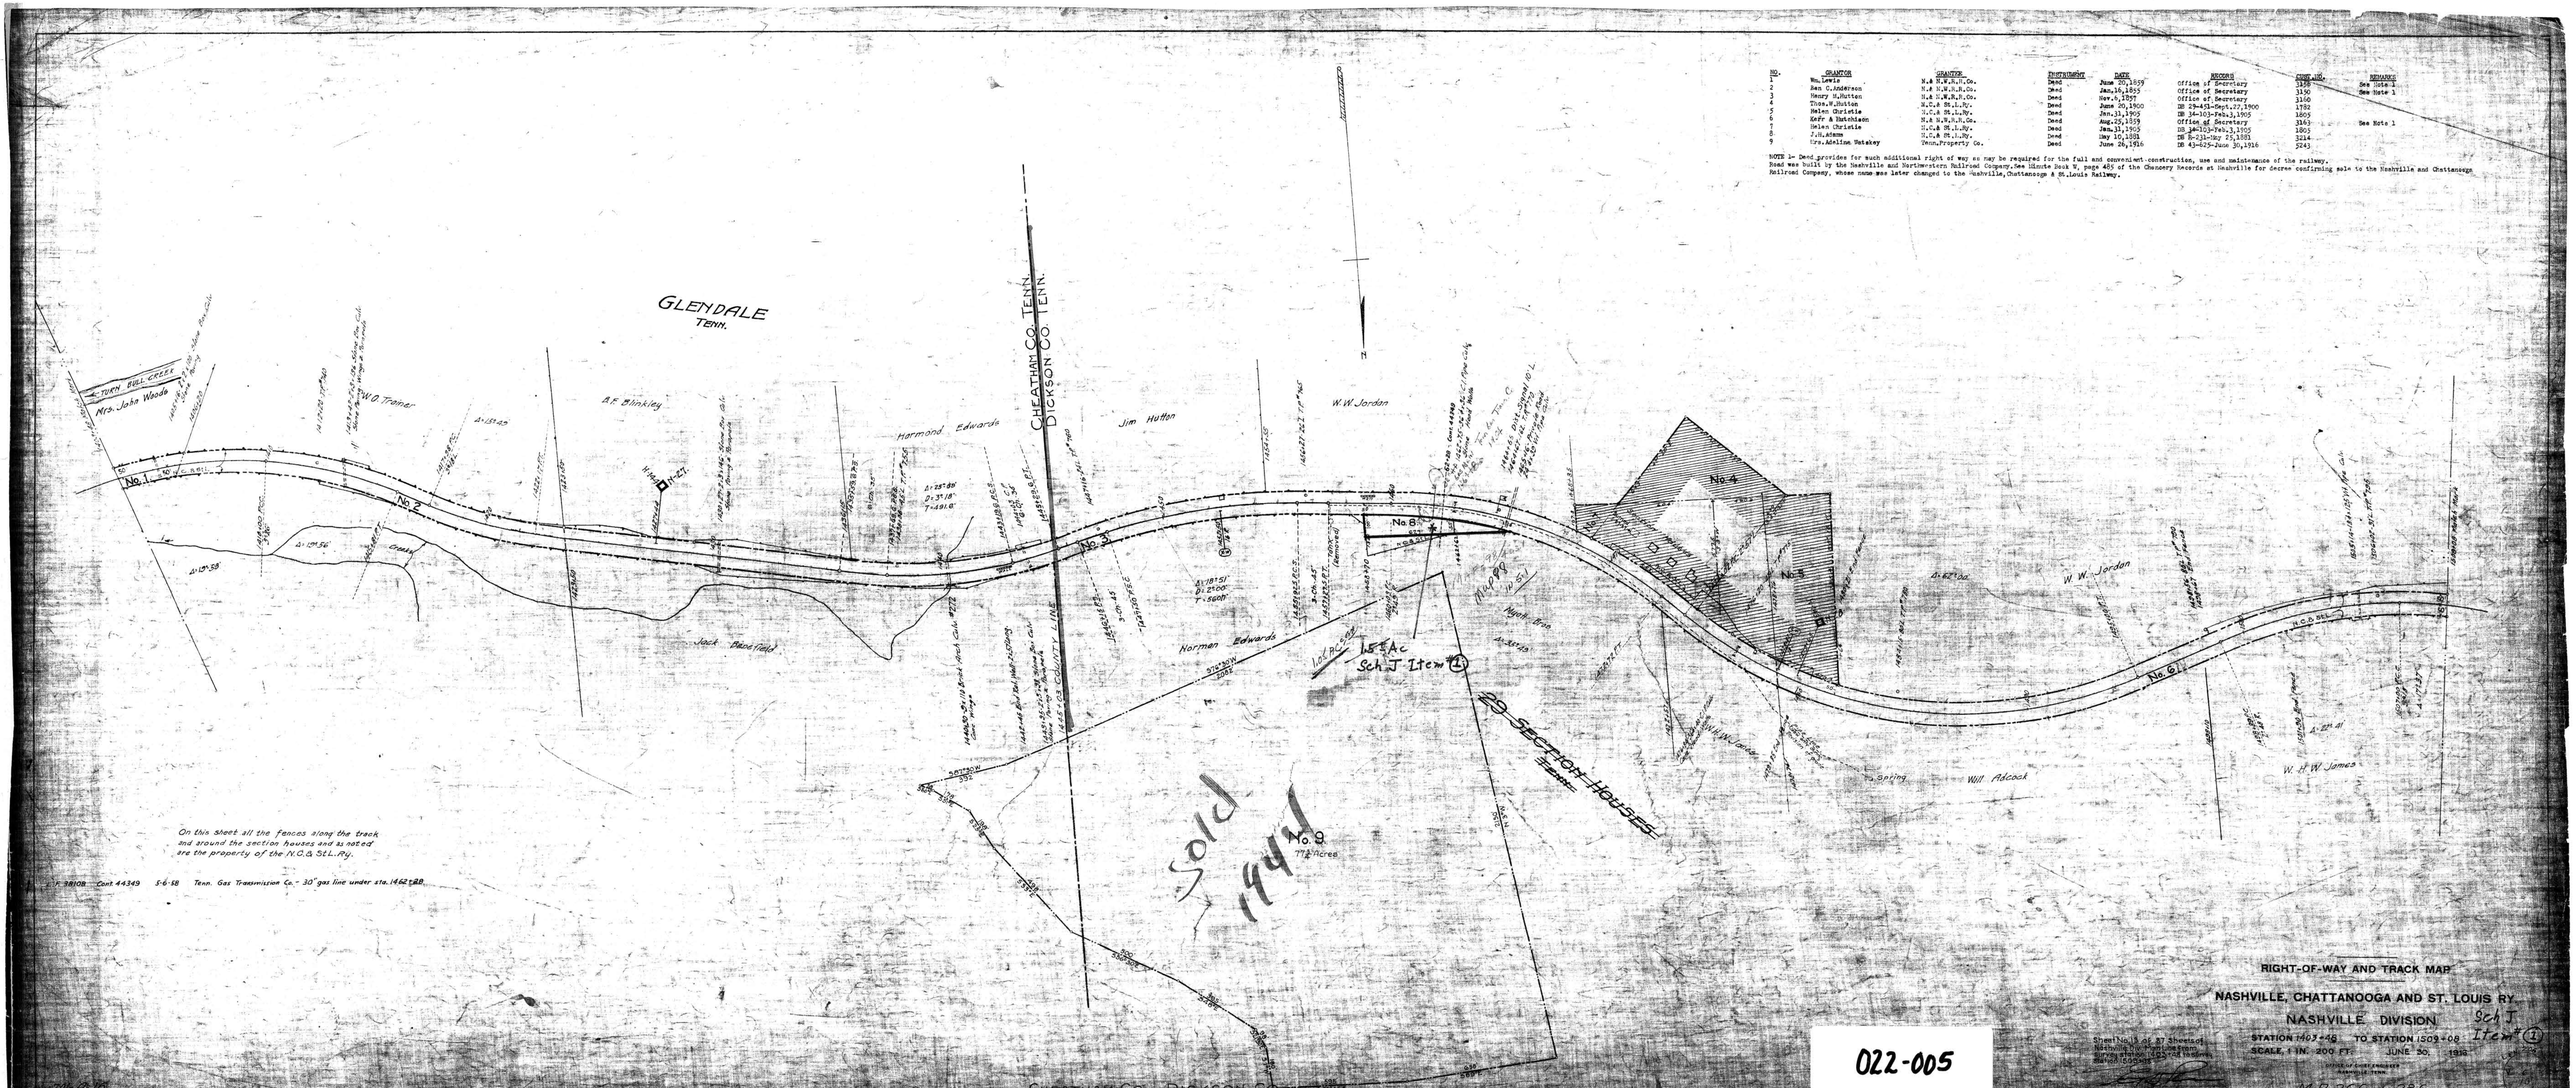

NO.	GRANTOR	GRANTEE	INSTRUMENT	DATE	RECORDS	CHART NO.	REMARKS
1	Wm. Lewis	N.& N.W.R.R.Co.	Deed	June 20,1859	Office of Secretary	3158	See Note 1
2	Ben C.Anderson	N.& N.W.R.R.Co.	Deed	Jan.16,1855	Office of Secretary	3150	See Note 1
3	Henry M.Hutton	N.& N.W.R.R.Co.	Deed	Nov.4,1857	Office of Secretary	3150	
4	Thos.W.Hutton	N.C.& St.L.Ry.	Deed	June 20,1900	DB 29-453-Sept.27,1900	1792	
5	Helen Christie	N.C.& St.L.Ry.	Deed	Jan.31,1903	DB 34-103-Feb.3,1903	1803	
6	KeFr & Hutchison	N.& N.W.R.R.Co.	Deed	Aug.25,1859	Office of Secretary	3163	See Note 1
7	Helen Christie	N.C.& St.L.Ry.	Deed	Jan.31,1903	DB 34-103-Feb.3,1903	1803	
8	J.H.Adams	N.C.& St.L.Ry.	Deed	May 10,1881	DB 8-231-May 25,1881	3214	
9	Trs.Adelina Watskey	Owen,Property Co.	Deed	June 28,1916	DB 43-625-June 30,1916	5243	

NOTE 1- Deed provides for such additional right of way as may be required for the full and convenient construction, use and maintenance of the railway. Road was built by the Nashville and Northwestern Railroad Company.See Minute Book W, page 485 of the Chancery Records at Nashville for decree confirming sale to the Nashville and Chattanooga Railroad Company, whose name was later changed to the Nashville,Chattanooga & St.Louis Railway.

RIGHT-OF-WAY AND TRACK MAP
NASHVILLE, CHATTANOOGA AND ST. LOUIS RY.
NASHVILLE DIVISION
STATION 1403+48 TO STATION 1509+08
SCALE, 1 IN. = 200 FT. JUNE 30, 1938
Sch J Item (1)
Sheet No.18 of 27 Sheets
MP 266 to 286

022-005