REF. NO.	DATE	DESCRIPTION
22-011	8-30-60	REF. TO: N.C.&S.L.
22-011	5-3-62	REF. TO: N.C.&S.L.
22-011	4-27-63	Ref. O.H. Bk. 37.7

NO.	GRANTOR	GRANTEE	INSTRUMENT	DATE	RECORD	CONT. AC.	REMARKS
1	Wm.Austin	N.&T.T.R.R.Co.	Deed	June 20,1859	Office of Secretary	3162	See Note 1
2	Mrs.A.J.McIntyre et al	N.C.& St.L.Ry.	Deed				Def executed June 30,1916
3	A.V.Austin et als	N.C.& St.L.Ry.	Deed	May 30,1881	DB R-241-June 6,1881	1790	
4	O.N.Austin et als	N.C.&St.L.Ry.	Deed	May 7,1881	DB Z-440-June 1,1882	1759	
5	W.P.Hill	N.C.& St.L.Ry.	Deed	Sept.28,1905	DB 34-564-Oct.4,1905	1708	
6	John W.Miller,Trustee for Wm.H.Crutcher	N.A.&N.W.R.Co.	Deed	Oct.11,1899	Office of Secretary	3162	See Note 1
7	R.V.Turner,Agent	Jno.N.Thomas,Agent	Deed	Nov.16,1903	DB 32-548-Dec.7,1903	3183	
8	J.W.Thomas Jr.et als	Tenn.Property Co.	Deed	May 13,1906	DB 35-508-May 24,1906	5206	
	R.N.Turner,Agent	Jno.N.Thomas,Agent	Deed	Nov.16,1903	DB 32-548-Dec.7,1903	3183	
	J.W.Thomas Jr.et als	Tenn.Property Co.	Deed	May 13,1906	DB 35-508-May 24,1906	5206	
9	R.V.Turner,Agent	Jno.N.Thomas,Agent	Deed	Nov.16,1903	DB 32-548-Dec.7,1903	3183	Right of way for pipe
	Jno.N.Thomas Jr. et als	Tenn.Property Co.	Deed	May 13,1906	DB 35-508-May 24,1906	5206	Line reserved.
NOTE 1-	Deed provides for such additional right of way as may be required for the full and convenient construction use and maintenance of the railroad.						
NOTE 2-	Parcels 6,7,8, and 9 were reserved in the following deed of sale.						
	Tenn.Property Co.	Howard Land Co.	Deed	May 13,1916	DB D-250	5206-A	

Road was built by the Nashville and Northwestern Railroad Company.See Minute Book W,page 465 of the Chancery records at Nashville for decree confirming sale to the Nashville and Chattanooga Railroad Company, whose name was later changed to the Nashville,Chattanooga & St.Louis Railway.
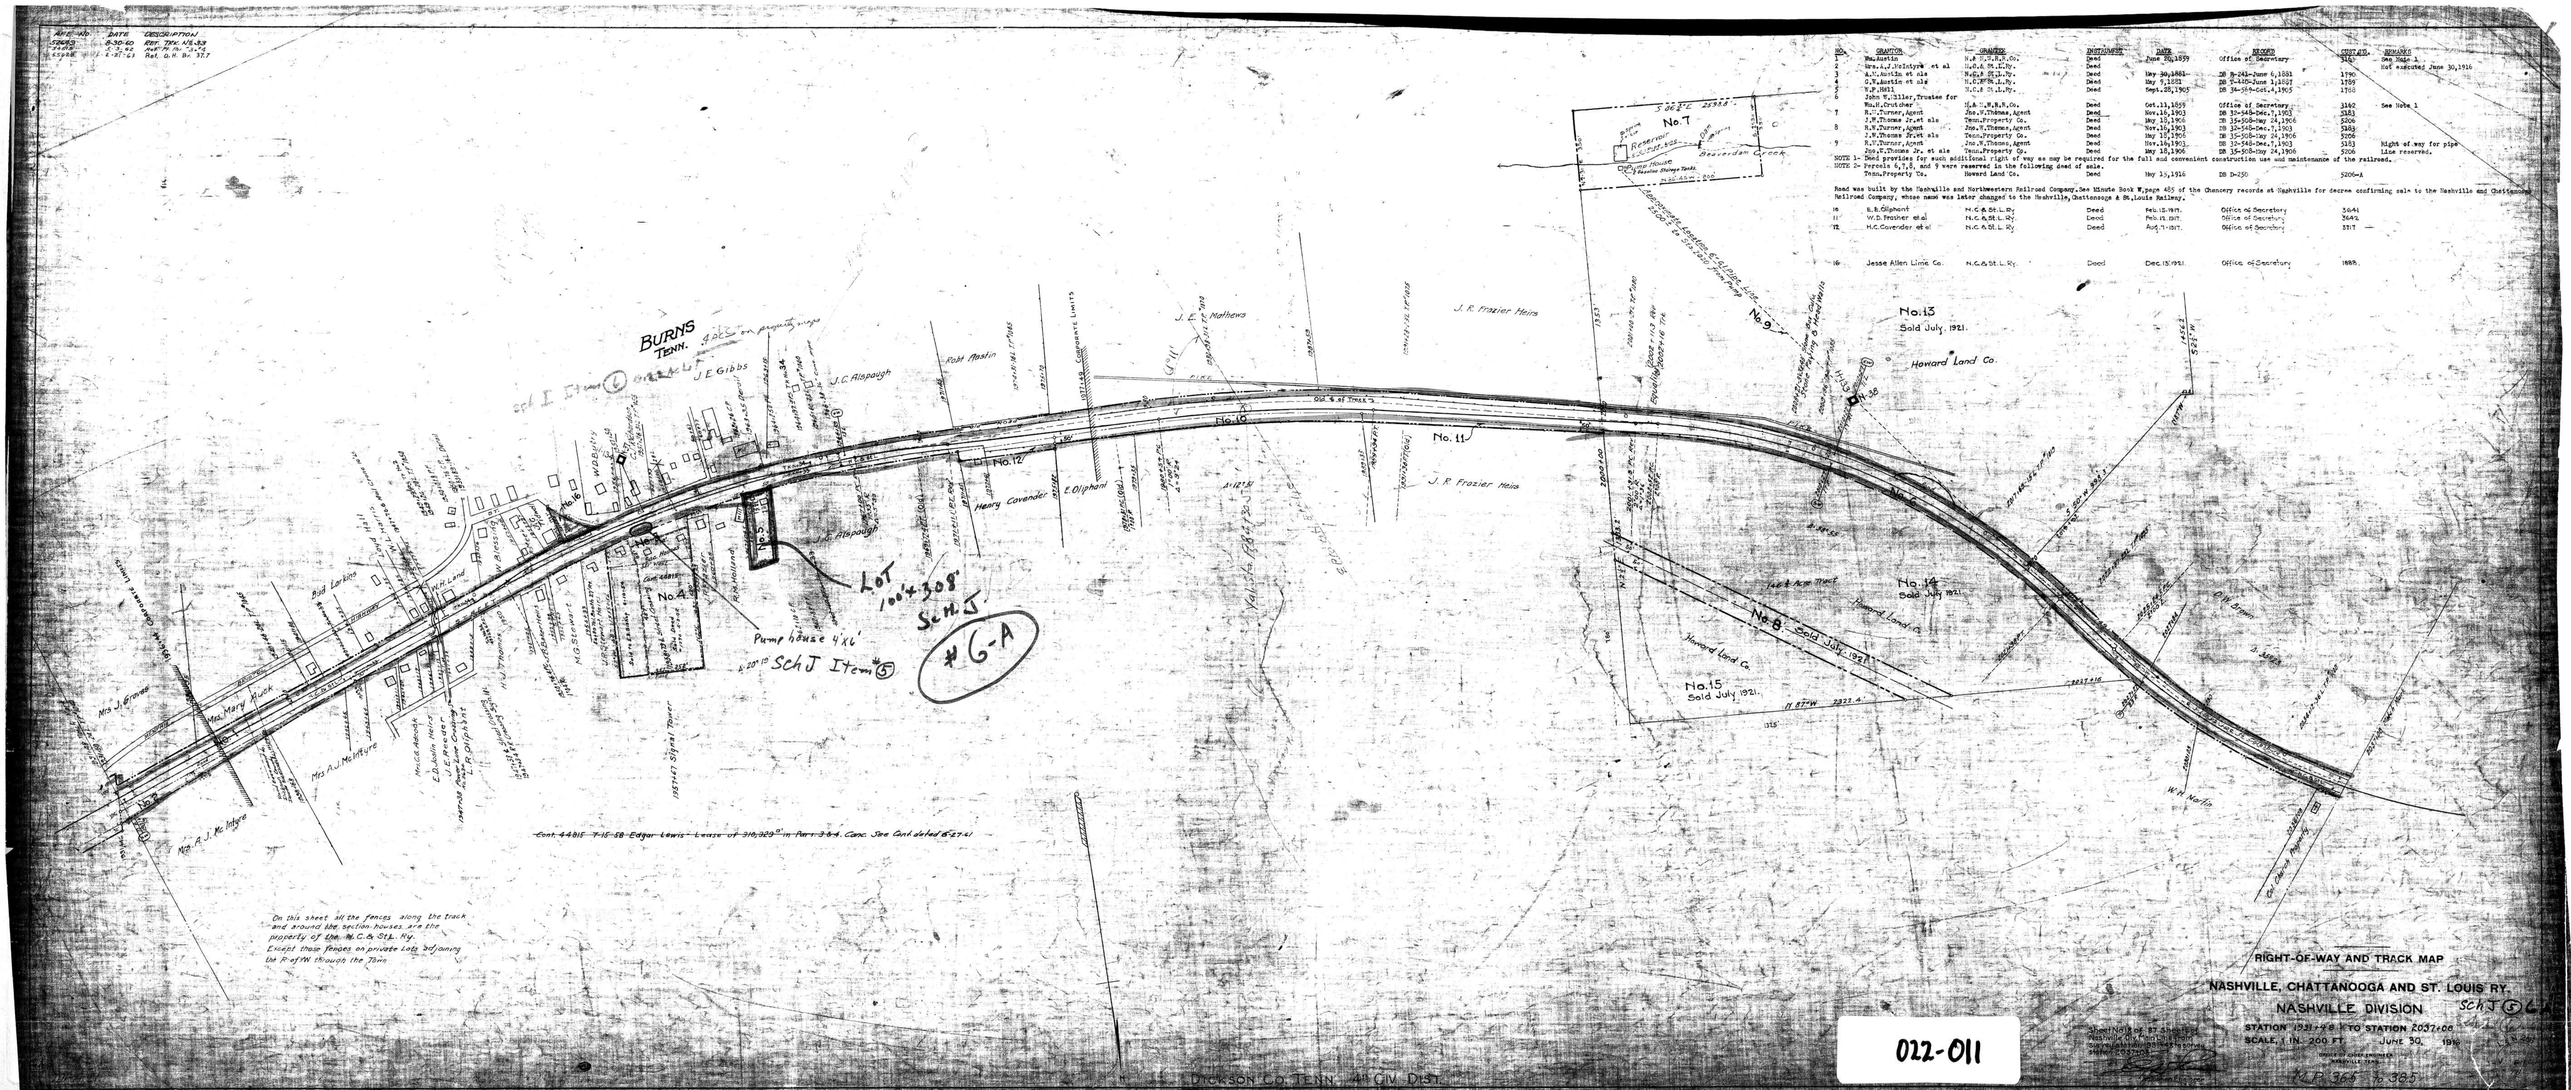
10	E.B.Oliphant	N.C.& St.L.Ry.	Deed	Feb.15.1917.	Office of Secretary	3641	
11	W.D.Fresher et al	N.C.& St.L.Ry.	Deed	Feb.15.1917.	Office of Secretary	3642	
12	H.C.Covender et al	N.C.& St.L.Ry	Deed	Aug.7-1917.	Office of Secretary	3717	
16	Jesse Allen Lime Co.	N.C.& St.L.Ry.	Deed	Dec.15.1921.	Office of Secretary	1888.