NO.	GRANTOR	GRANTEE	INSTRUMENT	DATE	RECORD	CONT. NO.	REMARKS
1	-------Stevenson	N.& C.R.R.Co.	None				See Note 1
2	-------~~Wilkinson~~ Jno F. Anderson	N.& C.R.R.Co.	~~None~~ Cond.	Nov. 13, 1828	M.S.C.C. 'B' p. 971	1009	~~See Note 1~~
3	John B. Lynch	N.& C.R.R.Co.	Deed	Jan. 15, 1854	Office of Secretary	973	
4	-------~~Wilkinson~~ Jno F. Anderson	N.& C.R.R.Co.	~~None~~ Cond.	Nov. 13, 1828	M.S.C.C. 'B' p. 971	1007	~~See Note 1~~

Below this line received since date of valuation

NOTE 1- Charter width claimed under decisions of Tennessee Courts.

5	J. B. Lynch	N.C. & St.L. Ry.	Deed	July, 24, 1916	DB 39-570 - Aug. 19, 1916	3417	
6	J. B. Lynch	N.C. & St.L. Ry.	Deed	July, 24, 1916	DB 39-570 - Aug. 19, 1916	3417	
7	Ben Payne	N.C. & St.L. Ry.	Deed	July, 29, 1916	DB 39-569 - Aug. 19, 1916	2182	
8	John King	N.C. & St.L. Ry.	Deed	Aug. 29, 1916	DB 39-571 - Aug. 19, 1916	3418	
			Release	Nov. 11, 1919		3779	
9 to 8	Wm. Bean et al	N.C. & St.L. Ry.	Cont.	Nov. 11, 1919	T.B. 30-104-Dec. 23, 1919	3784	
	Mike Willis	N.C. & St.L. Ry.	Release	Oct. 4, 1919	T.B. 3-228	3791	

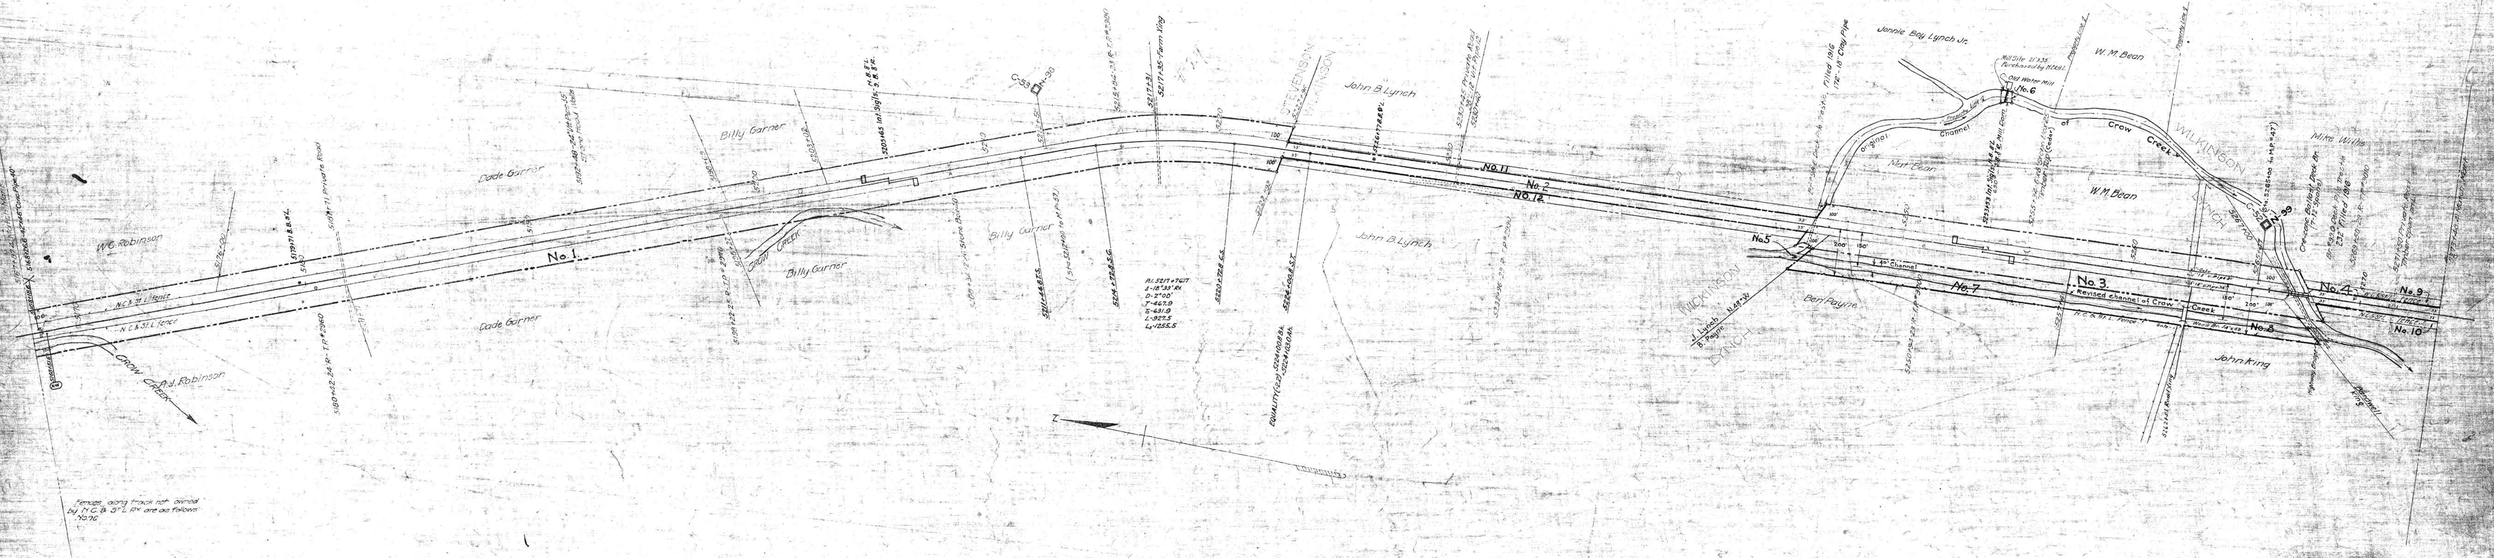

RIGHT-OF-WAY AND TRACK MAP

NASHVILLE, CHATTANOOGA AND ST. LOUIS RY.

CHATTANOOGA DIVISION

STATION 5167+87.4 TO STATION 5273+48.4

SCALE, 1 IN. 200 FT. JUNE 30, 1916

OFFICE OF CHIEF ENGINEER
NASHVILLE, TENN.

Sheet No 59 of 73 sheets of Chattanooga Division from survey station 5167+87.4 to survey station 5273+48.4

Valuation Engineer

M.P. 971 to 991

026 - 17

702-E-24

FRANKLIN CO., TENN.