A.F.E. No.	Date comp.	Description of change
2956	5-30-22	Inst. of electric lights in Depot.
4198	5-23-28	Inst. of cone curb at Station Platform
11591	4-1-23	Inst. of 48" cone culv. ft long Sta. 6644+61
12071	3-30-29	Rel. of shack pens.
20123	8-8-35	Ext. of 11" to 14" 210
23126	12-1-37	Rel. 36"-38" clay pipe
37213	7-31-48	Install flashing light sig. rd. Xing So. Depot, Gibson, Tenn.
46818	6-13-57	Ret. Blacktop platform Sta. 6625+11.
5290 Reading	11-19-59	Rel. Combination Passenger & Frt. Deprt. Sta. 6626+00, Fruit Shed & Platf.

No.	Grantor	Grantee	Instrument	Date	Record	Cust. No.	Ar. A.F.E.	Remarks
2R	J. R. Russell	L&N R.R.Co.	Deed	12-18-28	D.B.75-Pg 1056-2-16-29 / D.B.3-Pg 105-2-16-29	13076		Special Rights

1.57 mi

~~Sta. 6625 of Road~~

Sched. I Sheet 46B Item 16

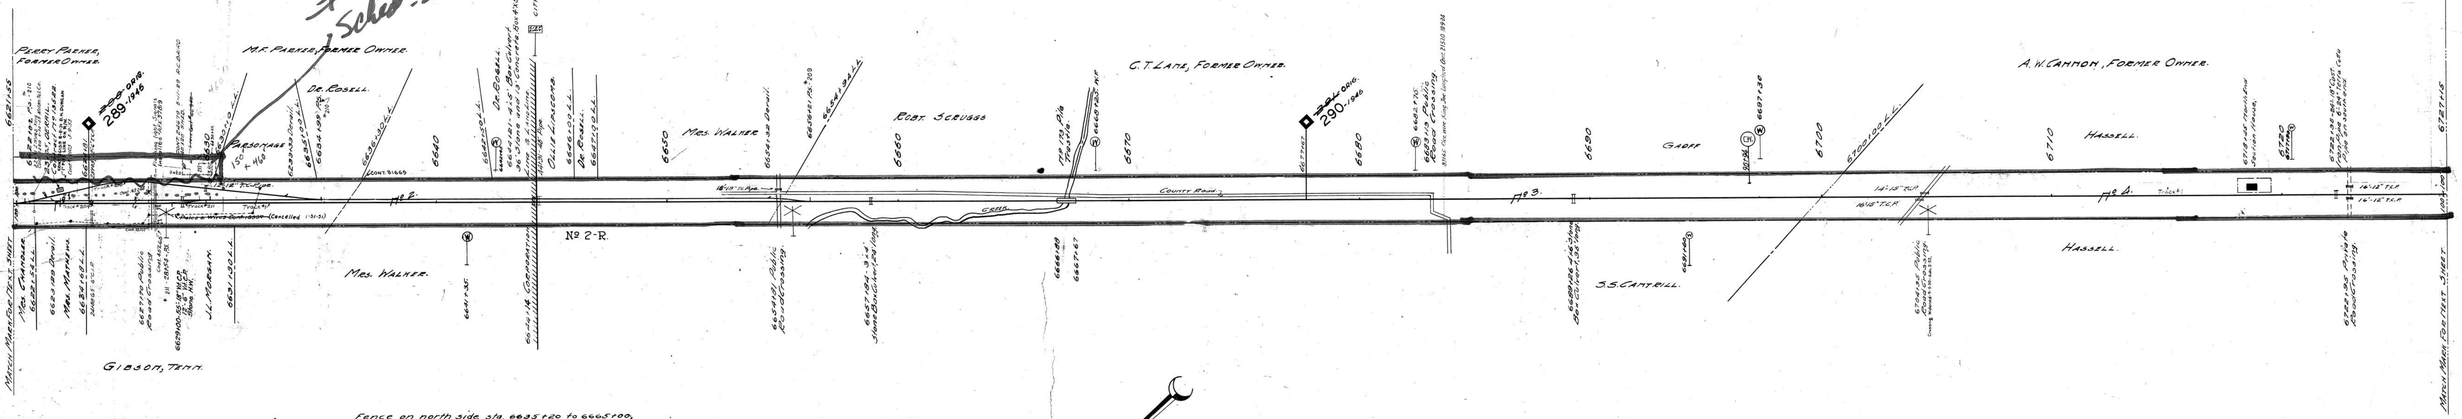

Fence on north side, sta. 6633+20 to 6665+00, 6667+45 to 6677+70, and 6710.175 to 6715+00. Fence on south side, sta. 6667+00 to 6683+00, 6667+45 to 6683+00, and 6705.50 to 6719+35.

Cancl. 27840	6723.1	Beaver Ice & Coal Co. 40x50 Ice House on Rt. 6628+60 149' from track.	
" 25235	9-7-55	N.G. Jones Water line across and under Hwy 210 at 6672+60	
" 31665	8-8-40	Gibson Co. R.E.C. Main Contr. Inc. - Wire, Kind, Sta. 6635+14	
31676 "	3-16-51	Sta. 6627+44	
21307 "	19103	5-2-51 West Tenn. Truck Growers Assn. ~~Lease of 2817 sq. ft. in Fruit Shed (E. End)~~ Canc.	
21307 "	19103	~~5-14-51 R.E. James Lease of 4676 sq. ft. in Fruit Shed (W. End)~~ Cancelled	
21307 "	19103	~~5-14-51 H.P. Hale & Son Lease of 2862 sq. ft. in Center of Fruit Shed~~ Canc.	
21307 "	19103	~~9-12-53 Re-leased J.R. Atkins Lease of 2312 sq. ft. in South End of Fruit Shed~~ 8-1-54	
21307 "	19103	~~9-12-53 H.P. Hale and Son Lease of 2312 sq. ft. in N. End of Fruit Shed~~ 8-1-54	
	19103	9-17-56 R.E. James & J.R. Atkins Lease of 2477 sq. ft. in South End of Fruit Shed	
	"	" H.P. Hale and Son " " 4970 sq. ft. North " "	
	19176	" 5-24 JAMES FRUIT COMPANY Lease of Space Adjacent to end of Depot Office " " (Canc. 11-20-53)	
	~~19103~~	~~11-4-57 R.E. James & J.R. Atkins Lease of 2477 Sq. ft. in Fruit Shed~~	
	~~19103~~	~~11-4-57 H.P. Hale & Son " " 4970~~ " "	
	19103	5-21-58 R.E. James & J.R. Atkins " " 2477 " "	
	19103	5-21-58 " " " " " 2477 " "	
	19103	9-10-58 H.P. Hale & Son " " 4970 " "	
	19103	9-10-58 " " " " " 4970 " "	
	42262	5-13-59 City of Gibson - 6" Water Line Under Sta. 27+60	
	49944	3-8-61 Bonnie Brooks Corp. Lease of Space in Fruit Shed Sta. 6625+97 and 6626+22. Cancelled	
	49944	3-8-61 Bonnie Brooks Corp. Lease of Space in Fruit Shed Sta. 6625+97 Cancelled	
3	49776	2-8-61 Martin Marietta Corp. Lease of Space in Fruit Shed for Truck Tests	
	47378	8-7-62 James R. Atkins - Lease 1500 sq. ft. 7 ft. 3 in. x 206 ft. in 6624+77.5	

Sheet No. 6A of 11 of Memphis Line from survey station 6621+55 to survey station 6727+15

Valuation Engineer.

RIGHT OF WAY AND TRACK MAP
LOUISVILLE AND NASHVILLE R. R. CO.
MEMPHIS LINE

STATION 6621+55 TO STATION 6727+15

SCALE 1 INCH = 200 FT.

OFFICE OF CHIEF ENGINEER
LOUISVILLE, KY.

V.25-64

V.25-64.

GIBSON COUNTY, TENN.

5-2