AFE No.	Date Comp.	Description of Change
12714	12-20-29	Inst. of Train Length Markers V.9. 16.
21171	9-27-38	South P.S.# 51 moved No. from 3439166.7 to 3435127

No.	Grantor	Grantee	Instrument	Date	Record		Cust.No.	Remarks
1	Robt.Harris	L.& No.H.R.Co.	Deed	Aug. 5,1911	D.S. 67	P.464	Aug.31,1911	10296	
2	J.B.Harris	"	"	May 25,1911	D.B.W.W.	P.598	Jul.11,1911	10297	
3	Mrs.Sue Solomon et al	"	"	May 25,1911	D.B.W.W.	P.590	Jul.10,1911	10298(1)	
4	Mrs.Sue Solomon	"	Condemnation	Aug.23,1912				10298(2)	No record shown
5	H.D.Story	"	Deed	May 16,1911	D.B.W.W.	P.593	Jul.10,1911	10299	
6	Susan P.Harris et al	"	"	Oct.17,1911	D.B.X.X.	P.315	Oct.21,1911	10300	
7	R.S.Hereford	"	"	May 16,1911	D.B.W.W.	P.596	Jul.10,1911	10301(1)	See Note No.1
8	J.W.Mitchell	"	"	May 16,1911	D.B.X.X.	P. 4	Jul.11,1911	10302(1)	See Note No.2
9	O.F.Thorp	"	"	May 16,1911	D.B.W.W.	P.589	Jul.10,1911	10303	
10	Mrs.E.D.Harwell et al	"	"	May 25,1911	D.B.W.W.	P.592	Jul.10,1911	10304	

Notes:

#1 - R.R.Co. agrees to move barn from right of way - Deed No.10301(2) - Borrow pit privileges from R.S.Hereford Sep.3,1912 Contract No.14737(1)
Release from damages caused by borrow - Jul.19,1913 Contract No.14737(2)

#2 - " " " " and digging creek change - Aug.7,1913 - Contract No.14738
R.R.Co. agrees to remove barn from right of way - Deed No.10302(2)

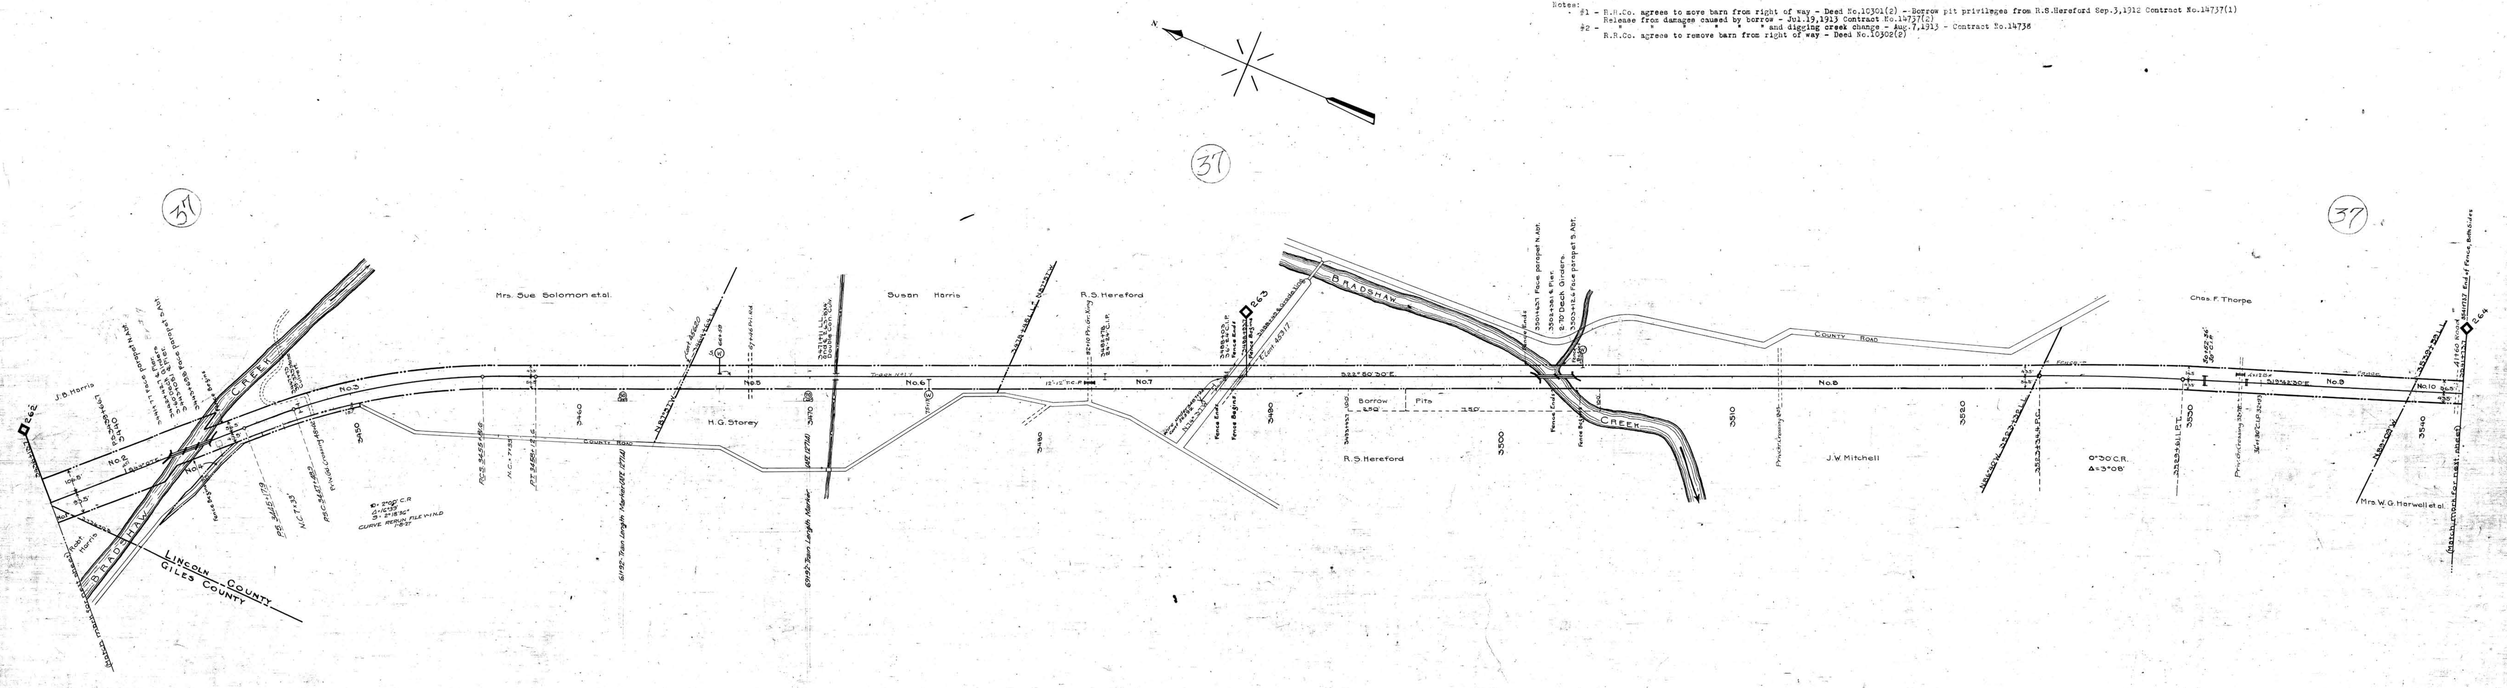

Note: From M.P. 262 to curve sta.3449+83.8 track was laid 6.5' west & original location. From this curve to curve sta.3523+34.4 track was laid 6.5' east & o.l. From this curve to M.P. 264 track was laid 6.5' west & original location.

L.F. 15935 Cont. 36592 4-6-48 Delrose Mutual Telephone Co. underground crossing at 3487+94 also conduit at 3558+90 Map 25
" 45317 5-9-59 Ardmore Tel. Co. - Wire Crossing Under Sta 488+79.7
" 45620 7-20-59 Lincoln County Elec. Membership Corp. - Wire King over Sta 3464+63.7

Sheet No 34 of 42 of Lewisburg Division from survey station 3436+13.7 to survey station 3541+73.7

Valuation Engineer

028-08

RIGHT OF WAY AND TRACK MAP
LOUISVILLE AND NASHVILLE R. R. CO.
LEWISBURG DIVISION

STATION 3436+13.7 TO STATION 3541+73.7

SCALE- 1 INCH = 200 FT. JUNE 30 1917.

OFFICE OF CHIEF ENGINEER, LOUISVILLE, KY.

V.16
34

16-34

GILES AND LINCOLN COUNTIES TENN.