A.F.E. No.	Date Comp.	Desc. of Change.
2396	4-20-22	Retire Part of Par. No. 4
rob. 64	12-5-31	Installation of Whistle Post Sta. 5676+00

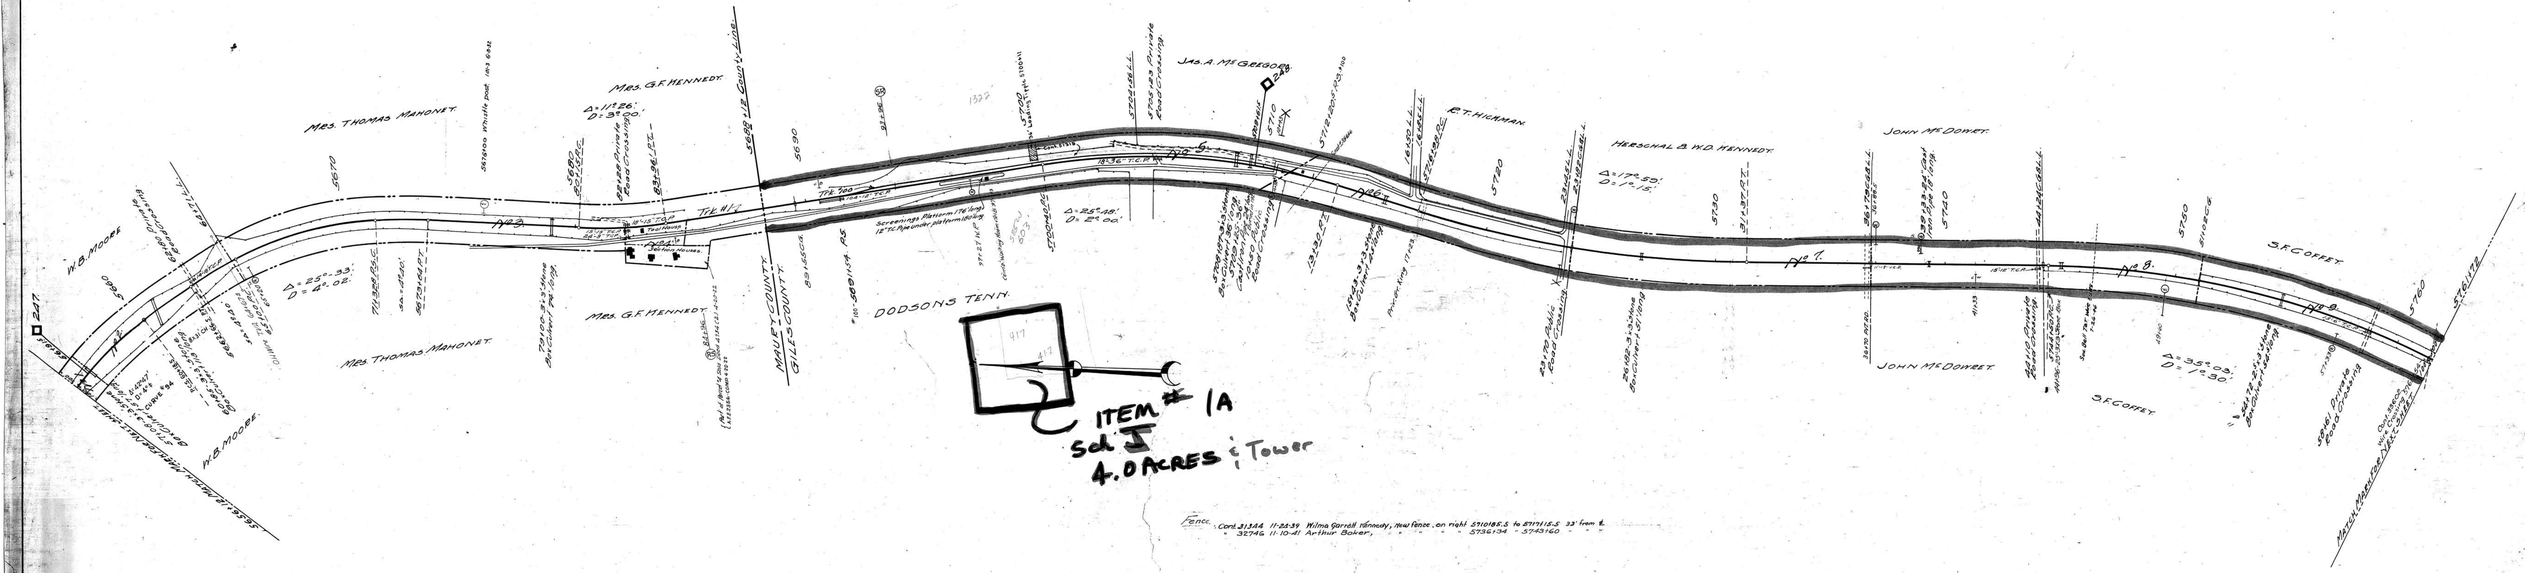

Fence. Cont. 31344 11-25-39 Wilma Garrett Kennedy, New fence, on right 5710+85.5 to 5717+15.5 33' from ℄
" 32746 11-10-41 Arthur Baker, " " " " 5736+34 " 5743+60 " " "

Cont. 33602	8-17-44	Duck River Elec. Membership Corp.	Wire Crossing over of 5761+54
" 36666	8-13-48	" " "	" " " 5712+31.5
Cont. 27704	2-3-53	Tennessee Valley Authority	Wire Crossing over of 5664+67.5
~~51319~~	~~4-28-53~~	~~Monsanto Chemical Co. - Tipple encroachment and lease of 1646.5' track 5+100~~	Land. 12-6-70

SHEET NO. 30 OF 52 OF NASHVILLE AND DECATUR DIVISION FROM SURVEY STATION 5656+12 TO SURVEY STATION 5761+72

VALUATION ENGINEER.

RIGHT OF WAY AND TRACK MAP
NASHVILLE AND DECATUR R. R. CO.
OPERATED BY
LOUISVILLE AND NASHVILLE R. R. CO.
STATION 5656+12 TO STATION 5761+72

SCALE-1 INCH = 200 FT. JUNE 30, 1917.

OFFICE OF CHIEF ENGINEER
LOUISVILLE, KY.

028 - 13

V.14.
30.

14-0

MAURY COUNTY, TENN. GILES COUNTY TENN.