A.F.E. No.	Date Completed	Description of Change
6576	10-9-26	Removal of 52' of track #111
14045	6-29-30	Erect or maintain toilets, walks
		main crane

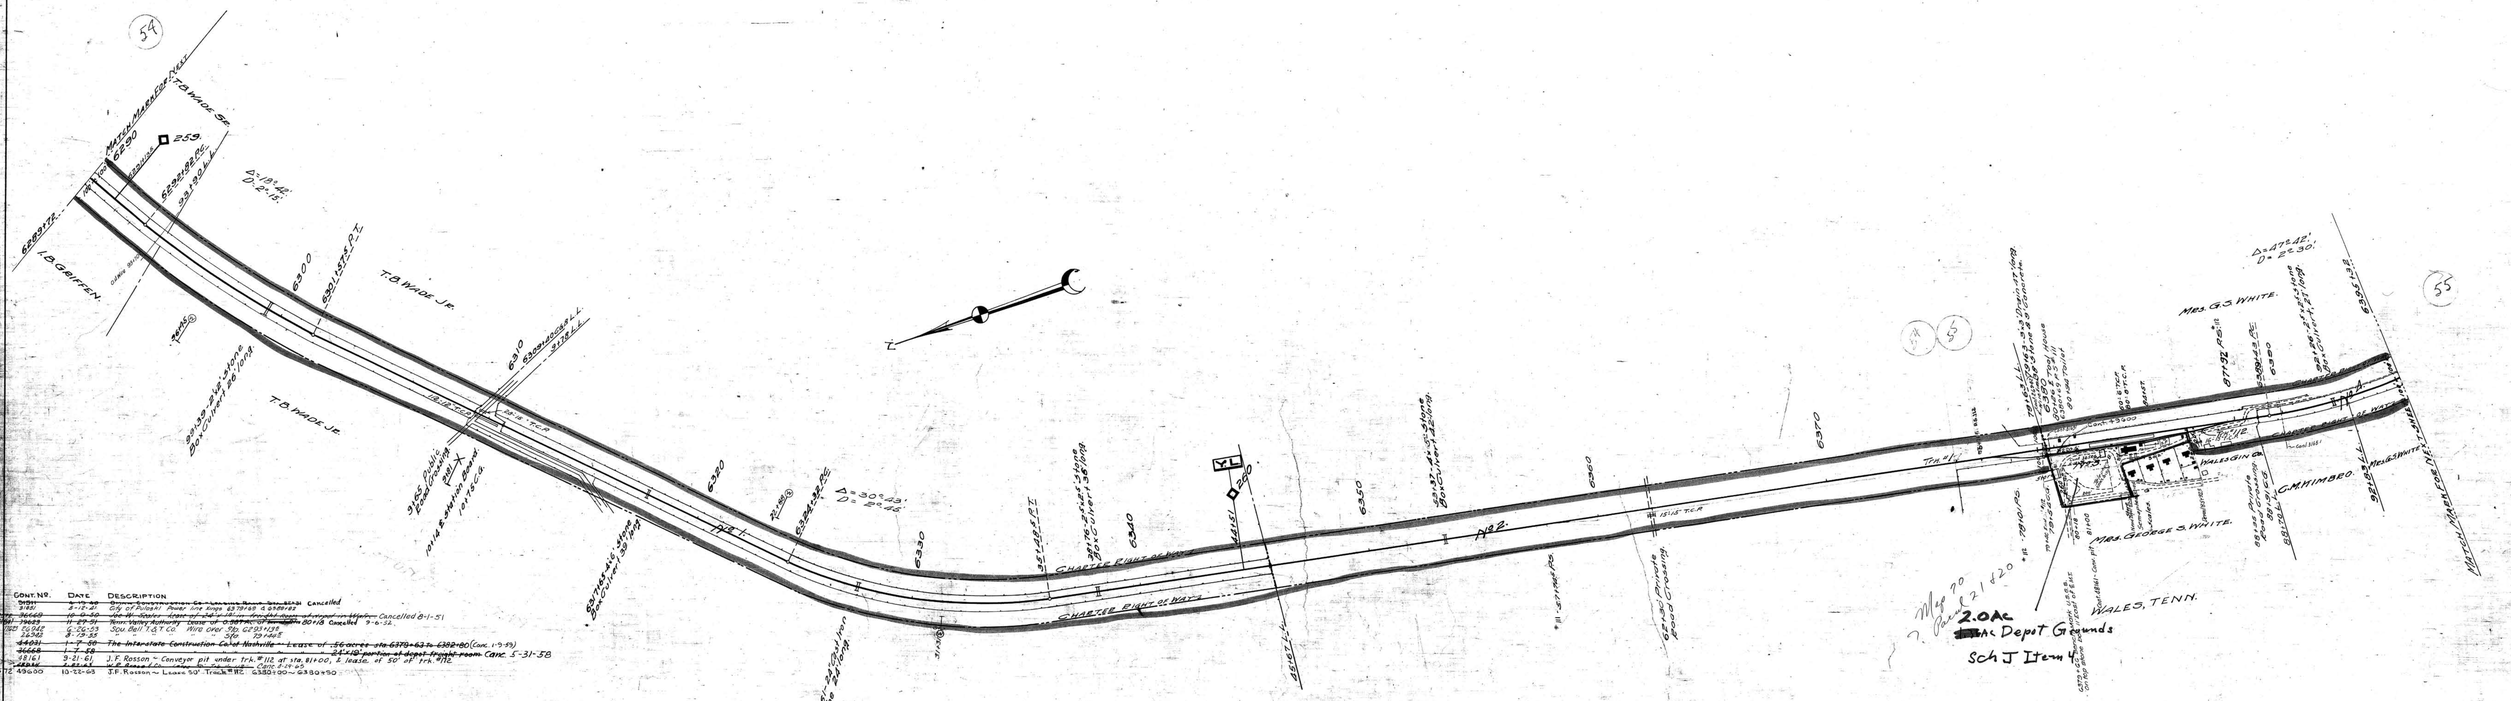

Cont. No.	Date	Description
~~[illegible]~~	~~[illegible]~~	~~[illegible]~~ Cancelled
3181	8-12-21	City of Pulaski Power line Kings 63.78+60 & 63.88+82
~~[illegible]~~	~~10-2-30~~	~~[illegible]~~ Cancelled 8-1-51
~~[illegible]~~	~~11-27-51~~	~~Rural Valley Authority Power line at 6.87+00 (Cancelled 9-6-52.~~
15042	5-26-53	Sou. Bell T.&T.Co. Wire over Trk. 62.31+08
15082	5-29-53	Site To Hold
~~14021~~	~~1-7-30~~	~~The Interstate Construction Co of Nashville — Lease of 5.6 acres sta. 6370+63 to 6382+80 (Canc. 1-9-34)~~
~~36668~~	~~[illegible]~~	~~0.4 x 10' portion of depot freight room. Canc. 5-31-58~~
18161	3-21-61	J.F. Rossen — Conveyor pit under Trk. #112 at sta. 81+00, A lease, of 50' of Trk. #112
~~[illegible]~~	~~[illegible]~~	~~J.F. Rossen — Canc. 5-29-62~~
75-12-49500	10-22-63	J.F. Rossen — Lease 50' Track #112 6380+00 — 6380+50

SHEET NO. 36 OF 52 OF NASHVILLE AND DECATUR DIVISION FROM SURVEY

STATION 6289+72 TO SURVEY STATION 6395+32

VALUATION ENGINEER.

028 - 19

RIGHT OF WAY AND TRACK MAP
NASHVILLE AND DECATUR R. R. CO.
OPERATED BY
LOUISVILLE AND NASHVILLE R. R. CO.

STATION 6289+72 TO STATION 6395+32

Sch J (4)

SCALE-1 INCH = 200 FT. JUNE 30, 1917.

OFFICE OF CHIEF ENGINEER
LOUISVILLE, KY.

V.14
36

GILES COUNTY, TENN.

36.