No.	Grantor	Grantee	Inst.	Date	Record	Cust. No.
Pt. 6	L&N	L.F. Stone	Deed	10-4-57		1911

A.F.E. No.	Date Completed	Description of Change
7685	6-26-26	Const. of track #87A
6625	6-15-25	Const. of public road N. Side of R.R. from Sta. 2149+60 to 2170+
518	4-27-20	Sale and removal of Hotel on Pat. No. 6.
4083	2-18-24	Record of Water Station.
11090	7-31-29	Replacing 30,000 Gal. Tank Sta. 2171+17 with 63,600 Gal. Tank.
17866	8-28-28	Relocat. Yard house & land of trk. 85 A Sta. 2166+05
23113	11-15-27	" " Tab. derrick
23578	12-23-27	Ref. of Rel. hs. at 2174+74
23827	2-27-31	Ref. (Hawkins Cove) Bldg.
25681	3-1-30	Relocat. of Water Tank
	7-1-30	X-over (Mineral Wells, Sta.)
27778	11-5-41	Reconstructed O.H. Br. at Sta. 3613+37
29865	10-5-42	Reol. Trk. #80. 1245.5 long
30503	10-10-42	Constr. 18.5 Ext. to Trk. #81
30755	11-13-43	" 56" " " " #79
32708	11-18-44	Sale parts passing #45 & 48
35423	8-22-46	Sale 2½ acres parcel #3
37531A	4-9-48	Ret. T.P. #85A.
37933	4-7-48	Ret. 160' T.P. #84; 162' T.P. #86 const. N. #85 and 170.; T.O. 1237 #86 Const
38620	3-31-48	Ret. Turntable at Erin Tennessee
37915	7-3-49	New Const. Water Tank Sta. 2174+00 & K.P. 12" C.I.P. Suction line Ret. - Electrifying Pumping Station
38814	8-10-49	Ret. Scales and Trk. #86 126.5' lg.
41520	11-30-51	Ret. Trks. & #87 & 87A, Firemen's Shanty, Toilet, and Cinder Pit.
42394	6-10-52	Water Sta. Ret. Trk. 87A, 21'2" x 38' Gear Water Crane Sta. 2174+25 Retired
44031	10-21-53	Ret. Water Sta. Facilities (Water Crane, 63,600 g. tank, old & new pump houses, and pipe)
44880	5-26-54	Ret. old section house in pos. #4
45379	12-30-	Joints Const. Hwy. O. Pass. Sta. 36+37
49180	8-12-57	" Ret. 450' Trk. #88
49393	10-11-57	Sale Pt. Parcel #6 to L.F. Stone
51090	1-27-59	Ret. Trk. #79 & 81
50236	5-13-58	Ret. Trk. #88
50605	9-13-58	Ret. also at trk. #78 incl. 170(94)' & convert 170(99)' of Trk. #82 to Trk. #78

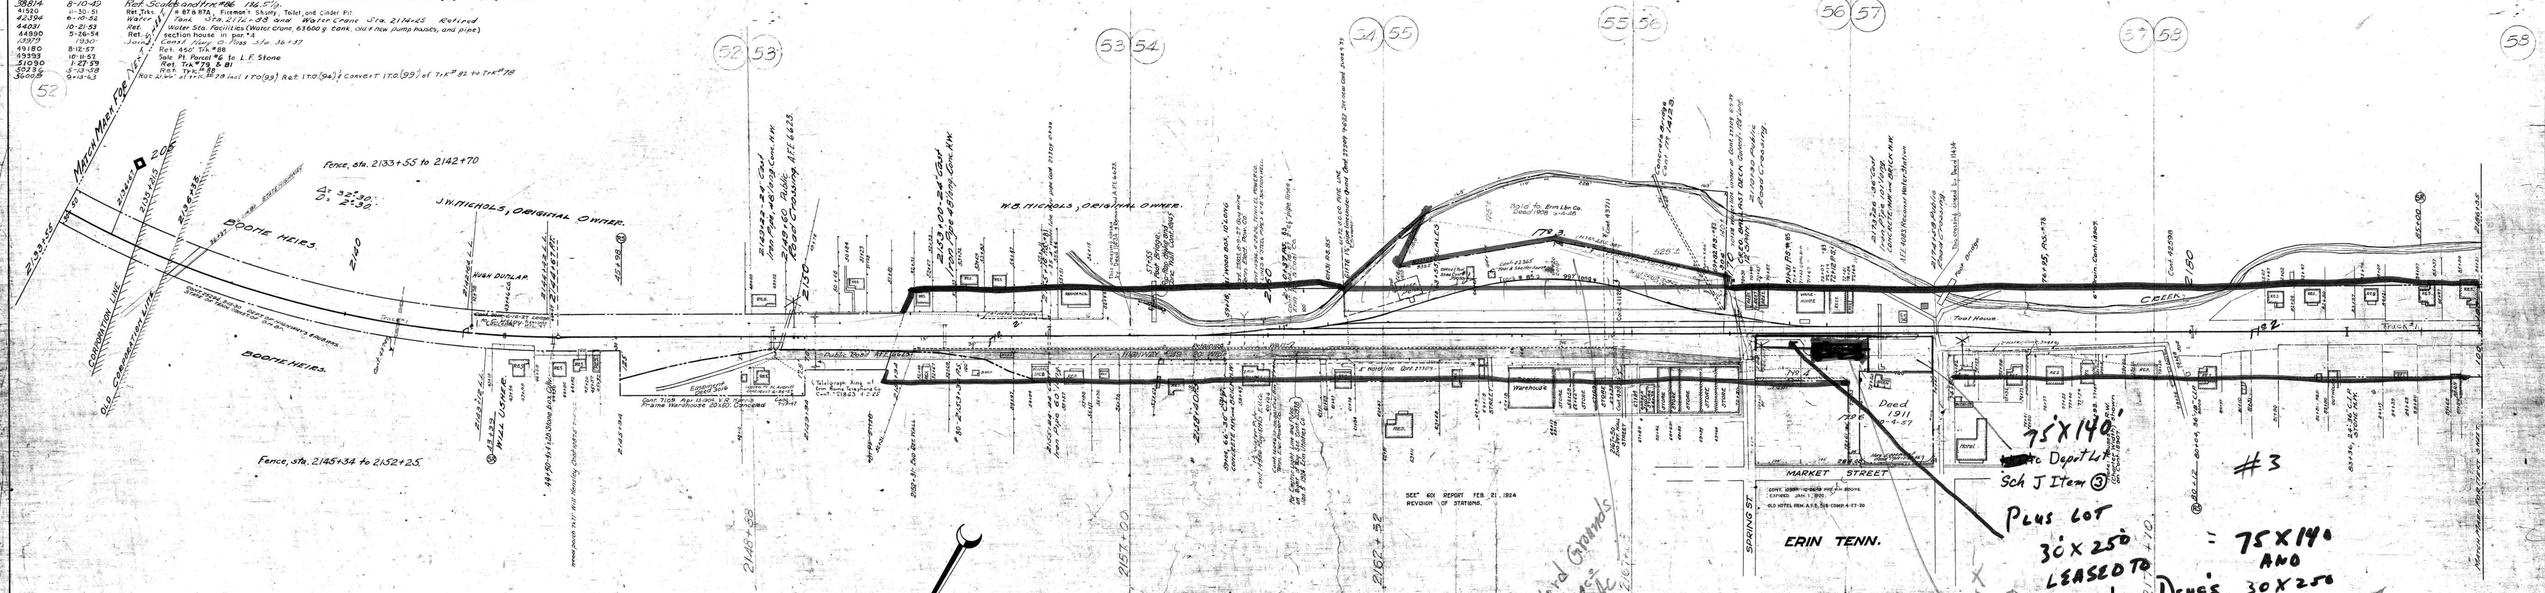

Cont. 28765 4-7-32 The Tenn. Elec. Co. 3 wire Xing Station 1137+13

~~27651~~	~~2-10-32~~	" " " "	Parcels 3 and 6 - Trans. to Merriwether Lewis Elec. Coop. 5-26-40
" 27361	9-1-31	L.F. Stone lease of land 20'x40' on pcl. 3 Sta. 2158+85 Trans. to Stone & Nichols 8-28-38 - Trans. to Wesley Brunson 1942 Cont. '45
" 17252	12-1-29	City of Erwin 18' roadway on left Station 2159+70 to 2172+10
" 20485	6-13-28	" " " " 2184+70 moved at Sta. 71 at 2138+80
" 17209	6-3-29	" " " " 4" water line from 32 E.I.P. at 2155+88, 12" water line greater of 8"+4" and 12" Thru Culvert at 2164+26
		" " " " 4" " " on R.O.W. 60' R. of and parallel to R. of R. Sta. 2155+23 to 2170+86
" 30874	12-2-39	" " " " 4" water line in R.O.W. 60' R. of R. Sta. 2155+23 - 2156+36, 2160+00 - 2162+00 - 2178+15
" 18716	7-23-46	City of Erin Lease of Part of Park & Property & contract assumed by J.L. Hart 11-6-44
		Other & Nuisance Leases - " " " Cont. Pend.
~~30710~~	~~10-8-42~~	~~Thomas Oil Co. Lease of Part Sta. 2144+75 - 2146+50 Warehouse Cont. 6/1/50~~
" 30054	10-9-42	Town of Erin Tenn. Const. Ext. Hwy. 2 Sta. 1+31 Sta. 2152+31 & 2167+50
" 33451	12-11-43	Merriwether Lewis Elec. Cooperative Sta. pole & anchor for guy wire on R.W. at 2170+06
" 33961	2-21-45	Miss. Valley Barge Terminal Lease of part of pcl. 3 Cont. " and Dick Lumber Co. 8-3-46
" 34504	12-27-45	City of Erin 2" water line Thru' 24" C.I.P. at Sta. 2183+86
LF 40286	2-6-51	R.W. Mitchum Cons. Sta. & Enclosure 7'9" x 10'
LF 41698	39089	5-3-51 C.R. Largent Office & Tool House 30'x16' at Sta. 64+45
" 43159	41128	12-15-53 H.L. Austin, Erin Teleph. Co. Wire Xing over Sta. 2167+43 - Trans. to Houston County Telephone Co. Inc. 2-28-62
~~41019~~	~~[illegible]~~	~~[illegible]~~
~~[illegible]~~	~~[illegible]~~	~~[illegible]~~
" 14046	42598	12-5-55 Merriwether Lewis Electric Coop. - Wire xing over Sta. 2179+67
" 49711	8-13-57	County of Houston Disposal Pipe 4" Sta. 67231
~~[illegible]~~	~~[illegible]~~	~~[illegible]~~
" 15609	42787	8-5-57 " 2" water line across 1" Drain pipe at Sta. [illegible]
" 63894	10-24-57	County of Houston - Two 24" Drain Pipes 67150 & 67170

Sheet No. 201 of 111 of Memphis Line from survey station 2133+55 to survey station 2186+35

Valuation Engineer

STATION MAP
LOUISVILLE AND NASHVILLE R. R. CO.
MEMPHIS LINE
STATION 2133+55 TO STATION 2186+35
SCALE 1 INCH = 100 FT.
OFFICE OF CHIEF ENGINEER

Sch J 3
Sch I 2 4

V.25-2.21

042-004