A.F.E. 50675 12-12-58 Ret. Mail Crane

No.	Grantor	Grantee	Relinquisher	Date	Record	Cust. No.	Remarks
1	Jerry Sheehan	N.& N.W.R.R.Co.	Dead				See Note 1
2	John Welsh	N.& N.W.R.R.Co.	Dead				Title by possession
3	J.N.Simpson	N.C.& St.L.Ry.	Dead	Apr.25,1881	DB Y-114-May 14,1881	2011	
4	Bishop Miles	N.& N.W.R.R.Co.	Dead				Title by possession
5	J.H.Neal	N.& N.W.R.R.Co.	None				See Note 1
6	Patrick Doherty	N.& N.W.R.R.Co.	Dead	Feb.22,1880	Office of Secretary	3238	See Note 2
7	Hugh Foy	N.& N.W.R.R.Co.	None				See Note 1
8	J.H.McAdoo	N.C.& St.L.Ry.	Dead	Apr.25,1881	DB Y-115-May 14,1881	2012	

NOTE 1- Charter width claimed under decisions of Tennessee Courts.
NOTE 2- Deed provides for such additional right of way as may be required for the full and convenient construction, use and maintenance of the railroad.

Deed was built by the Nashville and Northwestern Railroad Company. See Minute Book [illegible] 485 of the Chancery records at Nashville for decree confirming sale to the Nashville and Chattanooga Railroad Company, whose name was later changed to the Nashville, Chattanooga & St. Louis Railway.

9	Florence Ridings	N.C.& St.L.Ry.	Deed	July 5.1916	DB-33, 77, July 25.1916	3403
10	W.B. Rumsey	N.C.& St.L.Ry.	Deed	July 7.1916	DB-33, 79, July 25.1916	3410
11	John Faurote	N.C.& St.L.Ry.	Deed	July 3.1916	DB-33, 80, July 25.1916	3409
12	Joseph Fey	N.C.& St.L.Ry.	Deed	Aug. 2.1916	DB-33, 114, Aug. 11.1916	2178
13	A.L. Reigle	N.C.& St.L.Ry.	Deed	Oct. 19.1923	DB-39, 323	3790

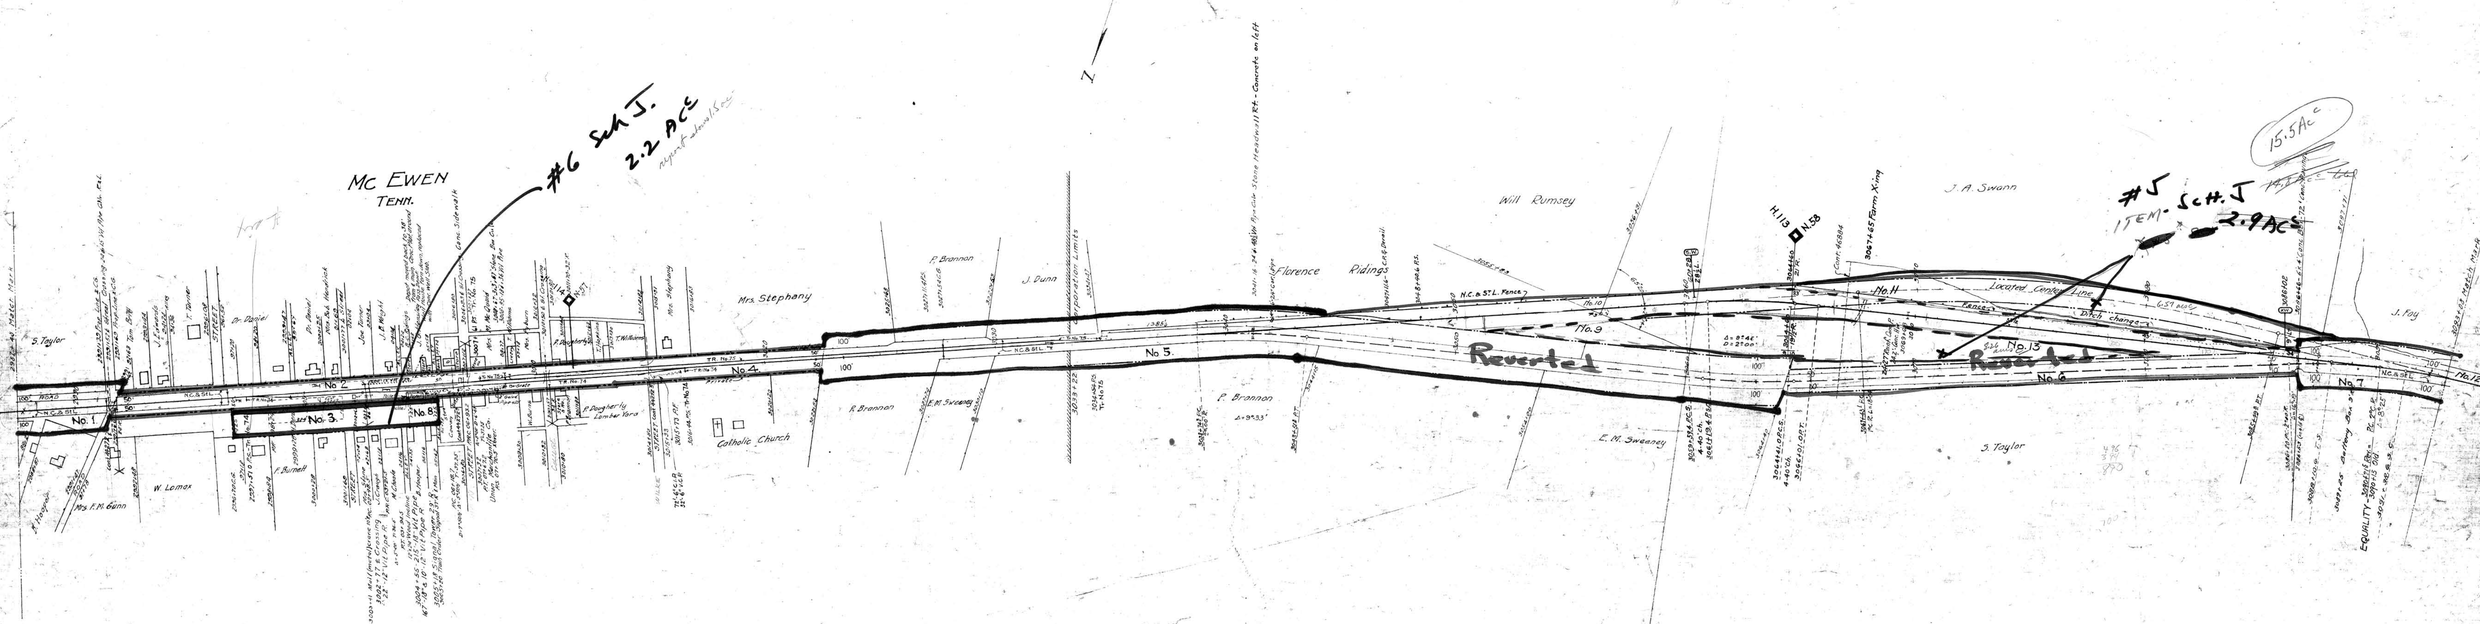

On this sheet all the fences along the track are the property of the N.C.& St.L. Ry.
Except from Sta. 2996+70 to Sta. 3027+54 all these fences thru the town are private

LF 43925 Cont. 44272 4-23-58 Humphreys Co. Utility Dist. ~ 3-2" Gas Pipes Under Trk. Sta. 2991+57, 3006+43 & 3014+83
~~46886 10-12-60 Jimmie Moran ~ 1" water line Xing under sta. 3064+85~~ Canc. 6-4-64
47227 4-14-61 J.H. Stanford Loading platform V.S. 3000/64.6

HUMPHREYS, CO. TENN.

RIGHT-OF-WAY AND TRACK MAP

NASHVILLE, CHATTANOOGA AND ST. LOUIS RY.

NASHVILLE DIVISION

STATION 2987-48 TO STATION 3093+08
SCALE, 1 IN. 200 FT. JUNE 30, 1916

Sheet No. 29 of 27 Sheets of Nashville Div. Main Line from survey station 2987+48 to survey station 3093+08

OFFICE OF CHIEF ENGINEER
NASHVILLE, TENN.

Valuation Engineer

M.P. 565 to 585

043-004