A.F.E. # 54481 Rel. Portion of Station Plan. 3514+92 to 3515+53

NO.	GRANTOR	GRANTEE	INSTRUMENT	DATE	RECORD	BOOK NO.	REMARKS
1	John Wyly	N.& W.R.R.Co.	Deed				Title by possession
2	Jas.D.Nolan	John W.Thomas, Agent	Deed	Feb.14,1896	DB 10-1-Feb.15,1896	5186	
	Jno.W.Thomas Jr. et al	Tenn.Property Co.	Deed	May 15,1906	DB 20-358-My 23,1906	5189	
	Tenn.Property Co.	N.C.& St.L.Ry.	Deed	Jan.4,1916	DB 32-48-Jan.31,1916	1825	
3	Jas.Nolan	N.C.& St.Lou.Ry.	Deed	Aug.19,1895	DB 9-379-Aug.29,1895	2021	Agrees to keep open street
4			None				Title by possession
5			None				Track 4
6			None				Track 5
6			None				Title by possession
6	John Wyly		None				
	Jas.M.Nolan	J.W.Thomas Agt.	Deed	Feb.14,1896	DB 10-1-Feb.15,1896	5186	
	Jno.W.Thomas Jr.et al	Tenn.Property Co.	Deed	May 15,1906	DB 20-358-My 23,1906	5189	
	Tenn.Property Co.	N.C.& St.L.Ry.	Deed	Jan.4,1916	DB 32-48-Jan.31,1916	1825	
9	Jas.M.Nolan	N.C.& St.L.Ry.	Deed	Aug.19,1895	DB 9-379-Aug.29,1895	2021	Agrees to keep open street
10	T.H.Nolan et al	N.C.& St.L.Ry.	Deed	Sept.19,1912	DB 2-91-Sept.19,1912	2006	
11	Mrs.T.H.Nolan	N.C.& St.L.Ry.	Deed	Jan.10,1903	DB 16-413-Jan.10,1903	1998	
12	Mrs.T.H.Nolan	N.C.& St.L.Ry.	Deed	Jan.10,1903	DB 16-413-Jan.10,1903	1998	
13	Mrs.T.H.Nolan	N.C.& St.L.Ry.	Deed	Oct.23,1902	DB 16-227-Oct.23,1902	1997	
14	T.J.Little	N.& W.R.R.Co.	Deed	June 23,1859	Office of Secretary	3154	See Note 1
15			Plan				Track 3-Gravel Spur
16	Mary Crin	N.& W.R.R.Co.	Deed	June 23,1859	Office of Secretary	3255	See Note 1
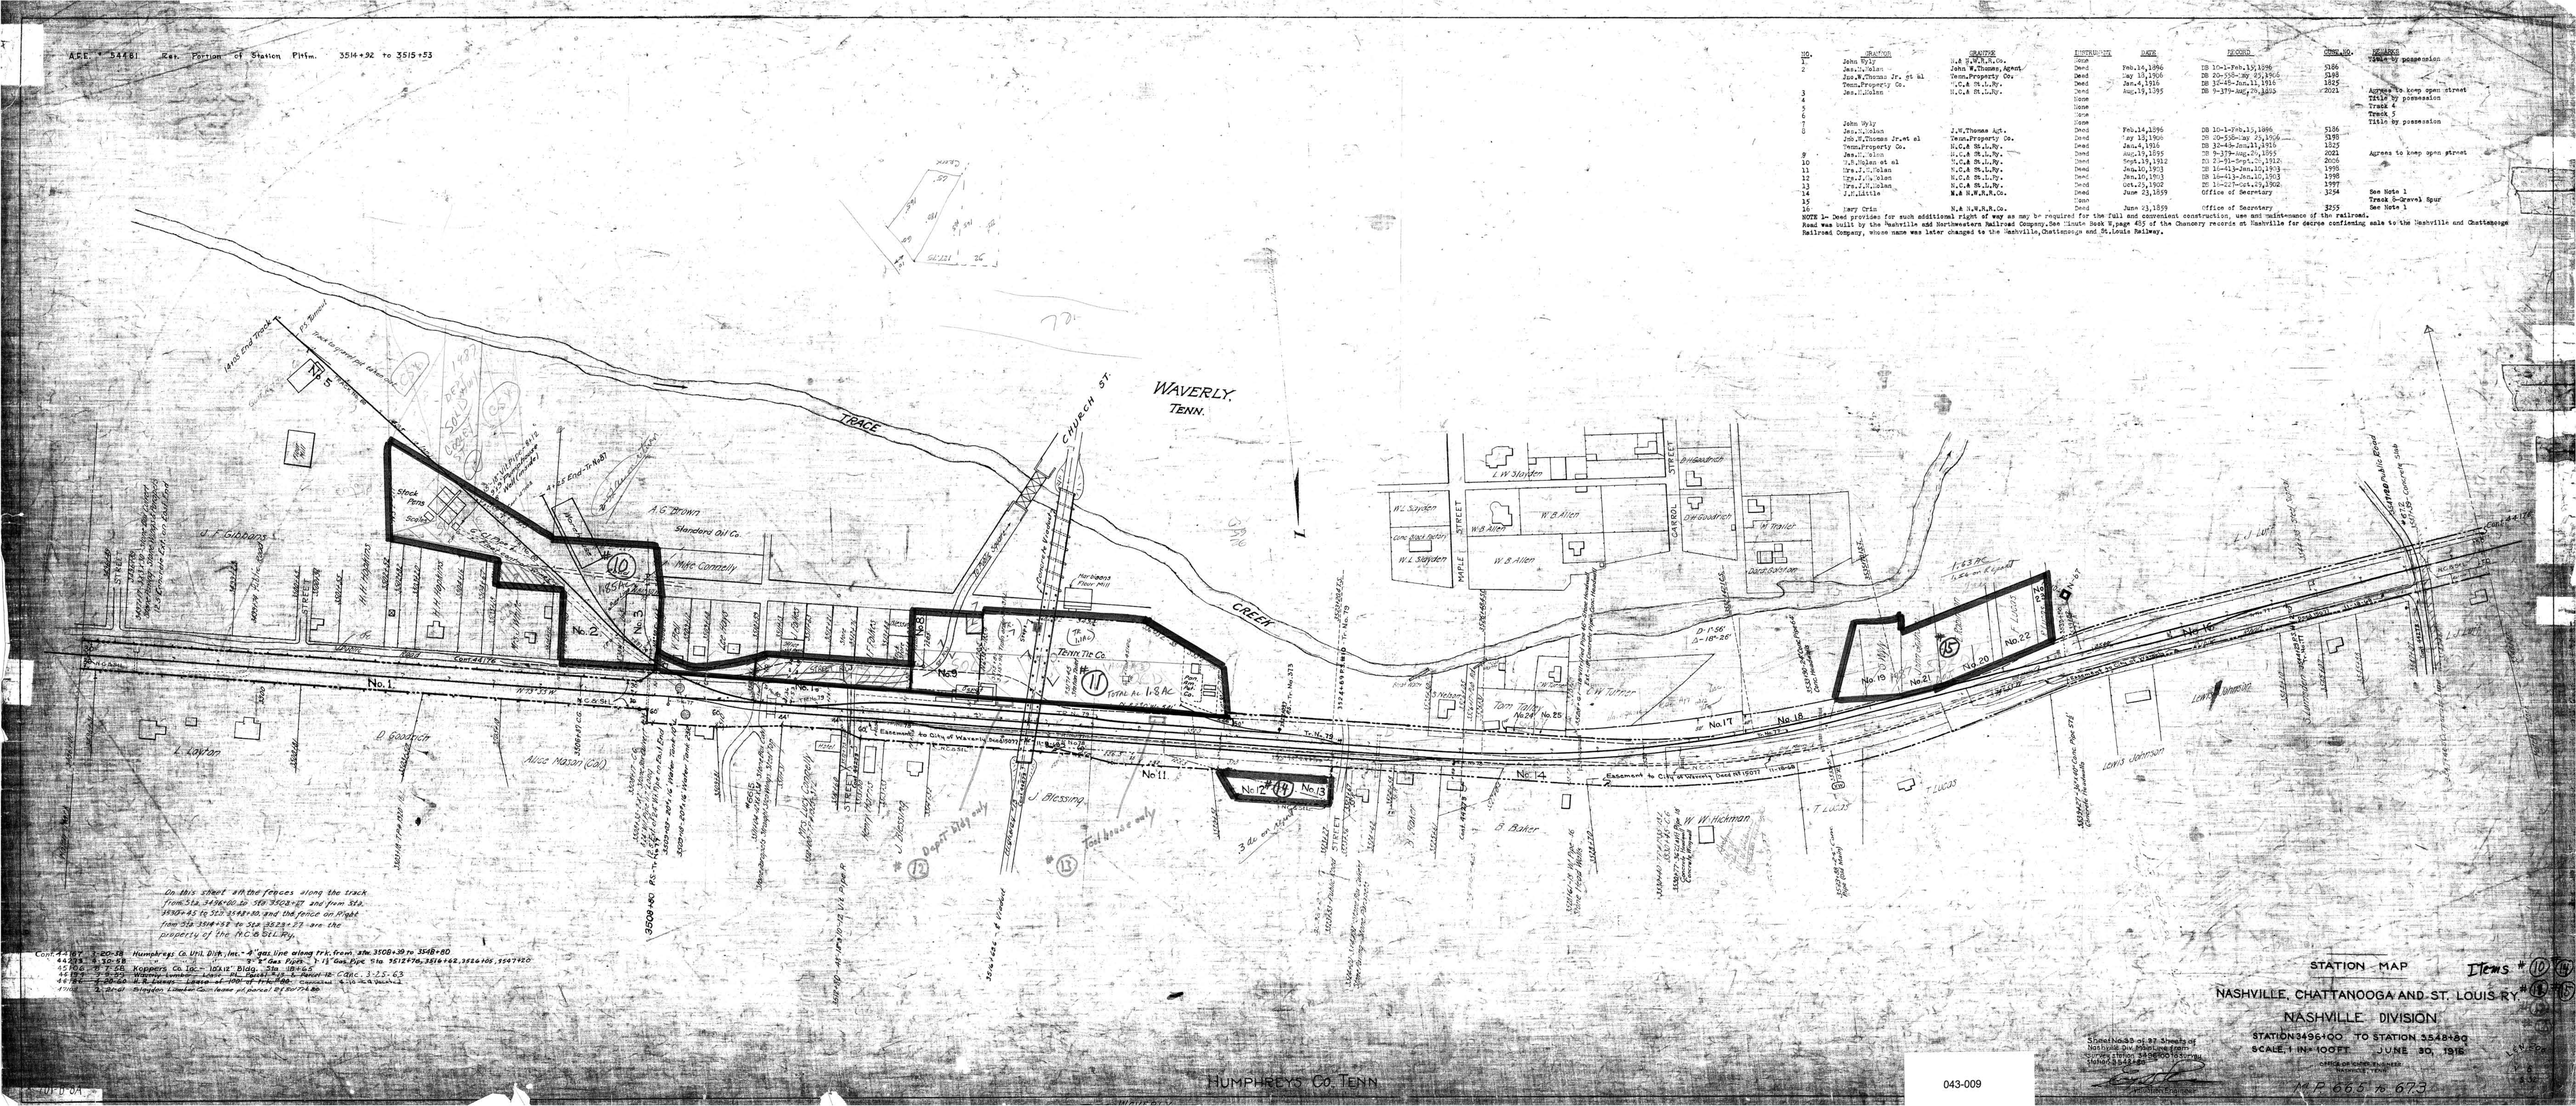
NOTE 1- Deed provides for such additional right of way as may be required for the full and convenient construction, use and maintenance of the railroad.
Road was built by the Nashville and Northwestern Railroad Company, See Minute Book W page 455 of the Chancery records at Nashville for decree confirming sale to the Nashville and Chattanooga Railroad Company, whose name was later changed to the Nashville, Chattanooga and St.Louis Railway.