A.F.E. #	DATE COMPLETED	DESCRIPTION
45045	4-23-54	Const. Trk 100 AB & JIM WITT - L&N OWNS 165' & WITTS 344'
46493	7-25-55	Rel. Sec. Farmers House
46784	6-30-56	Rel. Laborers "
47143	3-31-56	Rel. 2 sec. Passers & Watchmans shack.
48304	7-30-57	Rel. Part Parcel #D
40305	5-10-58	Const. trk. 119 for Wholesale Lumber Co.-R.S.® Sta. 194+31

No.	Grantor	Grantee	Inst.	Date	Record	Cust. No.	Remarks
PLB	L&N RR Co.	Wholesale Lumber Co.	Deed	2-23-57		440	
"	" " "	Diamond Hill Plywood	"	" " "		440	

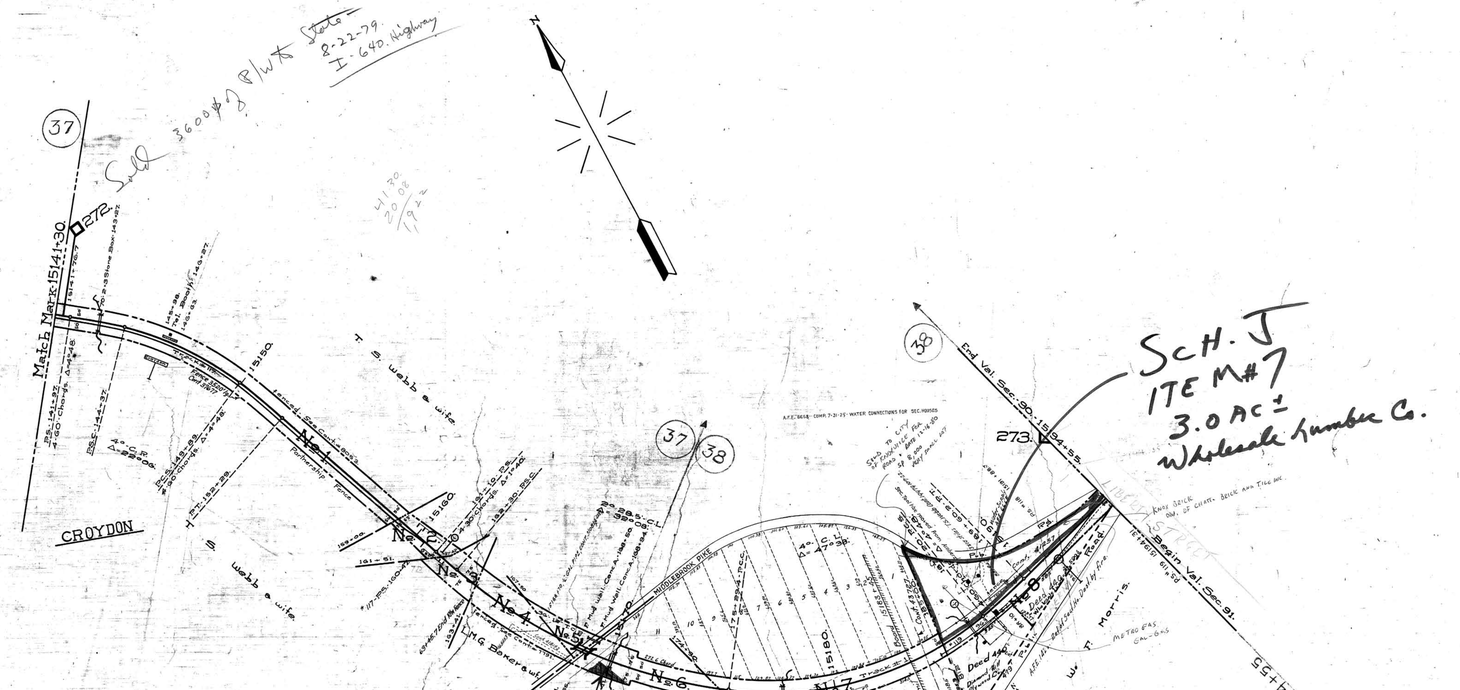

L.F. No.	CONT.	DESCRIPTION
L.F. 19000-90	Cont. 30185	C.W. Siler B.W.Va. 600' Partnership Fence. 01+72.6 South
	~~40805~~	AB & JIM WITT BUILDING MATERIAL CO. Lease of Part of Par No. 8
	~~41257~~	3-1-54 AB & JIM WITT BUILDING MATERIAL CO. Const. Of Trk No. 118 Sta. 15151+81 Const. 7-7-57
	~~41261~~	3-1-54 Atlas Gas Company lease of par. C-P-118A
	~~41263~~	10-22-54 Rel. 4 Tenant Sites
	~~41257~~	7-7-55 AB & Jim Witt Bldg Mat Co. Lease of Part of Par 8
4315	" 41257	3-27-55 Mem. tran. Wholesale Lumber Co.
39648	" 41257	3-1-54 AB & Jim Witt Bldg. Mat. Co. Const. Trk 118 - 3-5-54 use extended Atlas Gas Co. - 12-27-55 Mem. trans Wholesale Lumber Co., 12-28-55 use extended Atlas Gas Co. User Metro Gas Co. 9-29-56
	" 43088	5-21-56 City of Knoxville Wire X'ing Sta 15178+80.4
	" 43655	11-29-56 Wholesale Lumber Co. Const. Spur trk. #119, 943 ft. Eq. FS. L94+31. Memo User D.C. Russell - 11-29-56 Memo User Diamond Hill Plywood Co. 11-24-56); User, 10-25-60 Knoxville Sheet Metal Works
6855	" 43721	7-22-57 City of Knoxville water X'ing Sta. 15184+20.
	" 48740	10-25-60 Knoxville Sheet Metal Works, 2.5' Concrete Pier and Steel Column for overhead crane on Rel. of R.S. Bo 120 & R.S. Bo 133
CE 39648	~~45445~~	~~7-11-62 Phoenix Lumber Co. Lease of 0.24 Ac. (Sch. J) Cancel to Cont. #119~~ CMC

T/W is fenced on both sides from Sta. 15141+30 to Sta. 15159+00.
" " " " right " " " 15159+00 " " 15168+80.
" " " " both " " " 15168+80 " " 15194+55.

Knox Co. Tenn.

90-34

RIGHT OF WAY AND TRACK MAP
LOUISVILLE AND NASHVILLE R. R. CO.
KNOXVILLE DIVISION
STATION 15141-30 TO STATION 15194-55
SCALE-1 INCH=200 FT. JUNE 30 1917
OFFICE OF CHIEF ENGINEER, LOUISVILLE, KY.

Sheet No 34 of 39 of Knoxville Division from Survey Station 15141+30 to Survey Station 15194+55

Valuation Engineer

047-011

Y90 34

16-2