L.F.	CONT.	DATE	DISCRIPTION
27078	40970	11-11-53	Power line crossing at Sta. 1436+26, City of Lawrenceburg
43610	~~43496~~	~~6-1-57~~	~~Lebridge Telephone Exchange 4 toll cables under tr. sta. 94-32~~ Canc.

No.	Grantor	Grantee	Instrument	Date	Record	Cust. No.	Remarks
1	No deed covering - Charter Width claimed						
2	H.B.Howell	N.F.S.R.Co.	Deed	Feb. 2,1853	D.B.XXX P.616 Feb.27,1853	61	
3	Hugh Carothers	"	"	Dec. 2,1851	D.B.XXX P.615 Sep.27,1853	38	

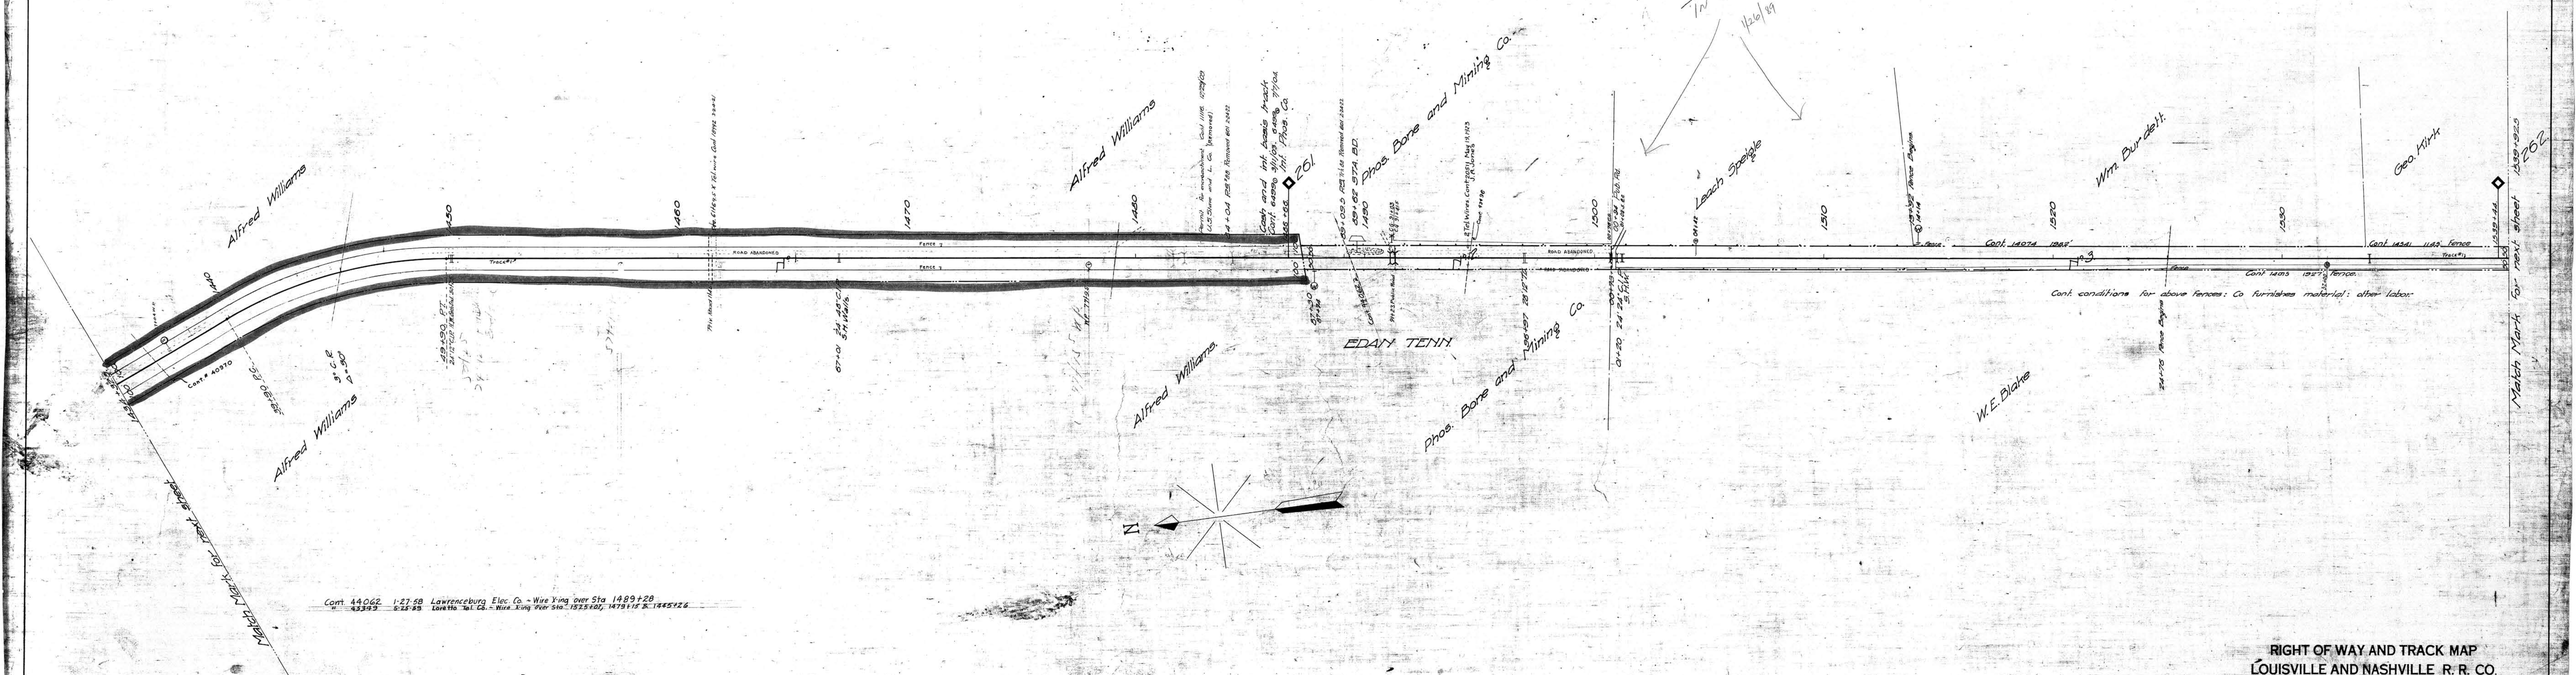

Cont # 40970

Cont 44062 1-27-68 Lawrenceburg Elec. Co. - Wire Xing over Sta 1489+28

19-15

LAWRENCE CO., TENN.

RIGHT OF WAY AND TRACK MAP
LOUISVILLE AND NASHVILLE R. R. CO.
NASHVILLE, FLORENCE AND SHEFFIELD DIVISION
STATION 1434-32.5 TO STATION 1539-92.5
SCALE- 1 INCH = 200 FT. JUNE 20 1917.

SHEET NO 13 OF 22 OF NASHVILLE FLORENCE AND SHEFFIELD DIVISION
FROM SURVEY STATION 1434+32.5 TO SURVEY STATION 1539+92.5

OFFICE OF CHIEF ENGINEER
LOUISVILLE, KY.

ENGINEER

050-005

13

14-1