A.F.E. No.	Date Comp.	Desc. of Change
80	7-16-19	Orig. Cost Stock.
8335	1-27-27	Const. of sewage facilities at Engleewood
10264	5-11-28	Install of Electric Light Fixtures
13329	11-30-29	Const. of Sub. at Sta. 17991 (Sub. 1007+ 1.19)
6122	9-25-23	Const. of Sub. at Sta. 17991 (Sub. 1007+ 1.19)
6556	8-22-25	Inst. of 25' of 2" pipe water line (Report's Engineering Dept.)
11339	2-17-31	Not of track 59 Team
54603	4-18-46	Inst. Spring Switch at Sta. 18000 + 52, T.T. No. 1 Yd.
56396	4-3-47	Mt. Adv. Building (Min. Adj. 1947-2017)
38983	10-21-49	Rel. Stock Pens
42412	9-31-53	Construction of crossing truck 36' x 0.75 acres, 1/2 W. acquired
43528	8-16-53	Retirement of Spec. Lab. House V.S. 17991+55
46572	2-8-57	Rel. Spec. House By Sub. to Mrs. Bertha Williams Sta. 17998+25'
48869	11-21-56	Rel. 240' 2"x8" Timber Cut & Trim. Sta. 18000 Rt. 14.00' to 26.0'
49496	2-11-58	Ret. Tool Hse. Sta. 17993+10
51881	2-10-60	Rel. 2 Spec. Hses & 2 Toilets. Sta. 17993+10 & 18215 & 18255 (in Mt. Adv. Inst. Hse.)
53273	12-31-63	Const. Fence
55083	[illegible]	[illegible]
58133	3-18-65	Ret. of comm. equipt. in depot at Englewood and install tel. in box outside of depot

No.	Grantor	Grantee	Instrument	Date	Record	Cust. No.	Area	Remarks
1/16		Print To	6-30-17					
17	Uncle Bowers & wife	L.&N. R.R. Co.	Deed	9-21-50	[illegible]	[illegible]	0.13 A.	R/W Cal.
18	R.S. Miller & wife	L.&N. R.R. Co.	Deed	12-11-50	[illegible]	13963	0.12 A.	" "

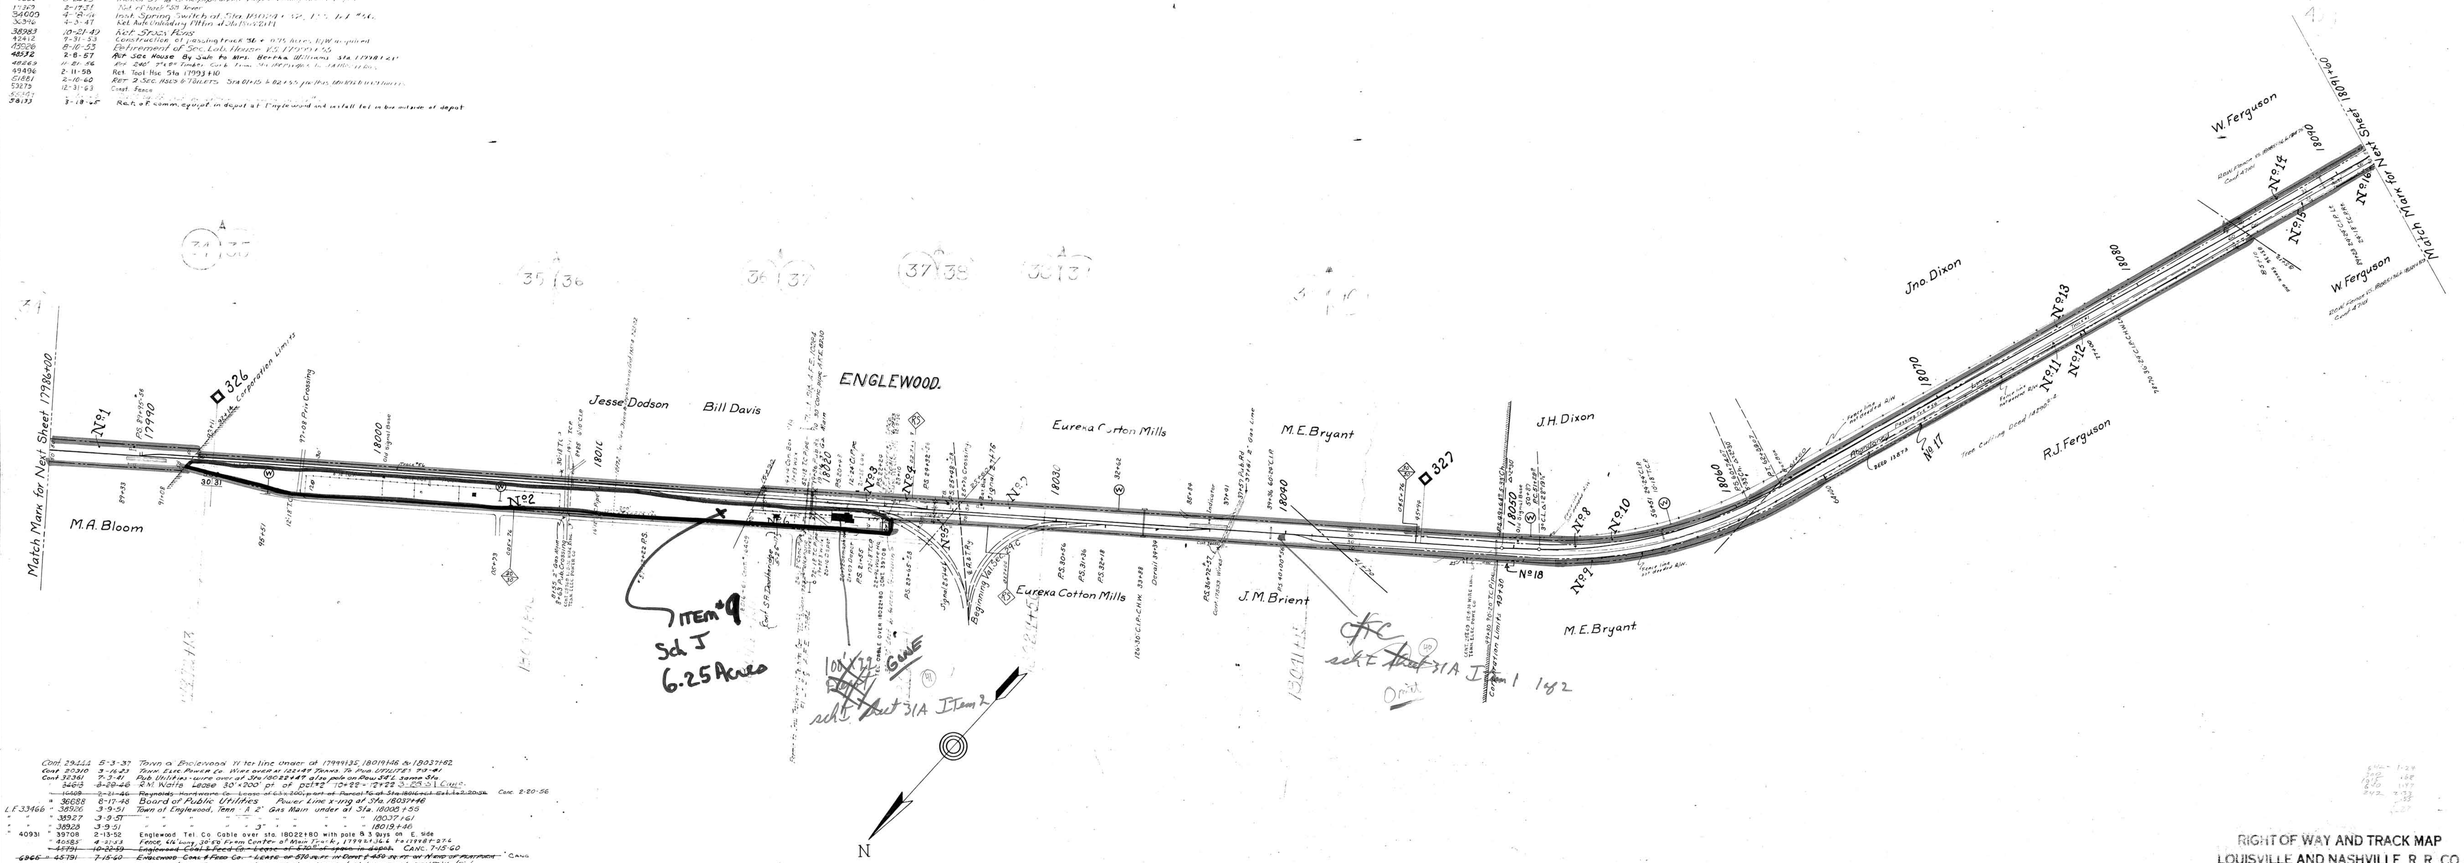

Cont. 29444	5-3-37	Town of Englewood 11 ter line chgs. of 17999135, 18019146 & 18037162			
Cont. 30340	3-16-43	Tenn. Elec. Power Co. Wire over at 18148 & Poles 19 from 17991571 P.S. 41			
Cont. 30341	7-3-41	Pub. Utilities wire over at Sta. 18022+47 & to pole on Pow. St. & same Sta.			
54863	8-29-46	RM Watts 18088 30'x200' pt. of pc 42 10+22 - 12+22 3-29-31 Cancel.			
~~10608~~	~~5-21-46~~	~~Reynolds Hardware Co. Lease of 6.25 Acres part of Parcel 9 at Sta. 18042 Rt. 1.0 to 200 ft.~~			Canc. 2-20-56
" 36658	8-17-48	Board of Public Utilities Power Line x-ing of Sta. 18037+46			
L.F. 33466 " 38506	3-9-51	Town of Englewood, Tenn. 8 2" Gas Main under at Sta. 18035+59			
" " 38927	3-9-51	" " " " " " " " "			18037+61
" " 38928	3-9-51	" " " " " " " " "			18019+46
" 40931 " 39708	2-13-52	Englewood Tel. Co. Cable over sta. 18022+80 with pole # 3 Guys on E. 966			
" 40585	4-21-53	Fence, 4½' long, 38.68' From Center of Main Track, 17999+63.64 Pc 17998+27.4			
~~" 45791~~	~~10-21-59~~	~~Englewood Coal & Feed Co. Lease of 576 sq. ft. on Sta. 18091 Rt. 14.0 to 26.0 ft.~~			~~Canc. 7-15-60~~
~~6966 " 45791~~	~~7-15-60~~	~~Englewood Coal & Feed Co. Lease of 576 sq. ft. on Cont. 6 450 sq. ft. at Head of Platform~~			Canc.
47041	2-3-61	Cl. Improvements Bird House on deck 36' L. & 4 posts flat side 1 Porch 16 & 1 Toilet Wash Stand			

RIGHT OF WAY AND TRACK MAP
LOUISVILLE AND NASHVILLE R. R. CO.
KNOXVILLE DIVISION
STATION 17986+00 TO STATION 18091+60
SCALE- 1 INCH = 200 FT. JUNE 30 1917.

SHEET NO. 26 OF 91 OF KNOXVILLE DIVISION PROM SURVEY
STATION 17986+00 TO SURVEY STATION 18091+60

CHIEF ENGINEER
LOUISVILLE, KY

054-010

V-29
26

29-26

McMINN CO., TENN.