Ale No.	Date	Description of Change
29084	12-2-41	Refiles 7-43A(Ale)
31261	2-3-4	343-B TCA To drain S. Hanapipe Cornersville, Tenn.
33214	2-3-45	Inst of tile drainage at M.P. 247
30558	1-7-43	Ref. Mail Crane
42310	1-2-49	Unassigned Culvert at Stock Pens. Sta. 47+72.
42310	57	Refile Outside Toilet at Cornersville
46761	57	" " " "

						Date	Report		
	Grantor	Grantee	Price						
1	Hugh Swiney	R.R.Co.	Cash			Dec.15,1911	D.B.X-2	P.431	May 8,1911
2	Hugh Swiney	"	"			May 5,1913	D.B.X-2	P.233	Dec.17,1913
3	J.W.Rosson	"	"			Jun. 1,1912	D.B.X-2	P. 97	Jun. 5,1912
4	L.& N.R.R.Co.	Hugh Swiney	"			May 3,1912			
5	L.& N.R.R.Co.	R.R.Co.	"			May 27,1911	D.B.X-2	P. 46	May 8,1911
6	S.H.Polk	"	"			May 4,1912	D.B.X-2	P.232	Dec.17,1912
7	S.H.Polk	"	"			Apr.27,1911	D.B.X-2	P. 46	May 8,1911
8	G.W.Bates	"	"			Jul.22,1911	D.B.X-2	P.280	Jul.22,1911
9	J.S.Cook et al	"	"			Jul.14,1911	D.B.X-2	P.213	Jul.21,1911
10	A.C.Beatty	"	"			Jun.17,1911	D.B.X-2	P.168	Jun.19,1911
11	M.E.Moore et al	"	"			Jul.13,1911	D.B.X-2	P.182	Jul.13,1911
12	J.T.McClintock	"	"			Jul.21,1911	D.B.X-2	P.222	Jul.21,1911
13	B.London	"	"			Jul.13,1911	D.B.X-2	P.217	Jul.21,1911
14	Sylvia Kennedy et al	"	Condemnation Case			Jul.22,1911	D.B.T-2	P. 27	Nov.16,1911
15	J.D.Edwards	"	"			Apr.25,1912	D.B.X-3	P.102	Oct. 2,1914
16	St.Mathews A.M.E.Church	"	"			Aug.16,1911	D.B.X-3	P.403	Oct.21,1914
17	Walter Rainey	"	"			Jul.10,1911	D.B.X-2	P.158	Jul.10,1911
18	Mrs. A.A.Mackleroy et al	"	"			Aug. 3,1911	D.B.X-2	P.200	Sep. 8,1911
19	W.G.Wilkinson	"	"			Apr.27,1911	D.B.X-2	P. 16	May 8,1911
20	J.F.James	"	"			Apr.27,1911	D.B.X-2	P. 73	May 8,1911
21	J.F.James	"	"			Apr.30,1914	D.B.X-3	P. 88	Jun.27,1914
22	W.B.London	"	"			Jul.12,1911	D.B.X-2	P.169	Jul.12,1911

Notes:
1 - R.R.Co. paid Hugh Swiney $300.00 to remove barn from right of way - Contract No.14660
2 - R.R.Co. paid S.H.Polk $24.00 for two small buildings conveyed to Marshall County for change of road
3 - R.R.Co. paid A.C.Beatty $180.00 to remove outhouse from right of way
4 - R.R.Co. paid J.T.McClintock $25.00 " " " " - Contract No.14664
5 - " " B.London $90.00 " " " " - Contract No.14664
6 - " " Judge Pillow $100.00 " " " " - Contract No.14663
7 - " " A.C.Rainey $4.00 " " " "

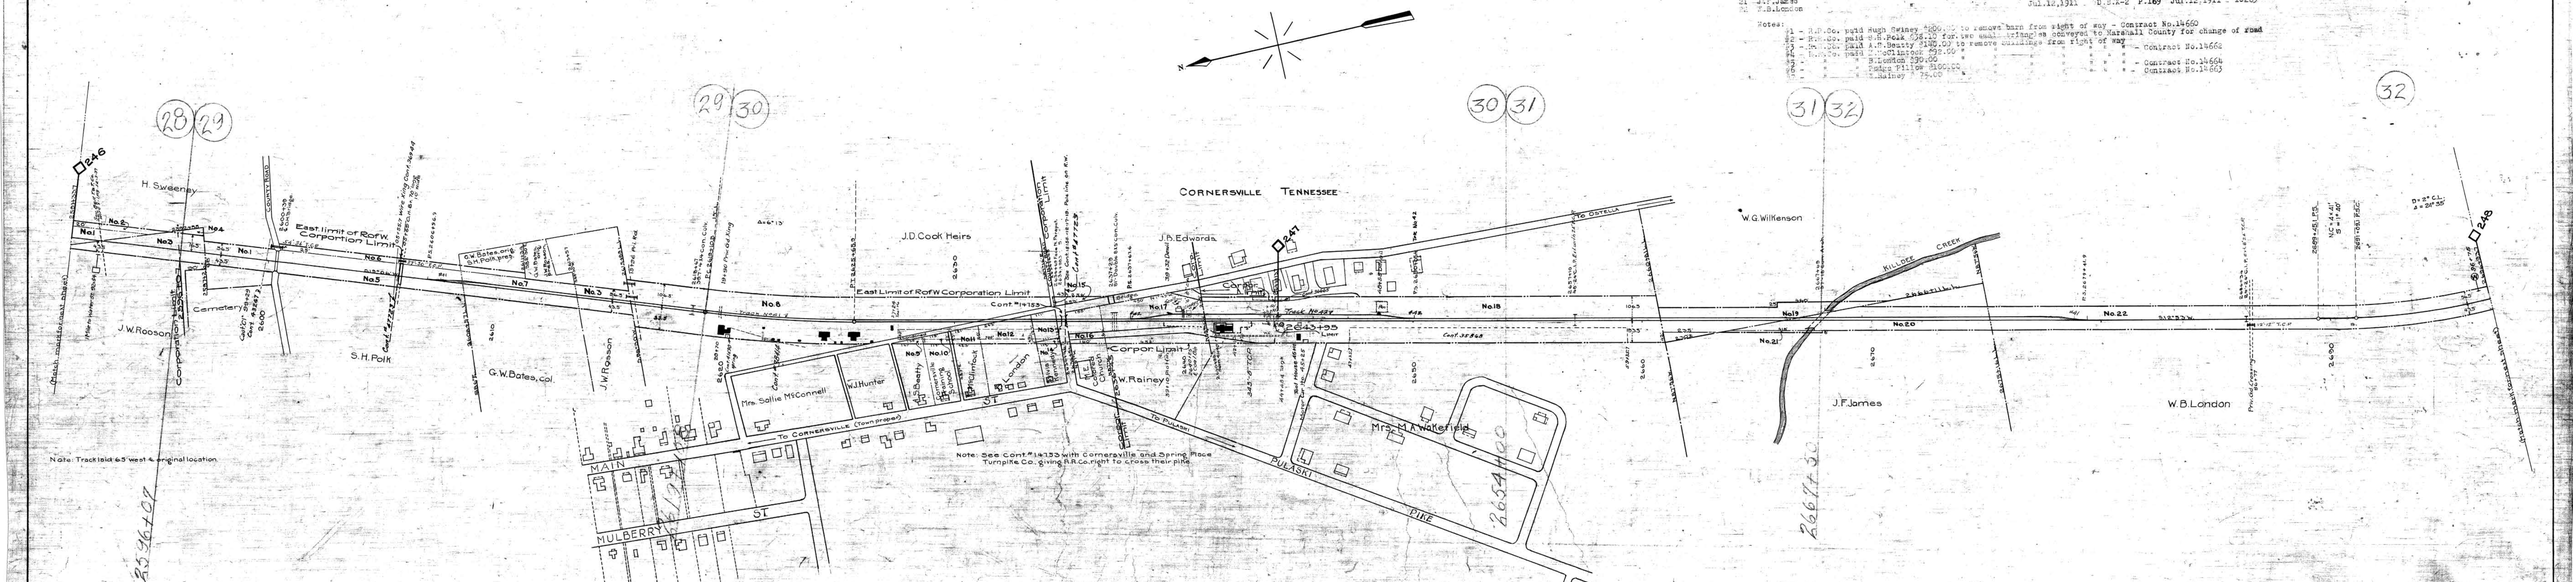

Cont. 29084 5-12-36 City of Cornersville Gas Light plant on Row 29084A - Cont.
" 32683 1-14-42 Duck River Elec Membership Co. Elec. wire over r/w Sta 2599+49±
" 32683 3-24-42 " " Power line with pole over at Sta 2634+28
~~32334 6-8-45 McRobert Sheet metal & P.T. Co. Building (Conc.)~~
" 33234 8-11-46 H.E.Park - Unloading pit under TA'42 Sta 2612±. Cancelled.
L.F. 40212 " 33848 8-15-47 R.H.Largen Lease at 45° skew of R/W sta. 4747.51 to 53+80
" 40943 " 36662 7-31-48 J.H.Leonard Additional Stock pens & Wagon scales at Sta 2647+79.3
" 31676 " 34144 11-5-48 Duck River Electric Membership Corp. Wire xing over at 2605+55.7
" 34935 " 34254 11-24-48 H.D.Cliff Permit to const scale and Coal bin and conveyor pit on R/W and lease 2 carlengths of 112'42 Sta 2660±25
" 40431 " 36665 6-25-49 John H. Leonard Lease R/W 15'x160' E. side of Trks Sta. 4314.037 to 44+63.7
" 31676 " ~~38414 7-27-50 Duck River Electric Membership Corp. Anchor guy & 2 power poles (18'x) on sta. 2660+40.7 (Conc.)~~
" 43046 " ~~40361 7-19-51 W.F. Oliver 4'x5' concrete block pumphouse (12'x12') water line, 1 pole, and 2 wires Sta. 2630+34± (Conc.)~~
" 40861 " ~~41227 2-2-52 J.D. Cook Water Line in the 2620±s Conc. 10-14-58~~
" 41630 10-14-58 Roy Ashton - 20'x20' spring - sta. 2620+10 - Trans. 1-5-60 H.E. Holland
" 40861 " ~~42067 2-20-59 R.B. Lum - 1-1.5 cou. Block Pumphouse 1-1.5' Water Line, 1 Pole and 2 Wires Sta 2670+44.5 Conc. 5-14-63~~
~~30697~~ " ~~42372 6-23-60 Town of Cornersville (Pl.) Water Line at Sta. 2644+28.7 Conc. 6-22-63~~
~~44515~~ " ~~44424 7-12-60 C.L. Richardson - 4'x4' in 90' tile, Trans. 2 and Sta 2613+50 to 2619+50 (Abandoned)~~
" 47123 8-18-61 Town of Cornersville, Tenn. - Water Line X-ing Sta. 2645+16.5 & Sta. 2694+83.4

Sheet No 26 of 42 of Lewisburg Division from Survey station 2591+33.7
to Survey Station 2696+93.7

Valuation Engineer

RIGHT OF WAY AND TRACK MAP
LOUISVILLE AND NASHVILLE R. R. CO.
LEWISBURG DIVISION

STATION 2591+33.7 TO STATION 2696+93.7

SCALE: 1 INCH = 200 FT. JUNE 30 1917.

OFFICE OF CHIEF ENGINEER
LOUISVILLE, KY.

V.16
2.6

059-021

16-2.6

MARSHALL COUNTY TENN.