A.F.E. No.	Date Comp.	Description of Change
10783	4-30-28	Waiting room ret. at Sta. 5190+72
11153	5-8-28	Stock pen removed
11411	10-27-28	Track #25 removed
14831	12-9-30	Tow/lease at Glendale trans. to Nashville.
14135		Removing Grade on Br. 179
21081	3-8-37	Sold Sec. house, layout Bldgs only (par. 3) land not sold
25171	9-11-46	INSTALLATION OF TRACK MTR. SIDING
28622	9-17-35	" " Box Car Used as Freight Ho. since

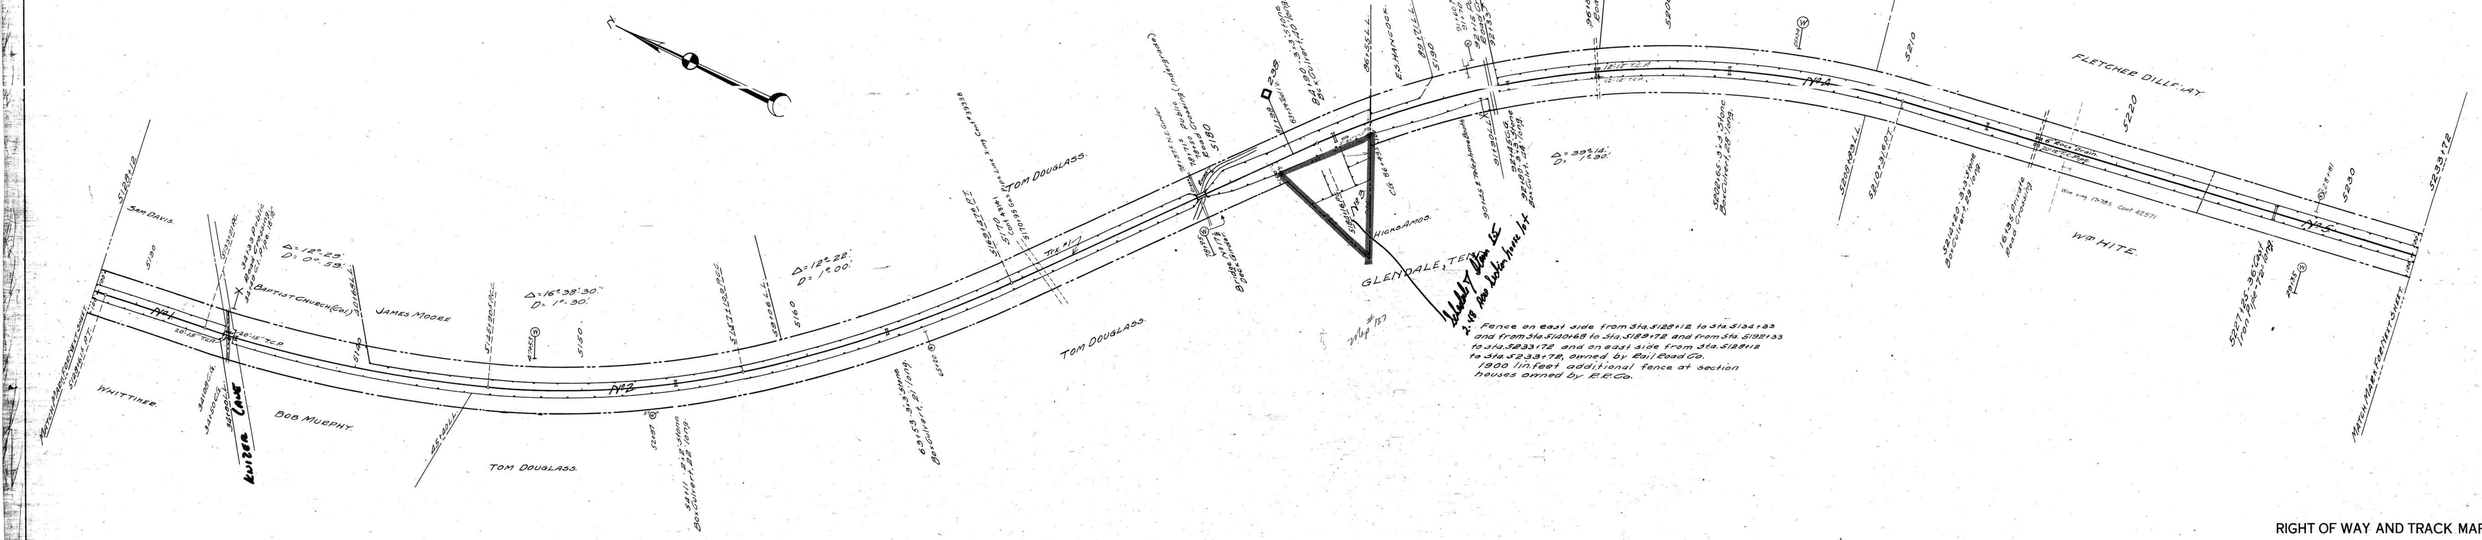

Cont. 26732	9-14-33	Sec. Lab. House leased to John Wilkins
" 17323	8-10-61	City of Columbia Power Sys. - Wire over at Sta. 34+60 & 91+82.
L.F. 39847 - 39338	6-3-51	Texas Eastern Trans. Corp. 30" Gas Pipe Line Xing under Sta. 5170+95
" 35476 - 42571	12-29-65	Columbia Power System. Guy and Power line crossing over Sta. 5176+85
43141	9-20-56	Texas Eastern Trans. Corp. 30" Gas Pipe Line Xing Under Sta. 5170+70
~~45943~~	~~1-29-57~~	~~James Douglass Lease of Parcel #3~~ Canc. 8-16-67

SHEET NO. 25 OF 56 OF NASHVILLE AND DECATUR DIVISION FROM SURVEY STATION 5128+12 TO SURVEY STATION 5233+72

VALUATION ENGINEER.

RIGHT OF WAY AND TRACK MAP
NASHVILLE AND DECATUR R. R. CO.
OPERATED BY
LOUISVILLE AND NASHVILLE R. R. CO.

STATION 5128+12 TO STATION 5233+72

SCALE-1 INCH = 200 FT. JUNE 30, 1917.

OFFICE OF CHIEF ENGINEER
LOUISVILLE, KY.

Sch J 15

V.14
125

060-013

14-25.

14