NO.	GRANTOR	GRANTEE	INSTRUMENT	DATE	RECORD	CUST. NO.	REMARKS
1	R. UREY / F.W. MATTHEWS	N.I.N.W.R.R.CO.	DEED	7-10-1854	OFFICE OF SEC.	3362	SEE NOTE 1
2	J. H. ROULHAC	N.C.&ST. L. RY.	"	8-23-'81	D.B."T" N°2-446, P.439-1881	2.592	
3	UNION CITY	" "	AGREEMENT	2-18-1915	OFFICE OF SEC.	CONT. 1163	CONST OF CULV.
4			NONE				TITLE BY POSSESSION
5			"				M.I.O. CROSSING
6	G. W. GIBBS	N. I.N.W. R.R. CO.	DEED	3-21-1847	D.B."P"-213, 4-5-1847	2.591	TITLE BY POSSESSION
7			NONE				L.N.R. ST. X-ING
8			"				TITLE BY POSSESSION
9			"				HOBBS ST. & 2ND ST. X-ING
10			"				TITLE BY POSSESSION
11			"				" " "
12			"				" " "
13	UNION CITY ICE CO.	N.C.&ST. L. RY.	"				
14	E. E. PERKINS	T.W. THOMAS, AGENT	DEED	10-14-1898	D.B."H" 206-11-8-1898	F142	
	T.W. THOMAS JR. et ux.	TENN. PROP. CO.	"	9-18-1906	" "2" 617-7-25-1906	F501	
	TENN. PROP. CO.	N.C.&ST. L. RY.	"	1-4-'16	" "D-N°8" 315-1-4-'16	1822	
15	EDWARDS & PERKINS	T.W. THOMAS, AGENT	"	5-25-1897	" "C-"4" 199-3-3-1897	F161	
	T.W. THOMAS JR. et ux.	TENN. PROP. CO.	"	9-18-1906	" "2" 617-7-25-1906	F501	
	TENN. PROP. CO.	N.C.&ST. L. RY.	"	1-4-'16	" "D-N°8" 315-1-4-'16	1822	
16			NONE				GROVE ST. X-ING
17	J. D. DIXOKS	N.C.&ST. L. RY.	DEED	7-9-1915	D.B."D-N°8"-43-7-17-1915	2595	
18			NONE				TITLE BY POSSESSION

NOTE 1 – DEED PROVIDES FOR SUCH ADDITIONAL R/W AS MAY BE REQUIRED FOR THE FULL & CONVENIENT CONST., USE & MAINT. OF THE R.R.

NOTE 2 – FROM NASH. TO UNION CITY, RR. WAS BUILT UNDER CHARTER OF THE N.K.N.W. R.R. CO. FROM UNION CITY TO HICKMAN UNDER CHARTER OF THE HICKMAN & OBION R.R. CO. THE TWO CONSOLIDATED & WAS PURCHASED BY THE N.C.&ST.L. RY. SEE M.B. W-PAGE 487. CHANCERY RECORDED AT NASH. FOR DECREE CONFIRMING SALE TO THE N.C.&ST.L. RY.

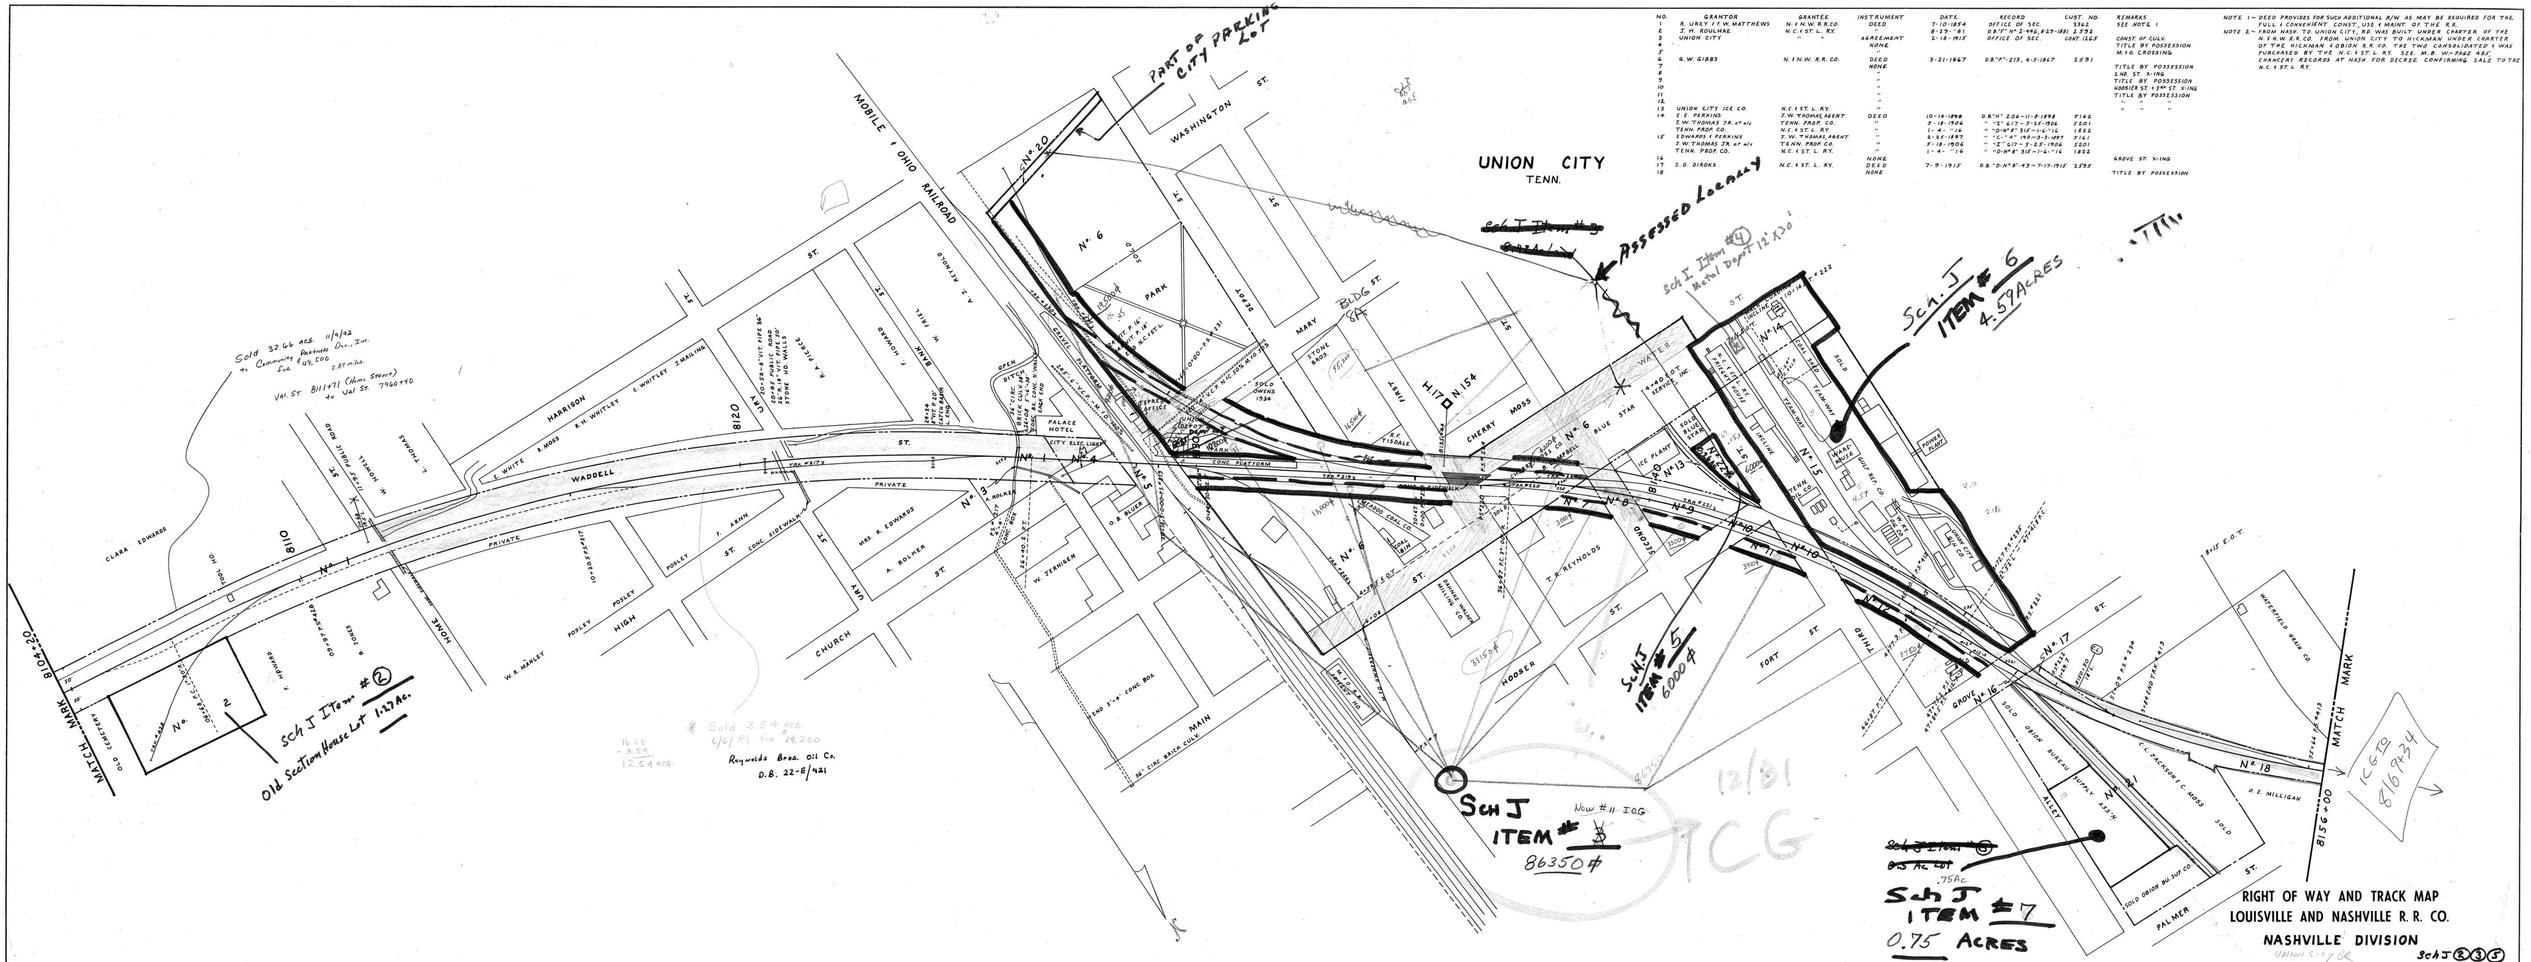

RIGHT OF WAY AND TRACK MAP
LOUISVILLE AND NASHVILLE R. R. CO.
NASHVILLE DIVISION

Union City Br.

Sch J ② ③ ⑤

Sch J ④

STATION - 8104+20 TO STATION - 8156+00

SCALE 1 INCH = 100 FT.

066-030

OFFICE OF CHIEF ENGINEER
LOUISVILLE, KY.

DRAWN BY - M. R. V.P. REVISED & REDRAWN 11-2-70

V.206
5-76

OBION CO., TENN.

V.206 ~ 5-76