PROPERTY CHANGES-CONT.

A.F.E. No.	DATE	DESCRIPTION
1170	12-12-29	Replace 1 set untreated swith ties with creo. swith ties in Trk. #78.
592	12-31-29	Apply add. ballast to Main Track. Mile 85=226 Cu.Yd. Mile 86=247 Cu.Yd.
1577	1929	Construct R/W Fence. N side, sta. 4494+40 to 4497+31. S. side, sta. 4494+40 to 4525+50. Retire R/W fence. N side, sta. 4494+40 to 4502+32. S. side, sta. 4494+40 to 4529+70.
1002	4-23-30	Apply add. tie plates. Mile 85=1022-7"x9". Mile 86=354-7"x8½".
1114	12-31-30	Apply 77 Cu.Yd. add. Stone ballast-Mile 85.
1190	May, 1931	Apply add. 7"x9" tie plates. Mile 85=394. Mile 86=372.
1240	12-31-31	Apply 372 Cu.Yd. add. Stone Ballast-Mile 85.
1474	12-31-31	Replace unf. cross ties with creo. cross ties. Mile 85=297. Mile 86=90.
1606	1931	Construct R/W Fence. N side, sta. 4502+32 to 4512+60. Retire R/W Fence. N side, sta. 4502+32 to 4512+60 and sta. 4512+90 to 4529+70.
1300	6-24-32	Apply 210 add. 7"x9" tie plates-Mile 85.
1353	12-31-32	Apply add. Stone Ballast to Main Track. Mile 85=34 Cu.Yd. Mile 86=34 Cu.Yd.
1467	12-31-33	Retire and replace R/W Fence. S. side, sta. 4436+26.5 to sta. 4444+34.
1563	Apr. 1935	Apply add. 7"x10" tie plates. Mile 86=30. Mile 86=268. Trk. #77=92.
1737	12-31-36	Place tie plates in M.T. Mile 85 & Track #78.
1924	10-18-37	Retire steel pens, Double Springs.
2003	12-31-38	Construct R/W fence. S. side Sta. 4523+55 to Sta. 4529+70.
2006	12-31-38	Place tie plates in M.T. Miles 85 & 86.
2073	7-31-39	Install underground gasoline tank at Tool House.

PROPERTY CHANGES SINCE JUNE 30, 1918.

A.F.E. No.	DATE	DESCRIPTION
564	4-30-21	Replace 60# Angle Bars with 60# 24" Cont. Jts. in Main Track. Mile 85=352. Mile 86=352.
701	1-21-22	Retire all roadway property by sale to T.C.R.R.Co.
58	2-1-22	Addition of all roadway property by purchase from T.C.R.R.Co.
253	12-31-23	Lay 80# rail. Main Track-Sta. 4424+10 to 4529+70. Trk. #77-121' W end and 180' E. end. Trk. #78-187'
321	3-7-24	Apply fourth chords to Br. #85.24.
345	11-20-24	Apply add. 7"x9" tie plates to Main Track. Mile 85=208. Mile 86=110.
1020	12-31-24	Apply 183 Cu.Yd. Slag ballast and convert 10 Cu.Yd. Cinder ballast to embankment-Mile 85. Apply 153 Cu.Yd. Slag ballast and convert 26 Cu.Yd. Cinder ballast to embankment-Mile 86.
1366	1925	Retire cross ties from Main Track. Mile 85=501. Mile 86=244.
399	2-10-26	Apply 1494 add. 7"x9" tie plates to Main Track.-Mile 86.
592	10-11-26	Replace Depot with frame Comb. Station 20'x64'x15' with 2 platforms 1-10'x15' and 1-8'x68' at Double Springs at new location.
562	10-20-26	Apply add. 7"x9" tie plates. Trk. #77=328. Trk. #78=178.
1429	12-31-26	Construct R/W Fence. N. side, sta. 4467+66 to 4483+68. Retire R/W Fence. N. side, sta. 4467+63 to 4483+68.
677	5-17-27	Extend stock pens at Double Springs 32' and construct 2 loading platforms 4'x9'. Retire loading chute, platform and 33' fence. E. end Pens sta. 4488+51.
634	7-24-28	Apply 384 add. 7"x9" tie plates-Mile 85.
849	10-20-28	Widen fills for Main Track-Mile 86.
837	11-30-28	Install 48" Corr. G.I. Pipe Culvert 54' long. @ sta. 4470+67.
368	12-31-28	Place 192 creo. cross ties in Main Track-Mile 85.
1020	12-31-28	Apply 51 Cu.Yd. Slag ballast and convert 9 Cu.Yd. Cinder ballast to embankment-Mile 85. Apply 120 Cu.Yd. Slag ballast and convert 20 Cu.Yd. Cinder ballast to embankment-Mile 86.
808	5-10-29	Apply 418 add. 7"x9" tie plates-Mile 86.

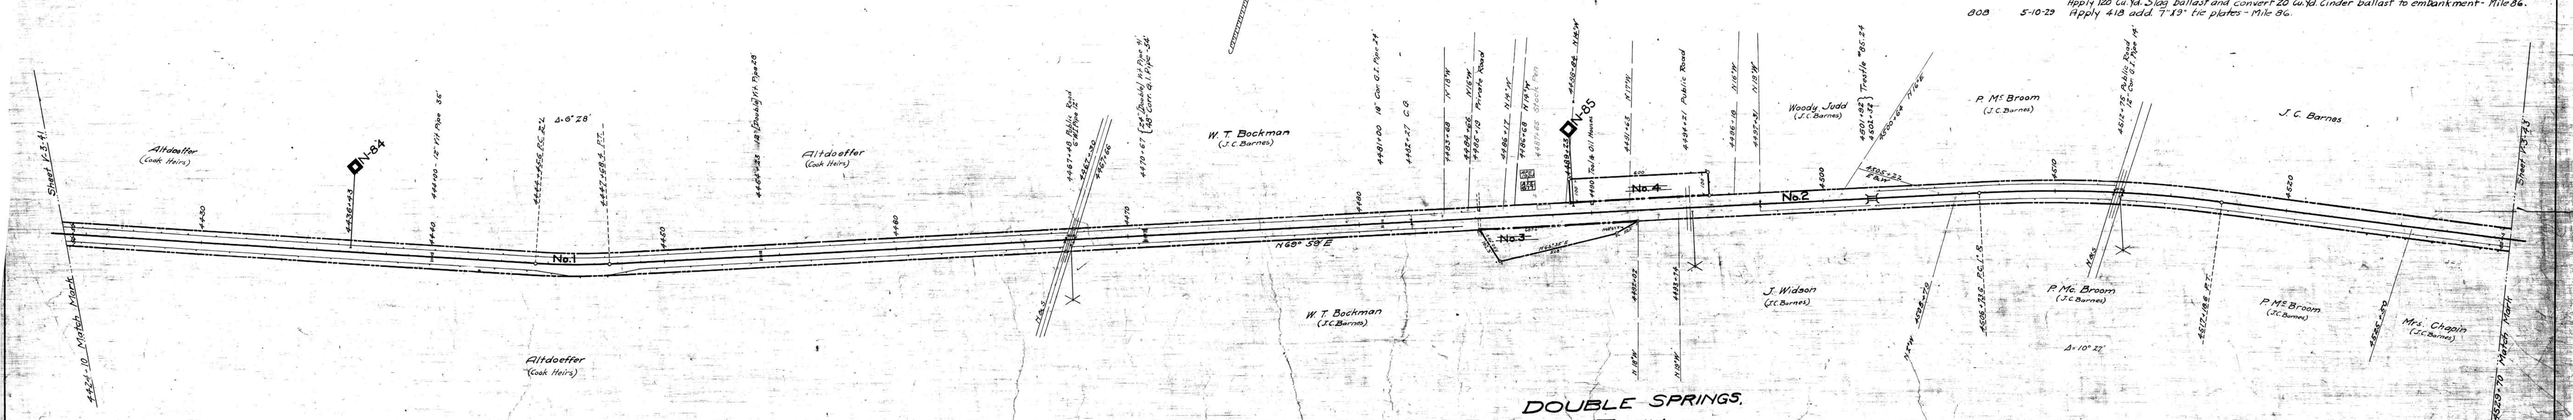

DOUBLE SPRINGS, TENN.

PUTNAM COUNTY, TENN.

SHEET NO. 62 OF 77 SHEETS OF EASTERN DIVISION FROM SUBVEY STATION 4424+10 TO SURVEY STATION 4529+70

J. B. Cartwright
VALUATION ENGINEER

RIGHT-OF-WAY AND TRACK MAP

EASTERN DIVISION

TENNESSEE CENTRAL RAILROAD

STATION 4424+10 TO STATION 4529+70

SCALE: 1 IN.=200 FT. JUNE 30, 1918

VALUATION DEPARTMENT
NASHVILLE, TENN.

071-008