No.	GRANTOR	GRANTEE	INSTRUMENT	DATE	RECORD	CHART NO.	REMARKS
1	Jas.A.Jensen	N.C.& St.L.Ry.	None	Aug.19,1890	DB 31-515-Aug.21,1890	1075	See Note 1
2	J.P.McKnight	N.C.& St.L.Ry.	Deed	Aug.12,1896	DB 37-393-Aug.26,1896	1104	
3			Deed	Aug.12,1896			
4			None				See Note 1
5	J.P.McKnight	N.C.& St.L.Ry.	Deed	Aug.12,1896	DB 37-393-Aug.26,1896	1104	
6	Jas.A.Jensen	N.C.& St.L.Ry.	Deed	Aug.9,1890	DB 31-505-Aug.21,1890	1074	
7			None				See Note 1
8	H.L.Fox	N.C.& St.L.Ry.	Deed	July 21,1904	DB 44-597-Aug.25,1904	1095	
9	Nashville,Murfreesboro & Shelbyville Turnpike Co.	N.C.& St.L.Ry.	Deed	July 23,1904	DB 44-595-Aug.24,1904	1078	
10			None				See Note 1
11	~~King,Rockwood & Co.~~ American Fruit Co.	N.C.& St.L.Ry.	Contract	~~Apr.25,1907~~ Apr.15,1907	Office of Secretary	~~See~~ 2014	

NOTE 1-Quarter width claimed under decisions of Tennessee Courts.

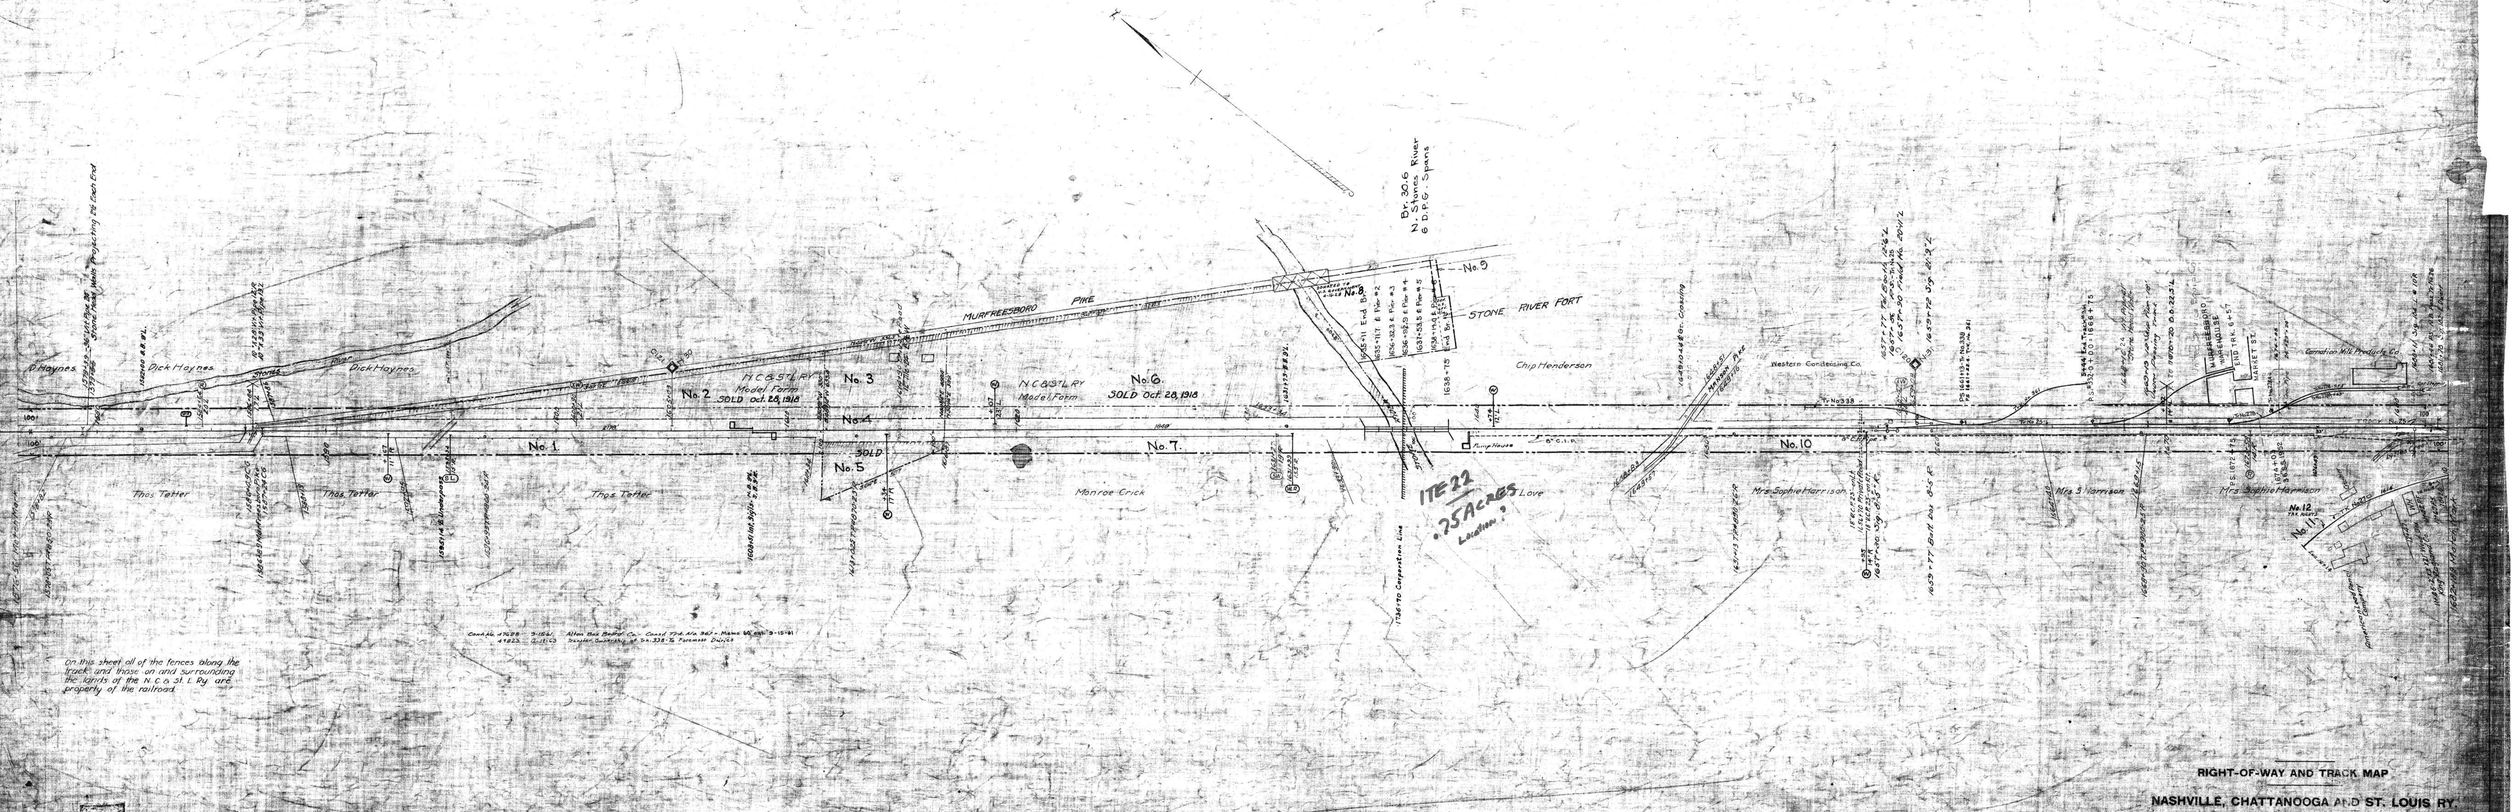

RIGHT-OF-WAY AND TRACK MAP

NASHVILLE, CHATTANOOGA AND ST. LOUIS RY.

CHATTANOOGA DIVISION

STATION 1596+361 TO STATION 1668+18

SCALE, 1 IN. 200 FT. JUNE 30, 1918

OFFICE OF CHIEF ENGINEER NASHVILLE, TENN.

Sheet No. 11 of 75 Sheets of Chattanooga Division from survey 1915 to 1918 (361 to survey station 1682+18)

M.P. 295 to 315

RUTHERFORD CO. TENN.

075-009