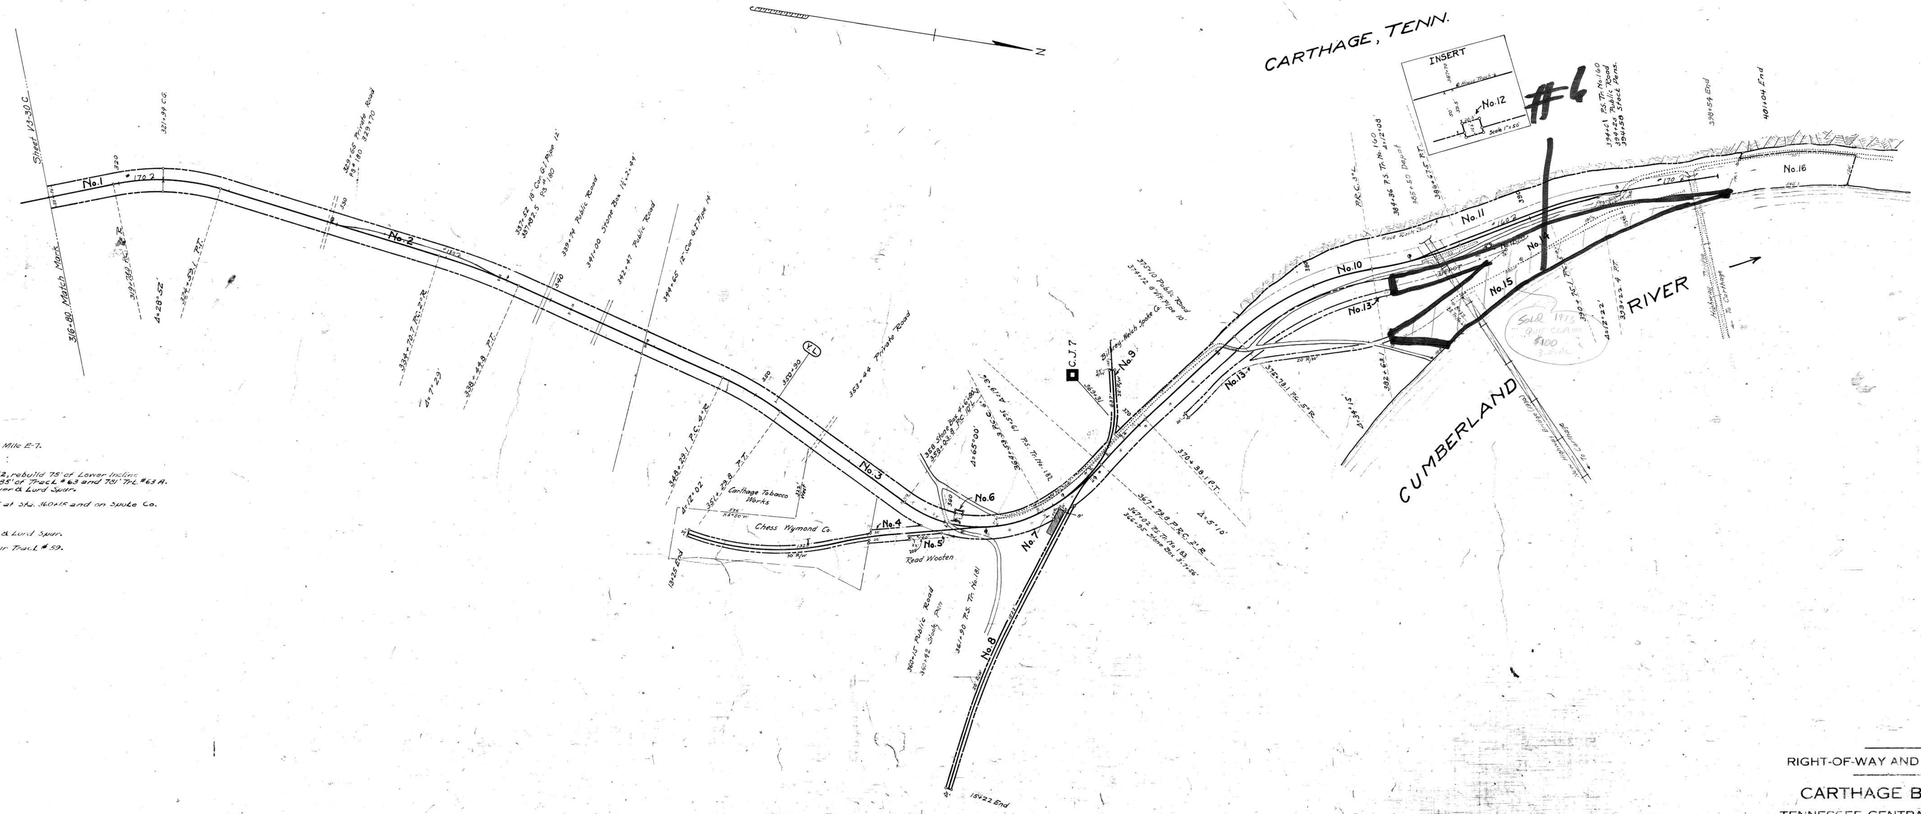

PROPERTY CHANGES SINCE JUNE 30, 1918.

CARE NO.	DATE	DESCRIPTION
242	12-3-1-23	Place fire plates in M.T. Mile E-7.
359	10-31-24	Construct 2,500' extension to M.T. Sta. 398+54 to Sta. 401+04.
345	11-20-24	Place fire plates in M.T. Mile E-7.
372	1- 6-25	Install fire extinguisher at Carthage Depot.
1846	-25	Grine cross ties from M.T. Mile E-5 and install additional cross ties Mile E-7.
399	2-10-26	Place fire plates in M.T. Miles E-7 & E-8.
467	7-20-26	Construct 870' Spur Track, Sta. 318+20
610	6-20-28	Place 42" U.R.C.P. Culvert in Reg. [illegible] Track #58.
660	11-20-28	Construct 410' Hard Land Tie to Spur Track #1 at Sta. 3[illegible] Tr. #62, rebuild 75' of Lower Incline [illegible] 185' of Track #63 and 701' Trk. #63 A.
[illegible]	-1-29	Place fire plates in M.T. Miles E-7 & E-8 and Tracks Nos. 58, 59, [illegible] Hyer & Lurd Spurs.
806	9-10-29	Place fire plates in Tracks Nos. 60, 61, 62 & New Spur (Miller [illegible]).
1046	10- -29	Replace crossing plank with rail type rubber crossing in M.T. at Sta. 360+1K and on Spur Co.
		Spur Track at same location (Track # 58).
1002	4-23-30	Place fire plates in M.T. Mile E-5.
900	12-13-30	Replace Stock Pens.
1264	2-24-31	Lay 70# rider rail in 187' of Upper Incline Track # 62 and 80' of Hyer & Lurd Spur.
1263	2-23-31	Construct 660' Storage Track, P.S.
1323	9-16-31	Construct 155' extension on West end of Bilbrey-Welch Spur - Co. Spur Track # 59.
1300	6-24-32	Place fire plates in Track #59.
1449	2-28-34	Place fire plates in M.T. Mile E-7.
1709	12-19-35	Replace Depot at new location.
1714	5- 1-36	Raise grade at Tr. # 60 to serve Gulf Refining Co.
1761	5- -36	Install derails on Tracks Nos. 59 & 60 to protect main line.
1737	12-31-36	Place fire plates in Track # 61

RIGHT-OF-WAY AND TRACK MAP

CARTHAGE BRANCH

TENNESSEE CENTRAL RAILROAD

STATION 316+00 TO STATION 398+54

SCALE, 1 IN. = 200 FT. JUNE 30, 1918

SHEET NO. 30 OF 37 SHEETS OF CARTHAGE BRANCH TR. SURVEY STATION 316+00 TO SHIVELY STATION 398+54

VALUATION DEPARTMENT NASHVILLE, TENN.

080-010

SMITH COUNTY, TENN.