A.F.E. DATE DESCRIPTION

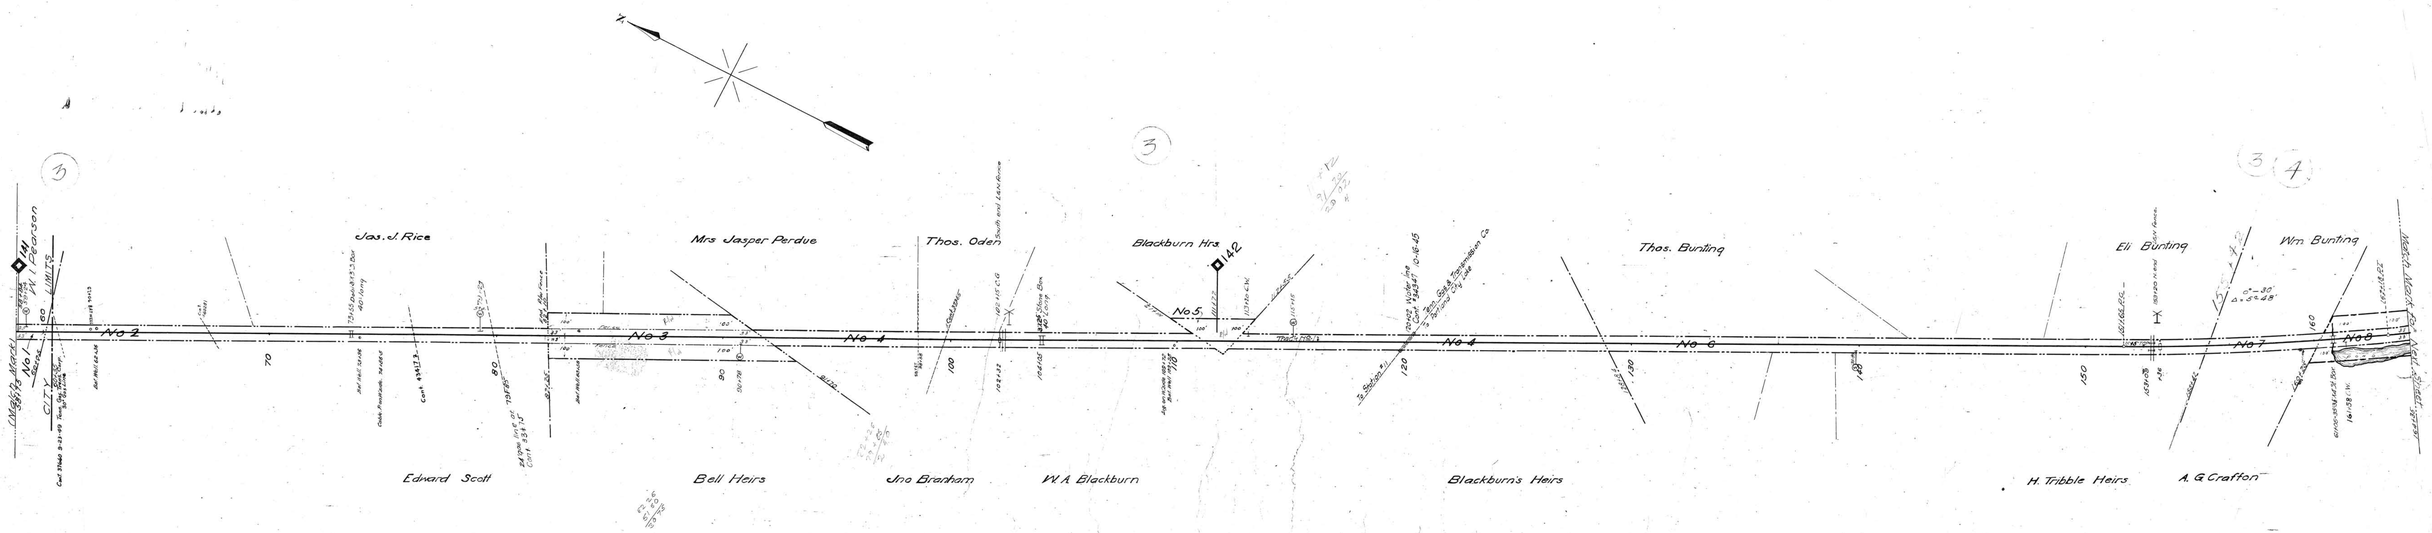

	Cont 33475	11-30-46	Tennessee Gas and Transmission Co 1-24" & 126" pipe gas line under 79+86
L.F. 35167	" 37365	6-11-49	The Cumberland Electric Membership Corp. Wire x-ing at Sta 99+75
L.F. 38108	" 37660	9-23-49	Tenn. Gas Transmission Co. 30" Gas Line under at 60+70
	" 40281	12-24-52	" " " " 63+35
" 27181	" 26942	5-12-54	SOUL BELL TELE & TELE CO WIRE X-ING PT VS. 58+38
	Deed 143181	10-4-55	W.H. & Mae Davis - Tree cutting gas & wire side Sta. 57+85 to 82+75
	Cont. 43417	3-9-57	Tenn. Gas Transmission Co. - 30" Gas Line Under Sta. 76+36
	~~" 45373~~	~~6-4-53~~	~~Williams Brothers Co. - 20" Ft. Ro'ing Sta 82+36~~ (Cont. 10-16-59)

Sheet No 2 of 25 of Main Stem Second Division from survey station 58+75 to survey station 164+35

Valuation Engineer

RIGHT OF WAY AND TRACK MAP
LOUISVILLE AND NASHVILLE R. R. CO.
MAIN STEM SECOND DIVISION

STATION 58+75 TO STATION 164-35

SCALE-1 INCH = 200 FT. JUNE 30, 1917.

OFFICE OF CHIEF ENGINEER
LOUISVILLE, KY.

V.8
2

083-015

8-2

SUMNER Co. TENN.