A.F.E. No.	Date Comp.	Description of Change
801	4-5-20	Assessment for construction of drainage ditch. (See C.E. File 18369-B.R.-15577)
3017	6-6-22	Reconstruction of Trestle No 255
4327	12-1-23	Construction of R'Way fence (See fence notes)
5854	1-2-25	Reconstruction of Trestle 256.
9238	6-29-28	Reconstruction of Trestle No. 257.
12469	3-1-29	Sale of Section Foreman House & Lot - Deed 5395
13933	12-16-29	Sale of Section Laborers Houses only to Eugene Rogers.
21352	33	Plot of Track 2+3+4
22376	8-30-37	Sold - Stock pens
46818	4-18-57	Add Scr-meatings platform & 7 timber curb of Tool House. Sta. 9340+60.
51286	6-15-57	" Frame Tool House, Sta. 9331+73
51235	5-1-59	" Comb. Freight & Pass. Station
51741	12-21-58	Ref. 282.7K+235 Sta. 9352+42. & K.E. 100.7K+214

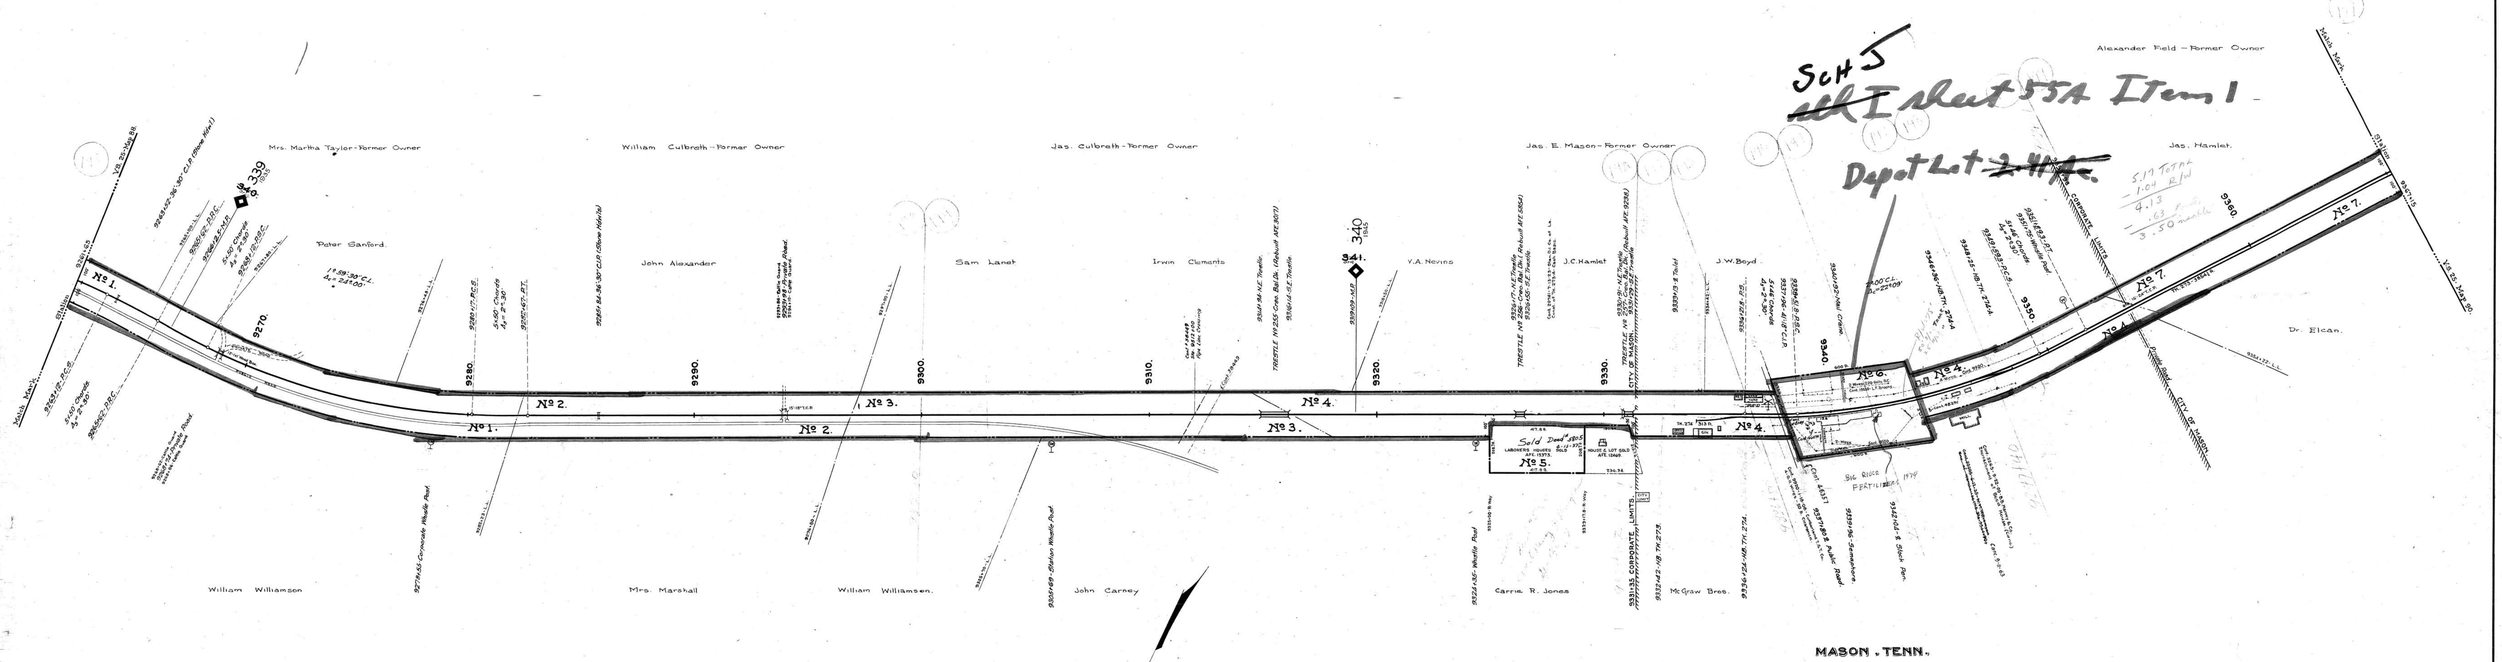

Fence on South side from Station 9261+55 to Station 9266+50
" " " " " 9267+74 " " 9269+44 under A.F.E. 4747.
" " " " " 9271+60 " " 9294+25
" " " " " 9319+00 " " 9335+50
" North " " " 9261+55 " " 9305+55
" " " " " 9315+90 " " 9330+80
" Both " " " 9348+22 " " 9367+15.

~~Cont. 9335+ on 8-28-39 Mason Tel Co. wire and attachment on pole east~~ - Canc. 10-31-61
" 23182 1-11-31 Russell Hawkins lease of lot 5
" 29171 12-2-36 Town of Mason water lines crossing under @ 9337+80 and 9346+90.
~~" 33884 11-8-44 McCormick & Simonton Unloading pat under trk. # 278 of 9334+55~~ Trans. to E.R. McCormick 1-2-48 (Cancelled)
~~LF 30167 30000 11-12-48 Mason Lumber Co., Inc. Lease land 90'x18' at Sta. 12+90 to 13+60. Lease Extended to 11-11-53.~~ Canc. 10-10-63
~~" 46545 " 5265 6-8-65 Poulan Brothers Gin Co. 16"x10" Seed No. 4, 16"x30" Seed No. Sta. 9346+36.~~ Canc. 10-2-63
" 40818 " 38449 8-17-50 Trunkline Gas Co. Permit for installing 26" Gas line in 80" Steel line across R/W at Sta. 9312+00
" 443 " 40432 3-3-54 C.T. Poindexter Co. Lease of 20'x20' in freight house. Expired
" 807 " 40432 5-12-54 Typifrip Credit Health Dept. Lease (Part) in freight house
" 807 " 40432 1-18-57 C.T. Poindexter Co. Lease of 20'x20' in freight house
" 40432 3-8-58 ——— Canc. 7-16-58
" 38449 3-5-59 Trunkline Gas Co. ~ 30" Gas Line Under Sta. 9312+66
" 46350 2-24-66 C.T. Poindexter on Lease at @ 330" of Steel Sta. 9339+00 & 9340+28
" 46357 6-23-60 Millington Tel. Co., Inc. ~ Wire Xing under sta. 9337+90
" 48085 5-8-62 Southeast Gin Mfg. Manufacturing Corp. ~ 38" Pipe road over sta. 9337+17
LF 27767 " 48290 2-19-62 Southwest Tennessee Electric Membership Corp. ~ 12 Power Poles, 7 anchors (Wires encroaching on Para. 4 & 6)

SHEET NO. 89 OF 111 OF MEMPHIS LINE FROM SURVEY STATION 9261+55 TO SURVEY STATION 9367+15.

VALUATION ENGINEER.

RIGHT OF WAY AND TRACK MAP
LOUISVILLE AND NASHVILLE R. R. CO.
MEMPHIS LINE

STATION 9261+55 TO STATION 9367+15.

SCALE: 1 INCH = 200 FT. JUNE 30, 1917.

OFFICE OF CHIEF ENGINEER
LOUISVILLE, KY.

REVISED AND REDRAWN - 5-20-31
OFFICE OF VALUATION ENGINEER.

V-25
89.

V-25-89.

084-010