REF NO	DATE	DESCRIPTION
G2020	10-15-68	Cont. 44549 & 48200 Sta's 1280+41 & 1332+71

NO.	GRANTOR	GRANTEE	INSTRUMENT	DATE	RECORD	CONT. NO.	REMARKS
1		None					See Note 1

Note 1-Charter width claimed under decisions of Tennessee Courts.
Note 2- The McMinnville and Manchester R.R.Co. owned and sold several lots in Morrison- Available records cover the following:

McMinn. & Manchester R.R.Co.	N.H.Wheeler	Deed	Aug. 2, 1858	DB V-141-Oct.5, 1858	3078	Lot 1
McMinn. & Manchester R.R.Co.	Brewer & McMahon	Deed	Oct.11, 1858	DB V-189-Nov.11,1858	3080	Lot 9
McMinn. & Manchester R.R.Co.	A.J.Brewer	Deed	Sept.28, 1857	DB U-249-Sept.30,1857	3083	Lots 10-11-12-24

The road from Tullahoma to McMinnville, a distance of 35 miles, was constructed by the McMinnville and Manchester R.R.Co. about the year 1856. Under a Chancery decree dated July 10,1875 this road was sold to the Memphis and Charleston R.R.Co. On July 28,1877 the Memphis and Charleston R.R.Co. sold the road to the Nashville,Chattanooga & St.Louis Railway.

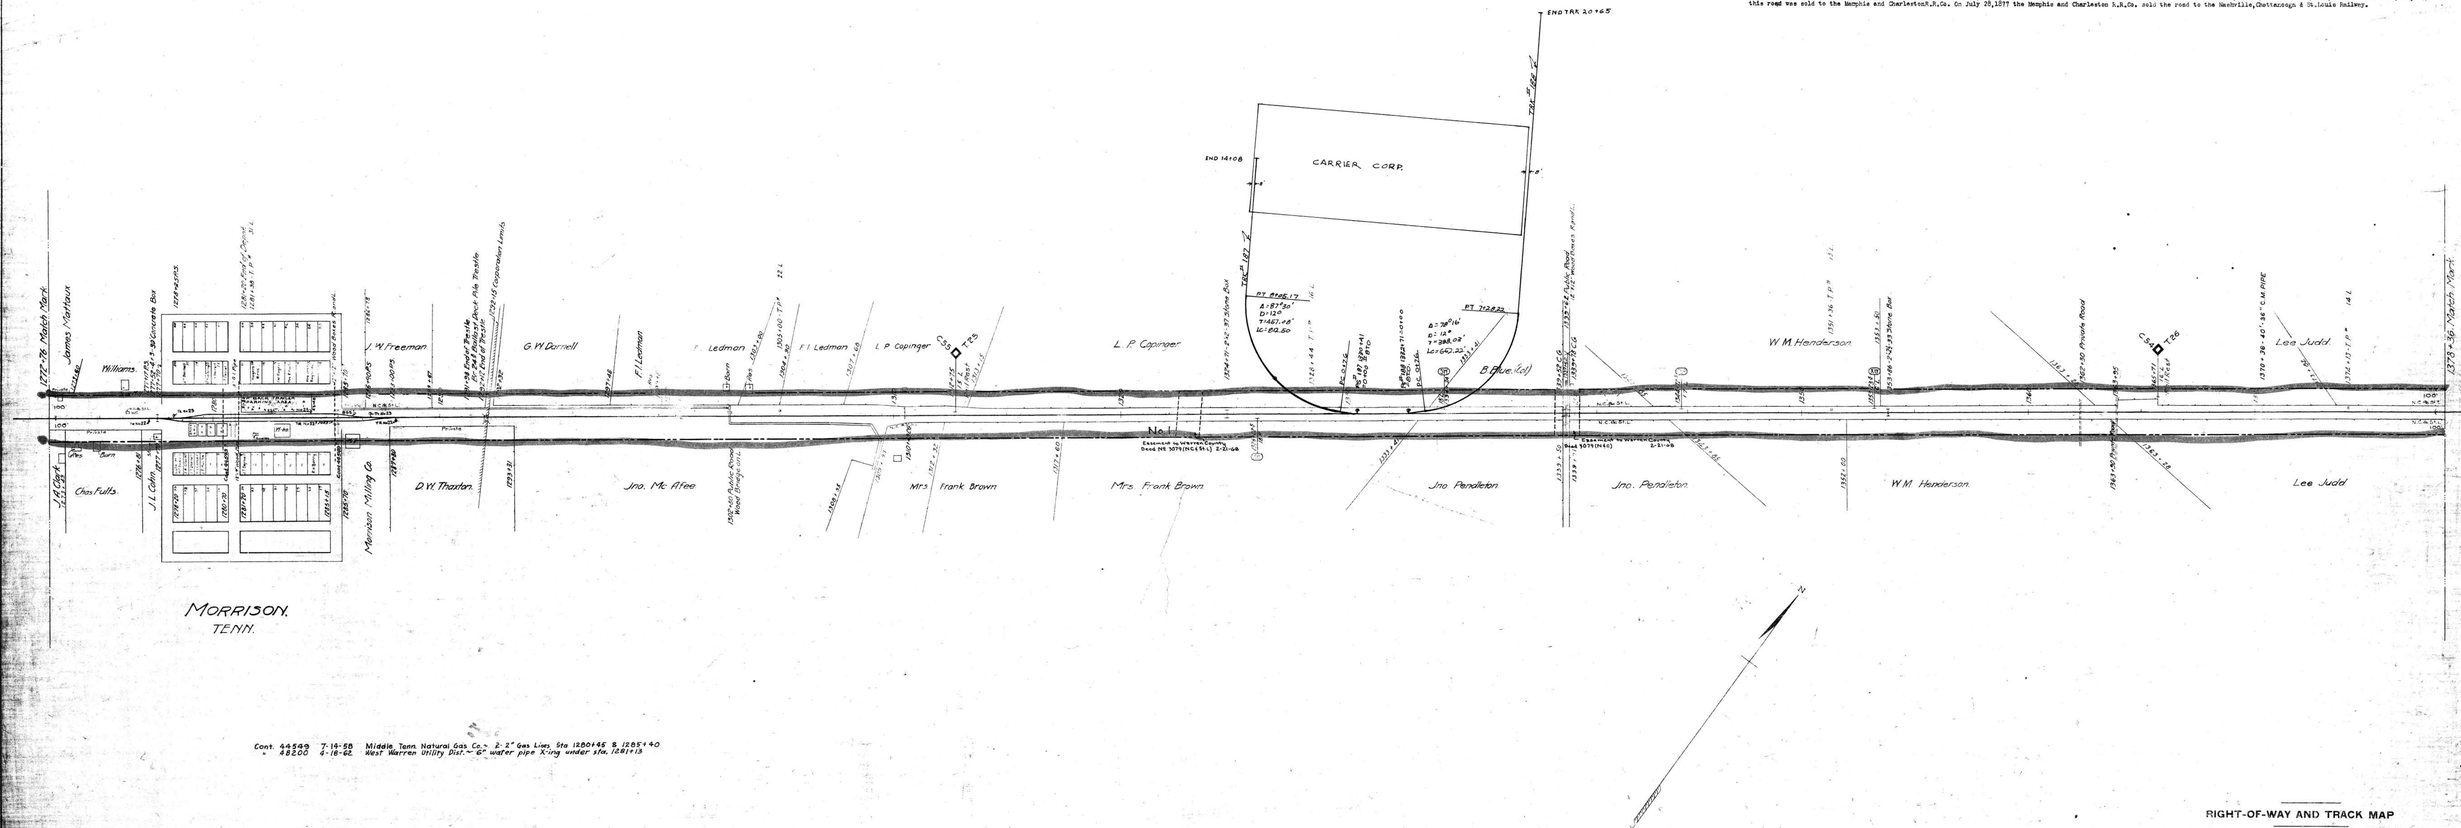

Cont. 44549 7-14-58 Middle Tenn. Natural Gas Co.- 2-2" Gas Lines, Sta 1280+45 & 1285+40
" 48200 4-18-62 West Warren Utility Dist.- 6" water pipe X-ing under sta. 1281+13

RIGHT-OF-WAY AND TRACK MAP

NASHVILLE, CHATTANOOGA AND ST. LOUIS RY.

SPARTA BRANCH

STATION 1272+76 TO STATION 1378+36

SCALE, 1 IN. 200 FT. JUNE 30, 1916

OFFICE OF CHIEF ENGINEER
NASHVILLE, TENN.

Sheet No. 13 of 44 Sheets of Sparta Branch from survey station 1272+76 to survey station 1378+36

Assistant Engineer

M.P. 24.2 to 26.2

1-24-216
V. 18

1107-A-13

WARREN Co., TENN.

089-002