NO.	GRANTOR	GRANTEE	INSTRUMENT	DATE	RECORD	CUST. NO.	REMARKS
1			None				See Note 1

Note 1- Charter width claimed under decisions of Tennessee Courts.

The road from Tullahoma to McMinnville, a distance of 35 miles, was constructed by the McMinnville and Manchester R.R.Co. about the year 1856. Under a Chancery decree dated July 10,1875 this road was sold to the Memphis and Charleston R.R.Co. On July 28, 1877 the Memphis and Charleston R.R.Co. sold the road to the Nashville, Chattanooga & St.Louis Railway.

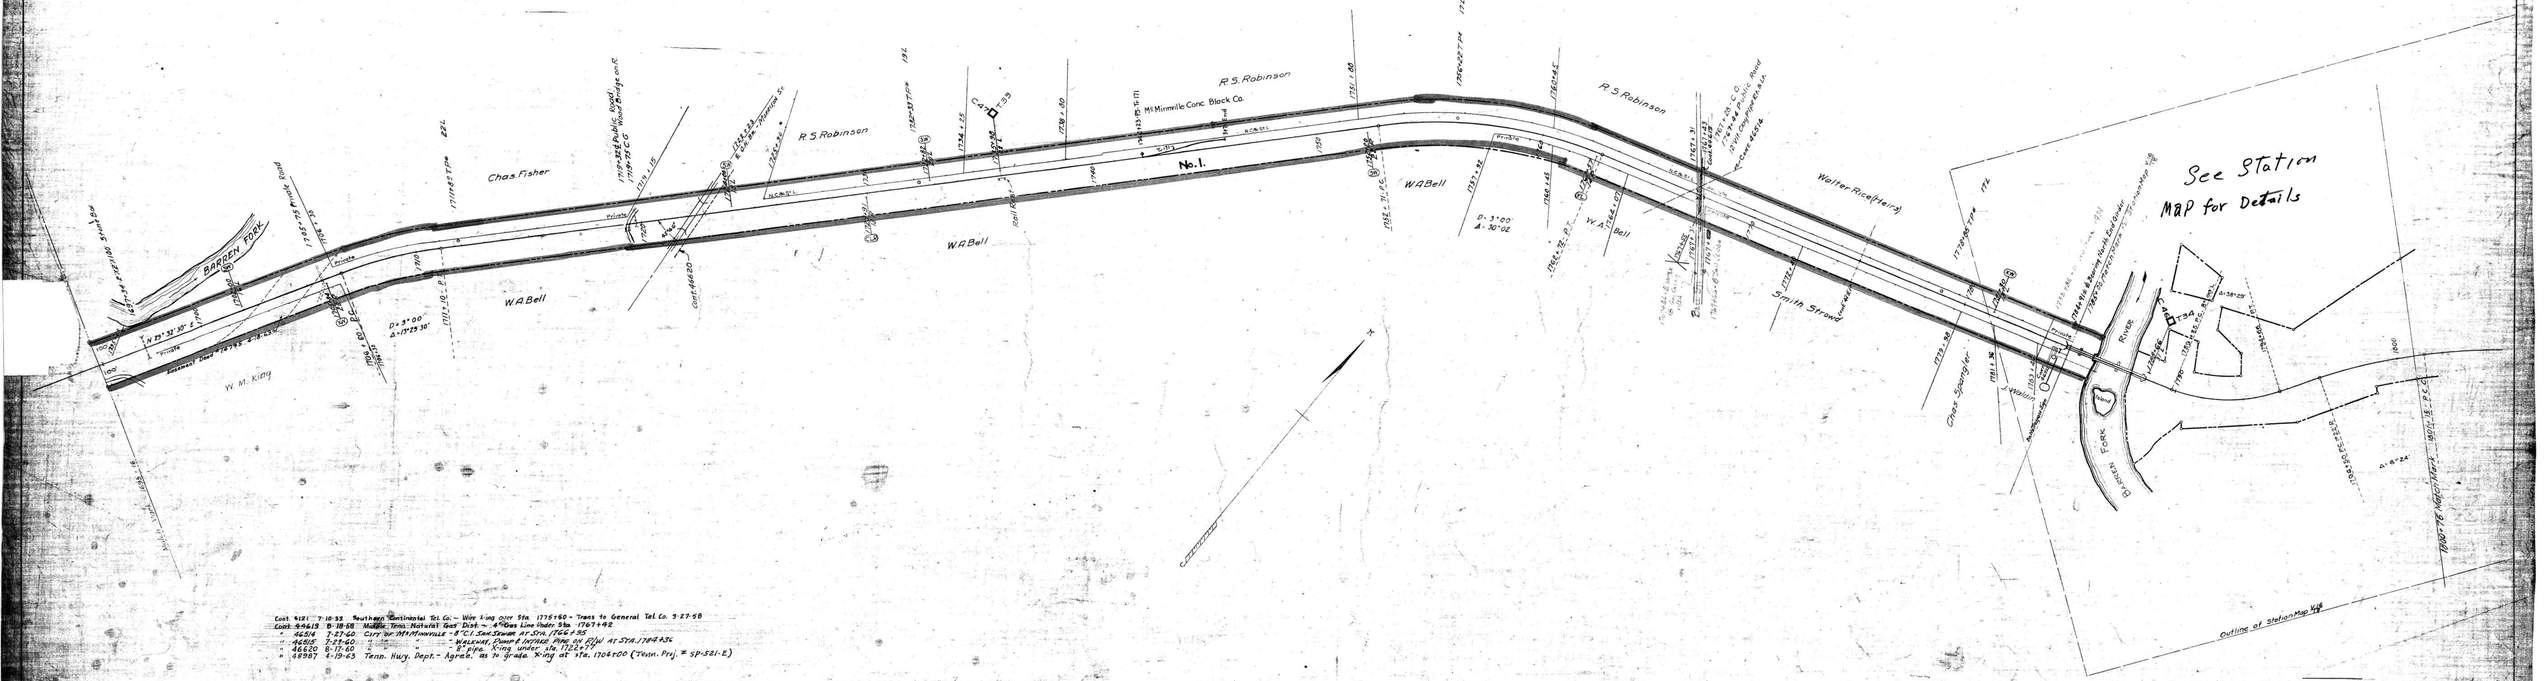

Cont. 4121 7-10-33 Southern Continental Tel. Co. - Wire Xing over Sta. 1775+60 - Trans to General Tel. Co. 5-27-58
Cont. 44613 8-18-68 Middle Tenn. Natural Gas Dist. - 4" Gas Line Under Sta. 1767+42
" 46514 7-27-60 City of McMinnville - 8" C.I. Sam. Sewer at Sta. 1766+95
" 46515 7-27-60 " " " - Walkway, Dump & Intake Pipe on R/W at Sta. 1784+36
" 46620 8-17-60 " " " - 8" pipe. Xing under sta. 1722+79
" 48987 4-19-63 Tenn. Hwy. Dept. - Agree. as to grade Xing at sta. 1706+00 (Tenn. Proj. # SP-521-E)

WARREN CO. TENN.

089-006

RIGHT-OF-WAY AND TRACK MAP

NASHVILLE, CHATTANOOGA AND ST. LOUIS RY.

SPARTA BRANCH

STATION 1695+16 TO STATION 1800+76

SCALE, 1 IN. - 200 FT. JUNE 30, 1916

Sheet No. 17 of 44 Sheets of Sparta Branch from survey station 1695 to survey station 1800+76

Valuation Engineer

OFFICE OF CHIEF ENGINEER NASHVILLE, TENN.

M.P. 322 to 342

L&N 216
V. 16
17