A.F.E.	DATE COMP	DESCRIPTION
49782	11-8-57	Ret. 191' Trk. # 55
53523	5-10-61	Const. Trk. No. 56-A
54858	12-18-64	Ret. trk. # 121
60798	11-28-67	Ret. 28' of trk # 55

NO.	GRANTOR	GRANTEE	INSTRUMENT	DATE	RECORD	CONT. NO.	REMARKS
1	D.L.Simril	N.C.& St.L.Ry.	Deed	March 29, 1887	DB 29-449-Apr.6,1887	3030	
2	T.F.Goodbar	N.C.& St.L.Ry.	Deed	March 14, 1883	DB 27-201-Mch.20,1883	3016	
3	Cameron and Officer,	N.C.& St.L.Ry.	Deed	March 2, 1887	DB 29-416-Mch. 8,1887	3028	
4	Amanda J.Rhea	N.C.& St.L.Ry.	Deed	March 8, 1887	DB 29-419-Mch.10,1887	3029	
5	H.B.Stiner	N.C.& St.L.Ry.	Deed	April 16, 1887	DB 29-471-May 6,1887	3031	
6	Tenn.Stave & Lumber Co.	N.C.& St.L.Ry.	Contract	Dec. 7, 1907	Office of Secretary	782	
7		N.C.& St.L.Ry.	None				Note 2-Title by possession
8	S.V.McManus	N.C.& St.L.Ry.	Deed	Nov. 15, 1908	DB 50-192-Dec.21,1908	3047	
9	D.M.Meredith	N.C.& St.L.Ry.	Deed	Jan. 9, 1909	DB 50-253-Jan.19,1909	3048	
10	Jno.M.Paul	N.C.& St.L.Ry.	Deed	Feb. 24, 1887	DB 29-414-Mch. 9,1887	966	
11	Mrs.M.F.Bailey	N.C.& St.L.Ry.	Deed	Feb. 26, 1887	DB 29-415-Mch. 8,1887	3027	
12	Bon Air Coal, Land & Lumber Co.	N.C.& St.L.Ry.	Contract	Nov. 16, 1886	Office of Secretary	12	
	Bon Air Coal & Railroad Co.	N.C.& St.L.Ry.	Deed	Dec. 3, 1887	DB 31-77	3364	See Note 1

Note 1- Road from Sparta East 6½ miles was built by the Bon Air Railroad Co. Deed No. 3017 dated July 25,1883 from Land Owners to the Nashville, Chattanooga & St.Louis Railway covered right of way; the present right of way, however, was not acquired under that deed but later as set up under parcel No. 12

Note 2- An old map shows following note "No deed-Claimed that Officer Heirs gave right of way"

Note 3-Documents 3013 and 3014 cover releases from damage due to grading on the old route of the Southwestern Railroad. Route was never completely graded.

The road from McMinnville to Sparta was partly graded by the Southwestern R.R.Co.; it was chartered in the year 1852, was sold to the Nashville, Chattanooga & St.Louis Railway, which Company completed the road.

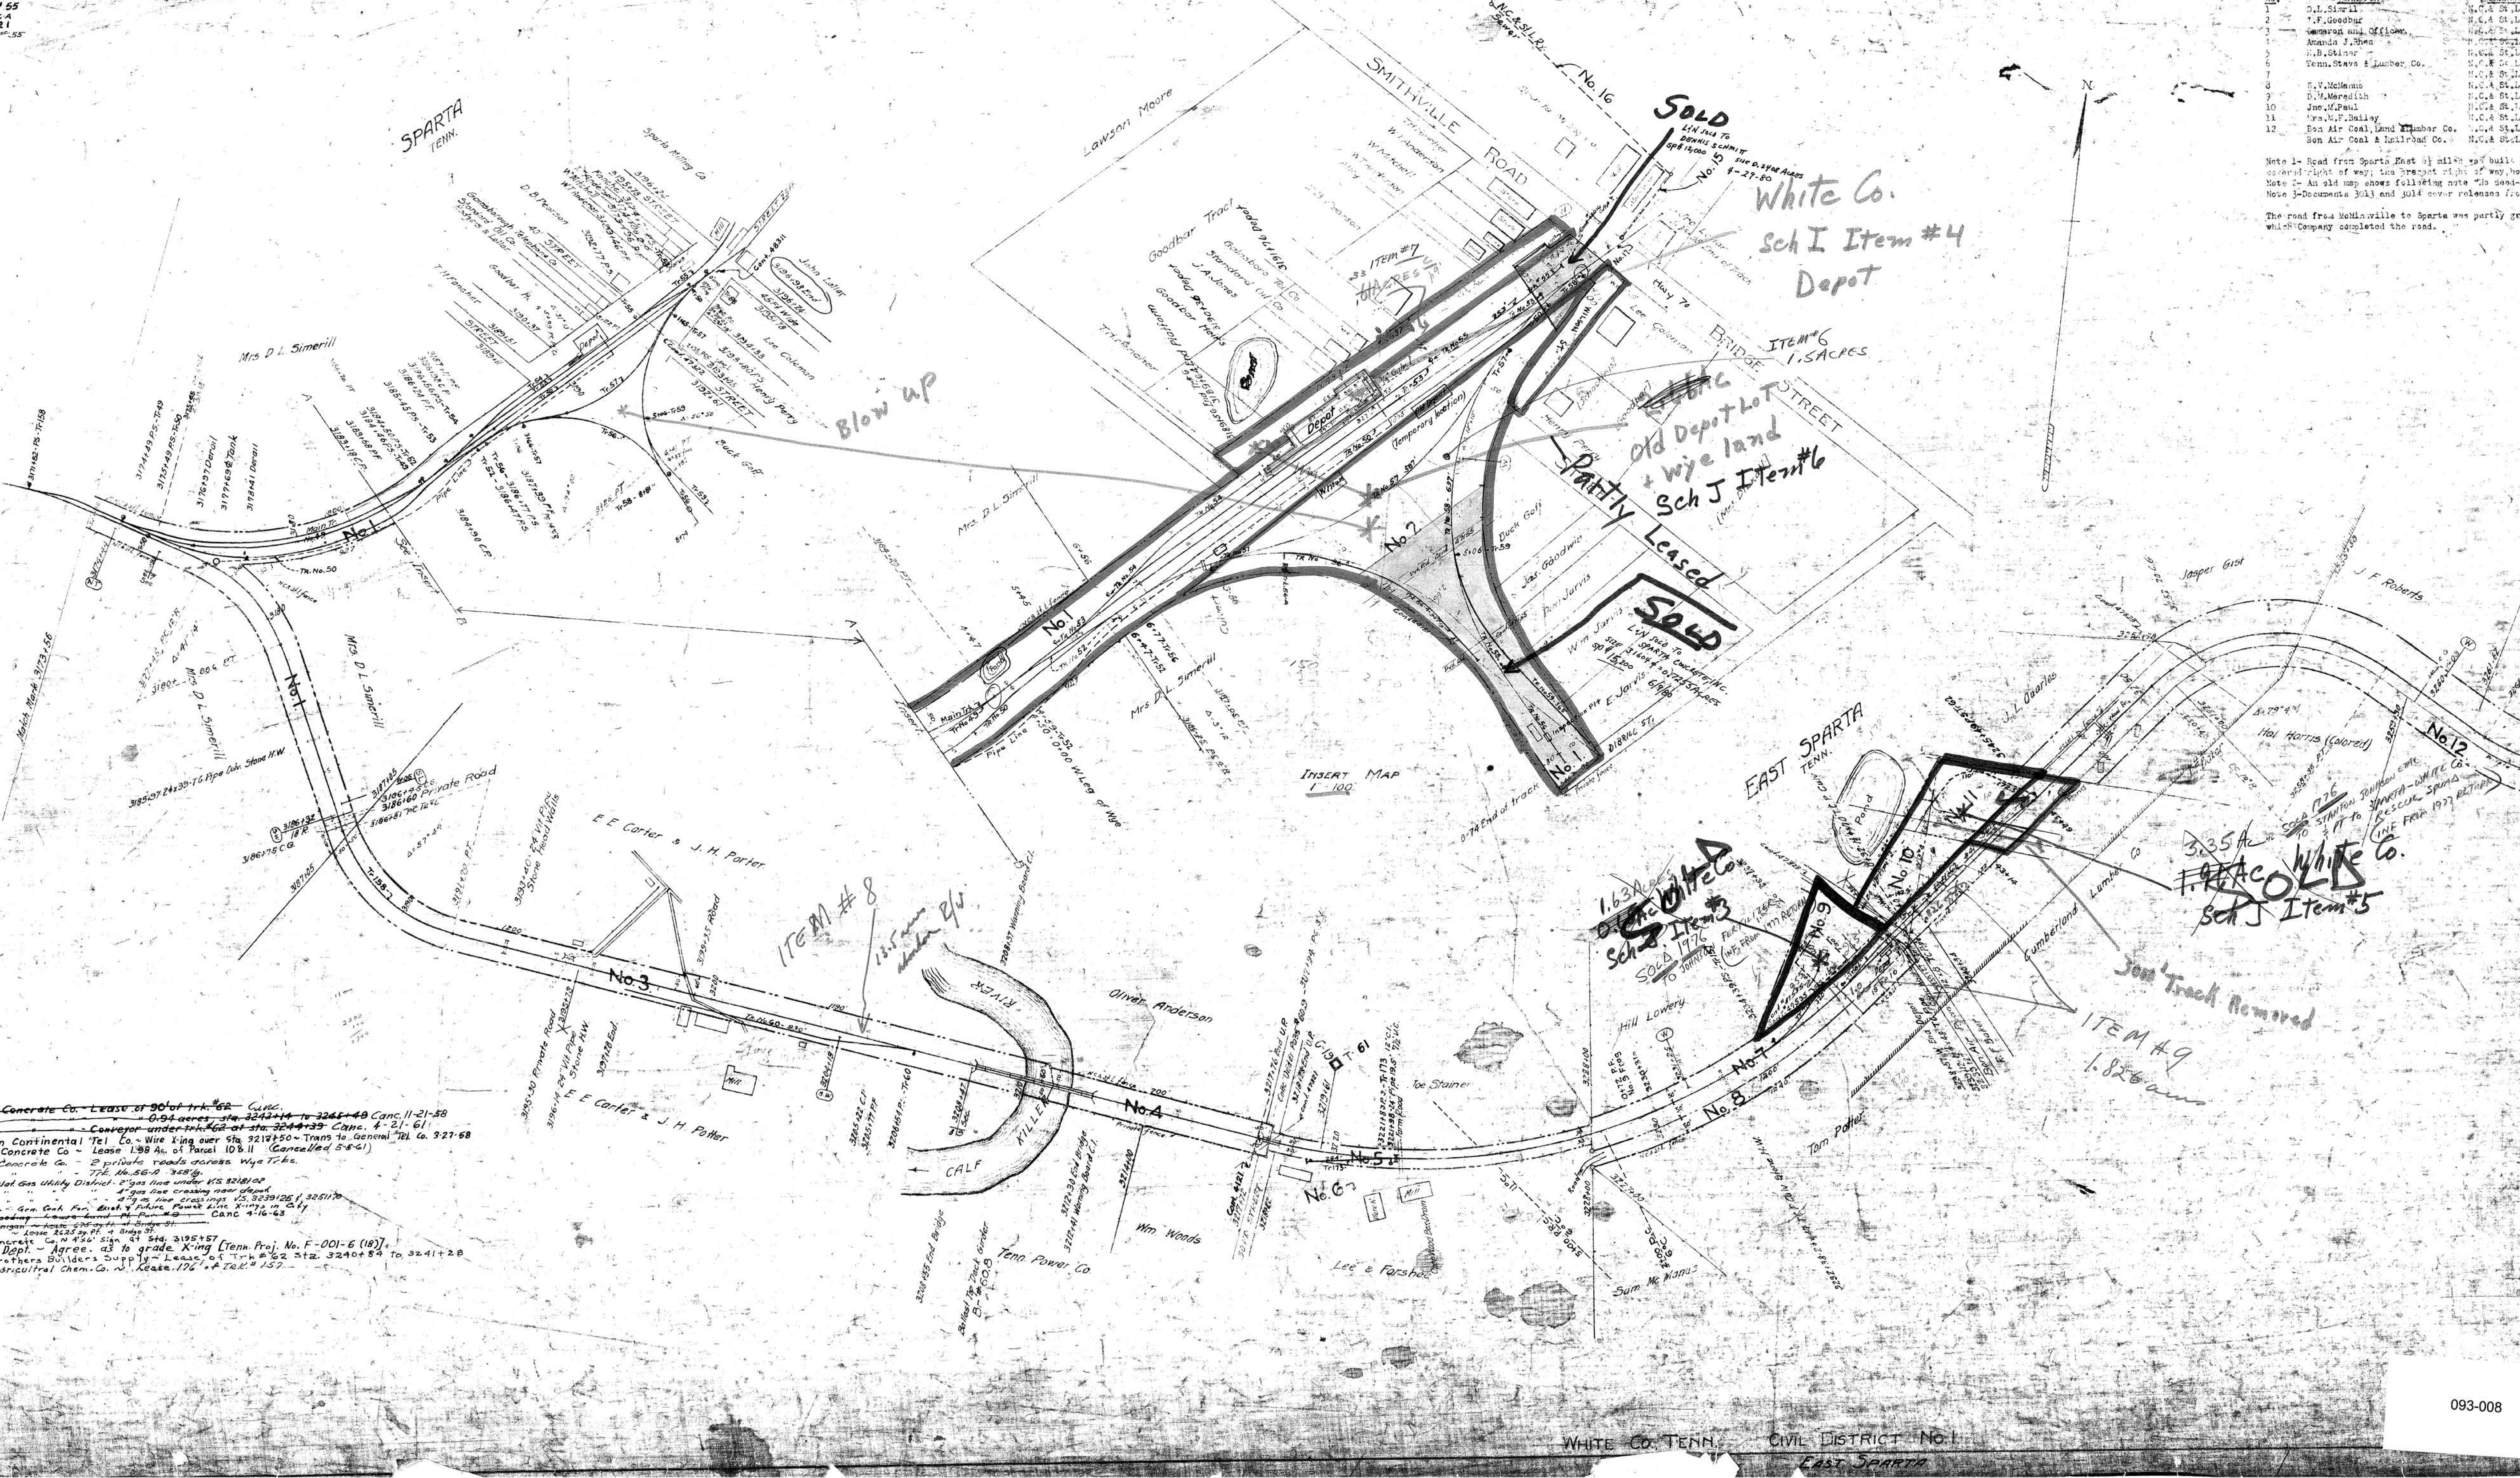

Cont.	Date	Description
~~44181~~	~~2-26-58~~	~~Sparta Concrete Co. - Lease of 90' of trk. #62~~ Canc.
~~44181~~	~~2-26-58~~	~~" " " - 0.94 acres sta. 3242+14 to 3245+49~~ Canc. 11-21-58
~~44181~~	~~2-28-58~~	~~" " " - Conveyor under trk. #62 at sta. 3244+39~~ Canc. 4-21-61
4121	7-10-33	Southern Continental Tel Co. ~ Wire X-ing over Sta. 3217+50 ~ Trans to General Tel. Co. 3-27-58
44181	11-21-58	Sparta Concrete Co ~ Lease 1.98 Ac. of Parcel 108.11 (Cancelled 5-5-61)
47155	4-4-61	Sparta Concrete Co. - 2 private roads across Wye Trks.
44181	4-4-61	" " " - Trk. No. 56-A 358' lg.
47321	6-5-61	Middle Tenn. Nat. Gas Utility District - 2" gas line under V.S. 3218+02
47322	6-5-61	" " " " " " - 4" gas line crossing near depot
47323	6-5-61	" " " " " " - 4" gas line crossings V.S. 3239+25 & 3251+70
47574	4-19-61	City of Sparta - Gen. Cont. For. Exist. & Future Power Line X-ings in City
~~47675~~	~~7-25-61~~	~~Sam & Robt J Brooding - Lease land Pt. Par #9~~ Canc 4-16-63
~~48016~~	~~3-23-62~~	~~Douglas Jarnigan ~ Lease 675 sq. ft. at Bridge St.~~
48017	3-29-62	H.K. Warwick ~ Lease 2625 sq. ft. at Bridge St.
LF. 47161 - 48371	6-28-62	Sparta Concrete Co. ~ 4'x6' sign at Sta. 3195+57
47156	3-3-61	Tenn. Hwy. Dept. ~ Agree. as to grade X-ing [Tenn. Proj. No. F-001-6 (18)]
43874 44187	3-8-63	Sorrell Brothers Builders Supply ~ Lease of Trk #62 Sta. 3240+84 to 3241+28
47535	4-16-63	American Agricultral Chem. Co. ~ Lease 176' of Trk. # 157

707-B-6

WHITE CO. TENN. CIVIL DISTRICT No. 1
EAST SPARTA

Sheet No. 31 of 44 Sheets of Sparta Branch from survey station 3173+76 to survey station 3279+16

Valuation Engineer

093-008

RIGHT-OF-WAY AND TRACK MAP

NASHVILLE, CHATTANOOGA AND ST. LOUIS RY.

SPARTA BRANCH

STATION 3173+76 TO STATION 3279+16

SCALE 1 IN. 200 FT. JUNE 30, 1916

OFFICE OF CHIEF ENGINEER NASHVILLE, TENN.

Sch J Items 3 5 6

L&N 216 V. 16 31

M.P. 601 to 621