NO.	GRANTOR	GRANTEE	INSTRUMENT	DATE	RECORD	CONT. NO.	REMARKS
1	Ben Air Coal, Land, & Lumber Co.	N.C.& St.L.Ry.	Contract	Nov. 15, 1886	Office of Secretary	12	See Note 1
	Ben Air Railroad Co.	N.C.& St.L.Ry.	Deed	Dec. 3, 1887	DB 31-77	3346	
2	Ben Air Coal, Land & Lumber Co.	N.C.& St.L.Ry.	Deed	Mch. 17, 1890	DB 32-68-Mch.29,1890	3032	See Note 2.

Note 1- Road from Sparta East 6½ miles was built by the Ben Air Railroad Co. DeedNo.301" dated July 25, 1883 from Land Owners to the N.C.& St.L.Ry. covered right of way; the present right of way, however, was not acquired under that deed but later as set up under parcel No. 1.
Note 2- Grantor also gave right to use water from the "Squire Burden Spring" also the free right of way for pipe line across the land about 2600 feet long.

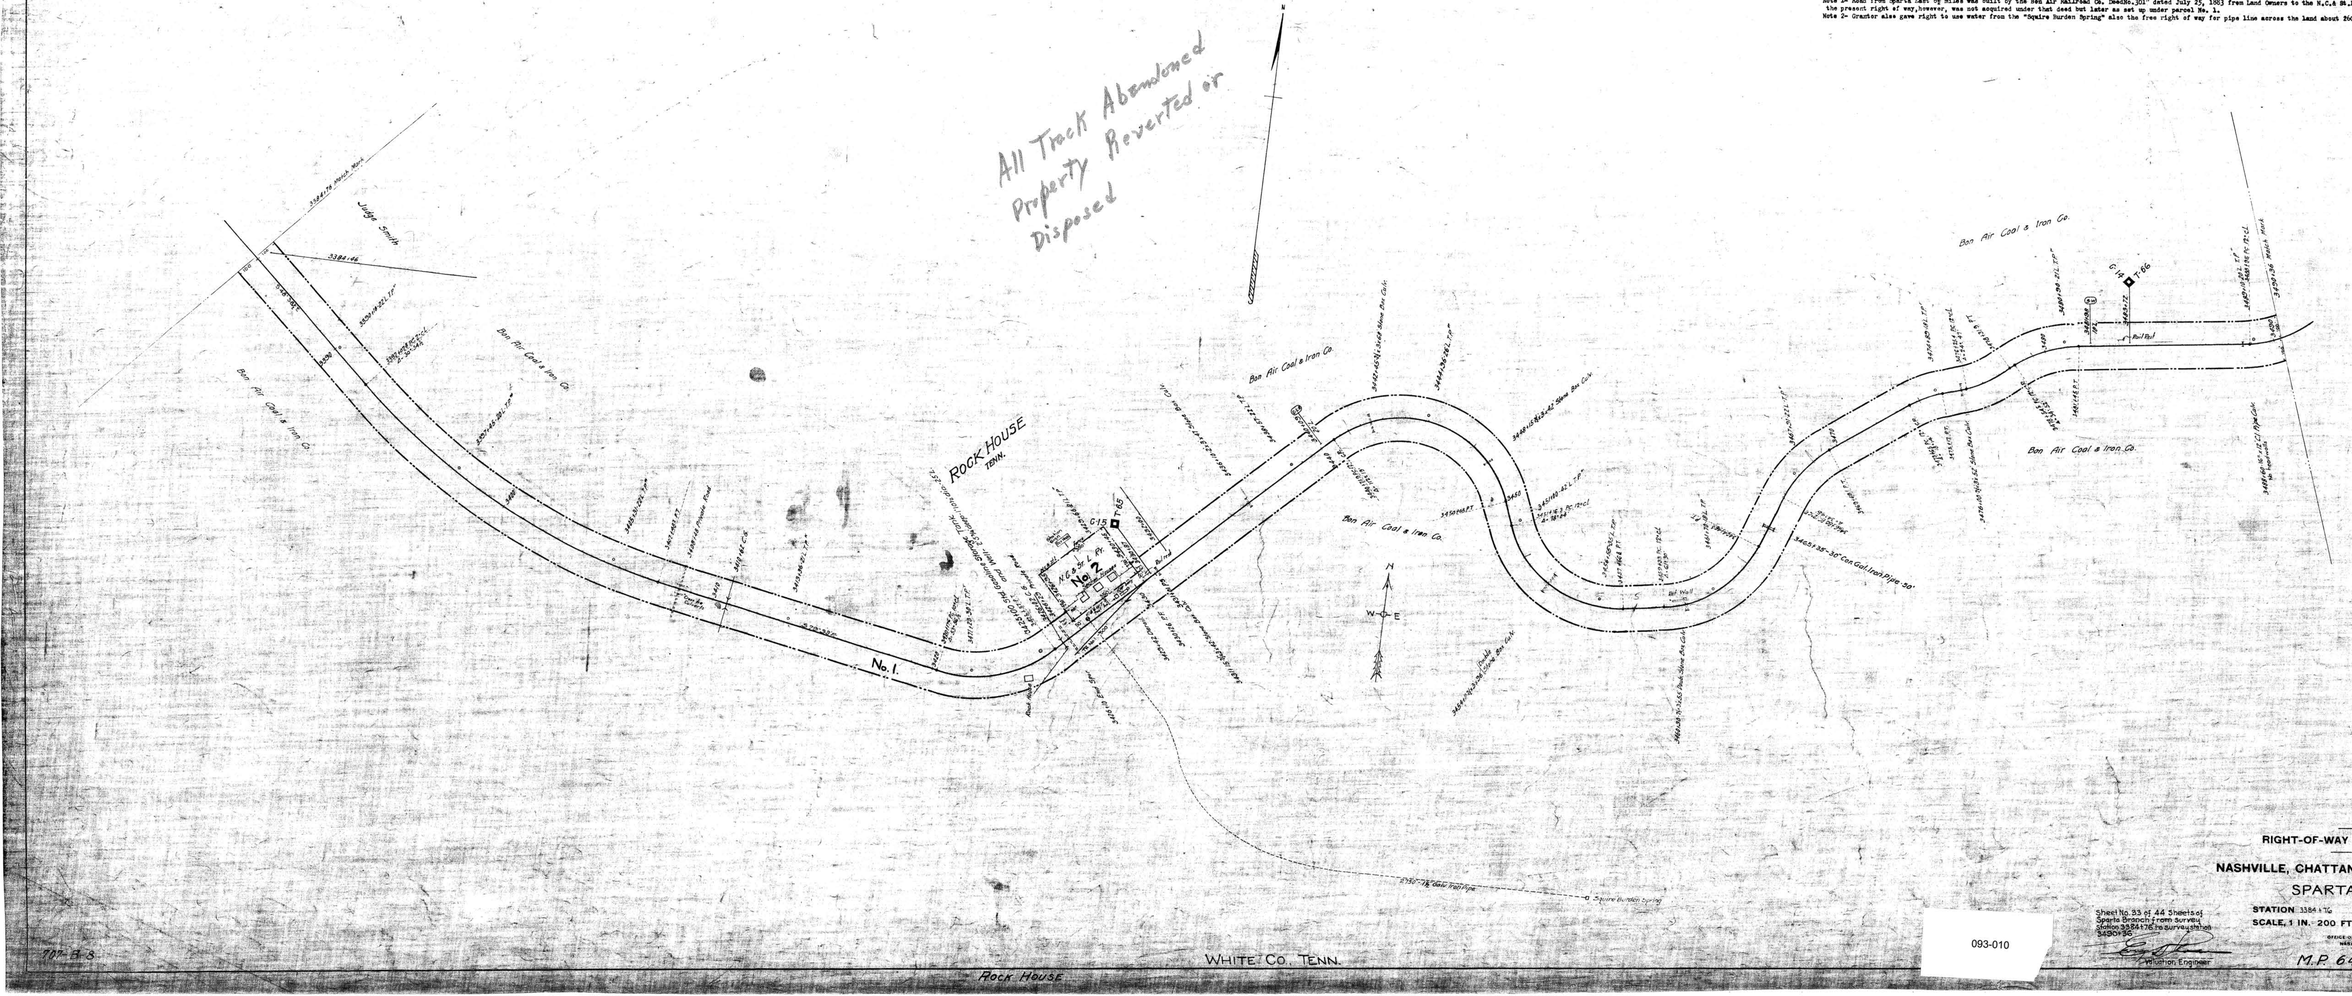

RIGHT-OF-WAY AND TRACK MAP

NASHVILLE, CHATTANOOGA AND ST. LOUIS RY.

SPARTA BRANCH

STATION 3384+76 TO STATION 3490+36

SCALE, 1 IN. 200 FT. JUNE 30, 1916

Sheet No. 33 of 44 Sheets of Sparta Branch from Survey Station 3384+76 to Survey Station 3490+36

OFFICE OF CHIEF ENGINEER NASHVILLE, TENN.

Valuation Engineer

M.P. 64.1 to 66.1

093-010

27-3