NO.	GRANTOR	GRANTEE	INSTRUMENT	DATE	RECORD	CUST. NO.	REMARKS
1	Ben Air Coal, Land and Lumber Co.	N.C.& St.L.Ry.	Contract	Nov.15, 1886	Office of Secretary	12	See Note 1
	Ben Air Railroad Co.	N.C.& St.L.Ry.	Deed	Dec. 3, 1887	DB 31-77	3366	
2	Ben Air Coal, Land & Lumber Co.	N.C.& St.L.Ry.	Deed	Nov 23, 1901	DB 41-148-Jan.3, 1902	3055	

Note 1- Road from Sparta East about 6½ miles was built by the Ben Air Railroad Co. Deed No. 3017 dated July 25, 1883 from various land owners to the N.C.& St.L.Ry. covered right of way; the present right of way, however, was not acquired under that deed but later as set up under parcel No. 1.

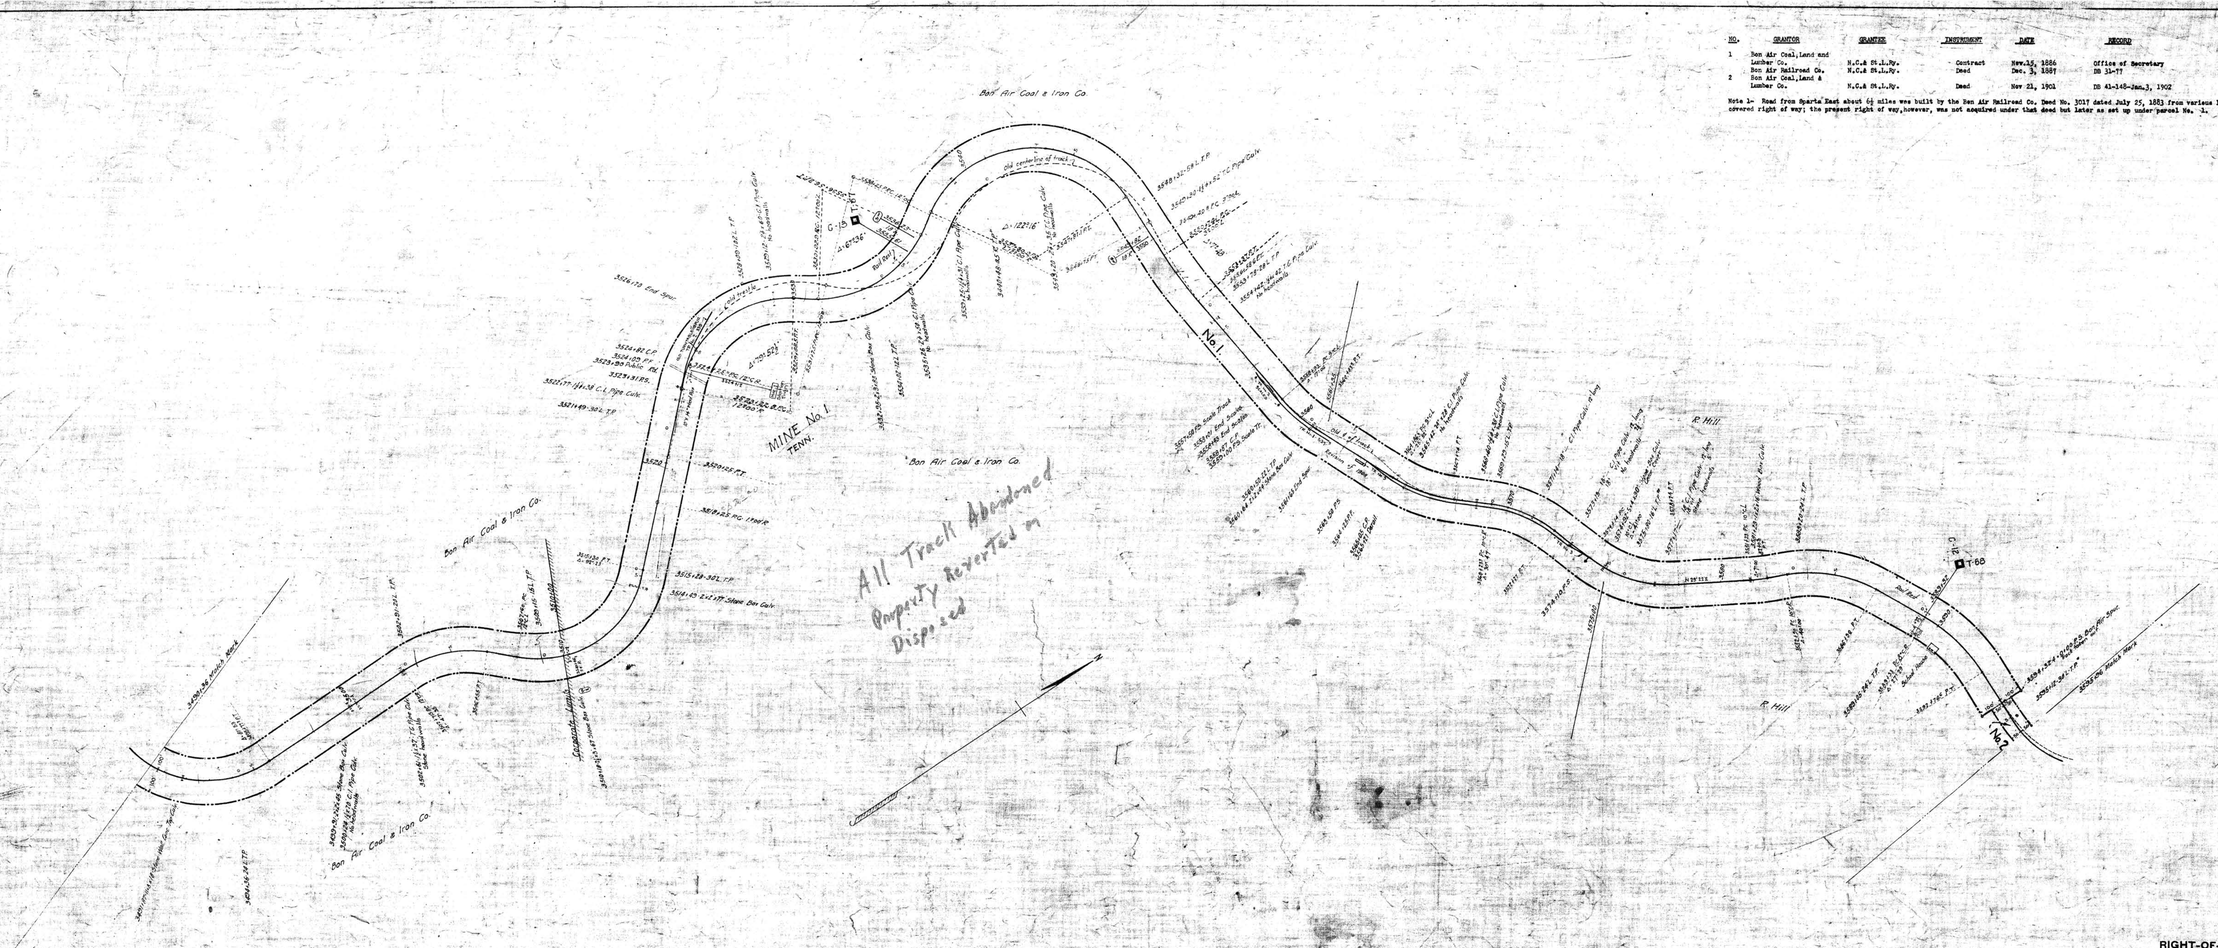

RIGHT-OF-WAY AND TRACK MAP

NASHVILLE, CHATTANOOGA AND ST. LOUIS RY.

SPARTA BRANCH

STATION 3420+36 TO STATION 3585+08

SCALE, 1 IN.-200 FT. JUNE 30, 1916

Sheet No. 34 of 44 Sheets of Sparta Branch from survey station 3420+36 to survey station 3585+08

Valuation Engineer

OFFICE OF CHIEF ENGINEER
NASHVILLE, TENN.

M.P. 66.1 to 68.1

093-011