A.F.E. No.	Date Completed	Description of Change
6848	5-22-51	Install of file change between Sta 901+63.2 & 902+61
3021		Inst. of Hy-Way Signal at 938+69 - Hole 26
11874	1-26-29	Exchange of R.Way - 173.4 - Par. 2 for 2.5 A. Par. 12 & Const.
12714	12-20-29	Inst. of Train Length Markers V.B.16.
19073	36	Renewing & Relays at 941+07, 927+73, 928+10, 923+13, and 2 at 911+56
29/22	7-22-42	Work Trk. #16, 3+43.4', Rel. 90' of Trk. 16A, & const. new T.O., 152'.
MA750	9-13-43	Moving feed house from L. to R. side 946 & 4' out @ 947+62.1
MA914	5-13-44	Const. ramp for unloading cattle - at stock pen 62+06

No.	Grantor	Grantee	Instrument	Date		Record		Cost. No.	Remarks
1	W.P.Dobson	L.&N.R.R.Co.	Deed	May 26,1911	D.B. 33	P. 292	Jun.21,1911	10104	See Note No.1
2	W.B.Dobson	"	"	May 26,1911	D.B. 33	P. 293	Jun.26,1911	10107	
3	Mrs.N.P.Warren	"	"	May 26,1911	D.B. 33	P. 318	Jun.28,1911	10168	See Note No.2. Conveys parcel #11.
4	W.P.Warren	"	"	May 26,1911	M.B. 33	P. 306	Jun.26,1911	10109	See Note No.5
5	J.O.Smith & A.H.Dobson,Trus.	"	"	May 25,1911	D.B. 33	P. 311	Jun.22,1911	10798	
6	W.L.Smith	"	"	Jun. 2,1911	D.B. 33	P. 307	Jun.21,1911	10110(1)	See Note No.3
7	Emma Smith et al	"	Condemnation	Aug. 2,1911	M.B. 2	P. 228	Aug. 2,1911	10111	
8	T.G.Slate	"	Deed	May 26,1911	D.B. 33	P. 309	Jun.21,1911	10128	See Note No.4
9	J.S.Ogilvie	"	"	May 26,1911	D.B. 33	P. 303	Jun.21,1911	10129(1)	
10	Mrs.Annie Ogilvie et al	"	Condemnation	Oct.26,1911	Min.Bk.	P. 33	Oct.26,1911	10130	
11	conveyed with parcel #3 by deed #10168.								
12	W.B.Dobson	L.&N.R.R.Co.	Deed	Jan. 24,1929	D.B. 6	P.336	Mar. 5,1929	10106	A.F.E. 11874

Notes:

#1 - N.R.Co. agrees to move barn from R/W at cost of $125.00 - Contract No.14639

#2 - Citizens of College Grove paid $245.00 of consideration for Parcel No.3

#3 - All of tract No.6 excepting a piece 150 ft. wide on the east side of, and 50 ft. on the west side of, original location conveyed to W.L.Smith May 2,1913 by Deed No.10110(2)

#4 - Middle Tennessee Traction Co.permits L.&N.Co. to cross their proposed line. N.R.Co.agrees to send half cost of an underpass if Traction Company's line is constructed three years from May 19,1913 - Contract No.14682 - Citizens of College Grove paid $191.00 of consideration for Parcel No.8

#5 - A portion of this parcel together with a portion of Parcel No.5 marked "A" and "B" respectively on the map was conveyed to E.P.Warren by Deed No.10359

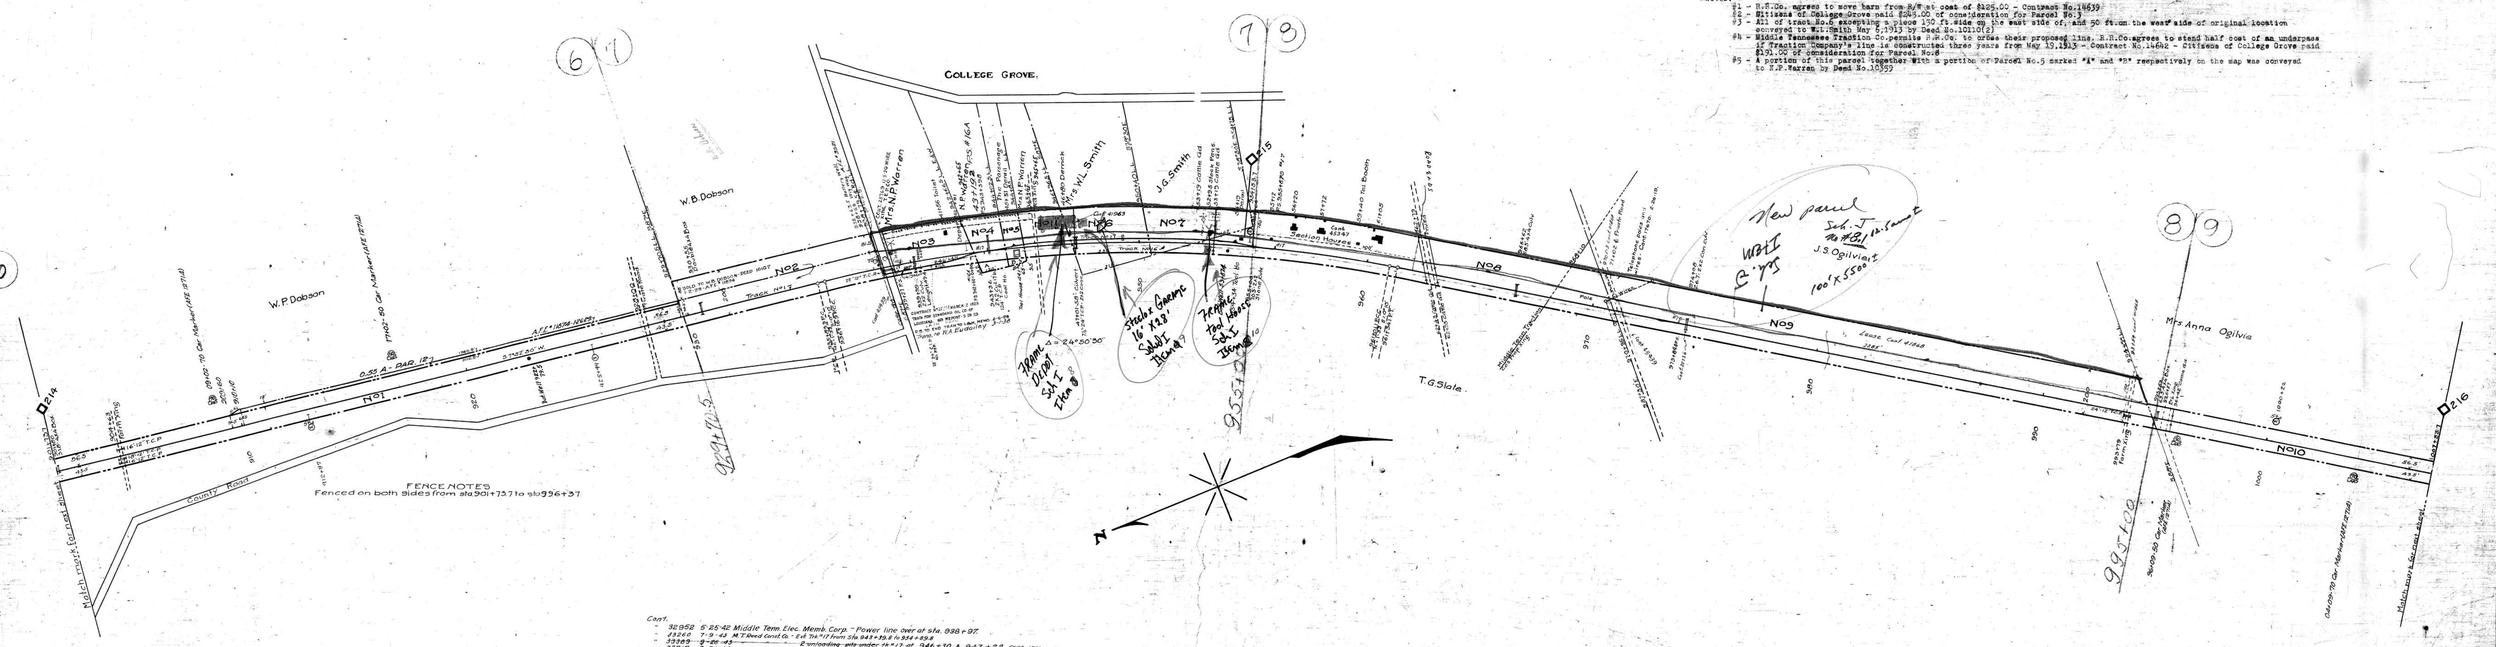

Cont.

" 32958	5-25-42	Middle Tenn. Elec. Memb. Corp. - Power line over at sta. 938+97.
" 33248	7-9-42	M.T.Rwd Cont.6 - Fill 7'x4'10' from Sta 941+33.8 to 954+23.8
" 33369	8-28-42	" " 2 unloading pts under 16+17 of 946+30 & 947+22 conc. 1941-w
" 33717	6-21-44	J.W.Hood Tel. wire over at 934+06.0
" 34638	3-25-46	Mid Tenn. Elec. Memb. Corp. Wire overhead at 976+68.7
" 34661	4-8-46	College Grove Telephone Co. Lease of land 53' left of M 946+06 to 946+56 80' wide (cancelled).
L.F.36642-B 7600-14	6-10-47	Jul.Rwd 4'x4' Gal.iron & 24" water pipe - sta 914+06
" 33808	12-4-46	The Highway Supply Co. Lease 24 ft. space in Ft. Depot. Ext. to 12-31-48 (Cancelled)
" 41648	1-4-55	J.W.Hood Lease 40'x40' at sta. 946+00
" 41663	1-5-55	R.A.Clary Lease 40'x40' at sta. 11 (Conc. 32457)
~~L.F. 43330~~	~~5-24-57~~	~~R.A.Clary lease 160'x50' at sta. 945+65 - Canc. 10-5-70~~
" 41963	5-24-57	R.A.Clary lease 160'x50' at sta. 945+65 - Canc. 10-5-70
~~" 46596~~	~~7-21-59~~	~~Lease 20' wide for Hill from sta. 942+65 to 943+65 Canc. 9-2-59~~
" 45347	5-22-59	T.H. Johnson - Lease 1.6 AC. Land Sta. 952+037
" 45439	6-25-59	Harlan Hwy. Utility District - 2" Gas Line Under Sta. 938+79.7 & 971+28.7

Sheet No.10 of 48 of Lewisburg Division from survey station 901+73.7 to survey station 1007+33.7

Valuation Engineer

RIGHT OF WAY AND TRACK MAP
LOUISVILLE AND NASHVILLE R. R. CO.
LEWISBURG DIVISION

STATION 901+73.7 TO STATION 1007+33.7

SCALE 1 INCH = 200 FT. JUNE 30 1917.

OFFICE OF ENGINEER
LOUISVILLE, KY.

V. 16
10

094-022

16-10

WILLIAMSON CO. TENN.